







01 PAVEMENT SECTION
1.03 NOT TO SCALE

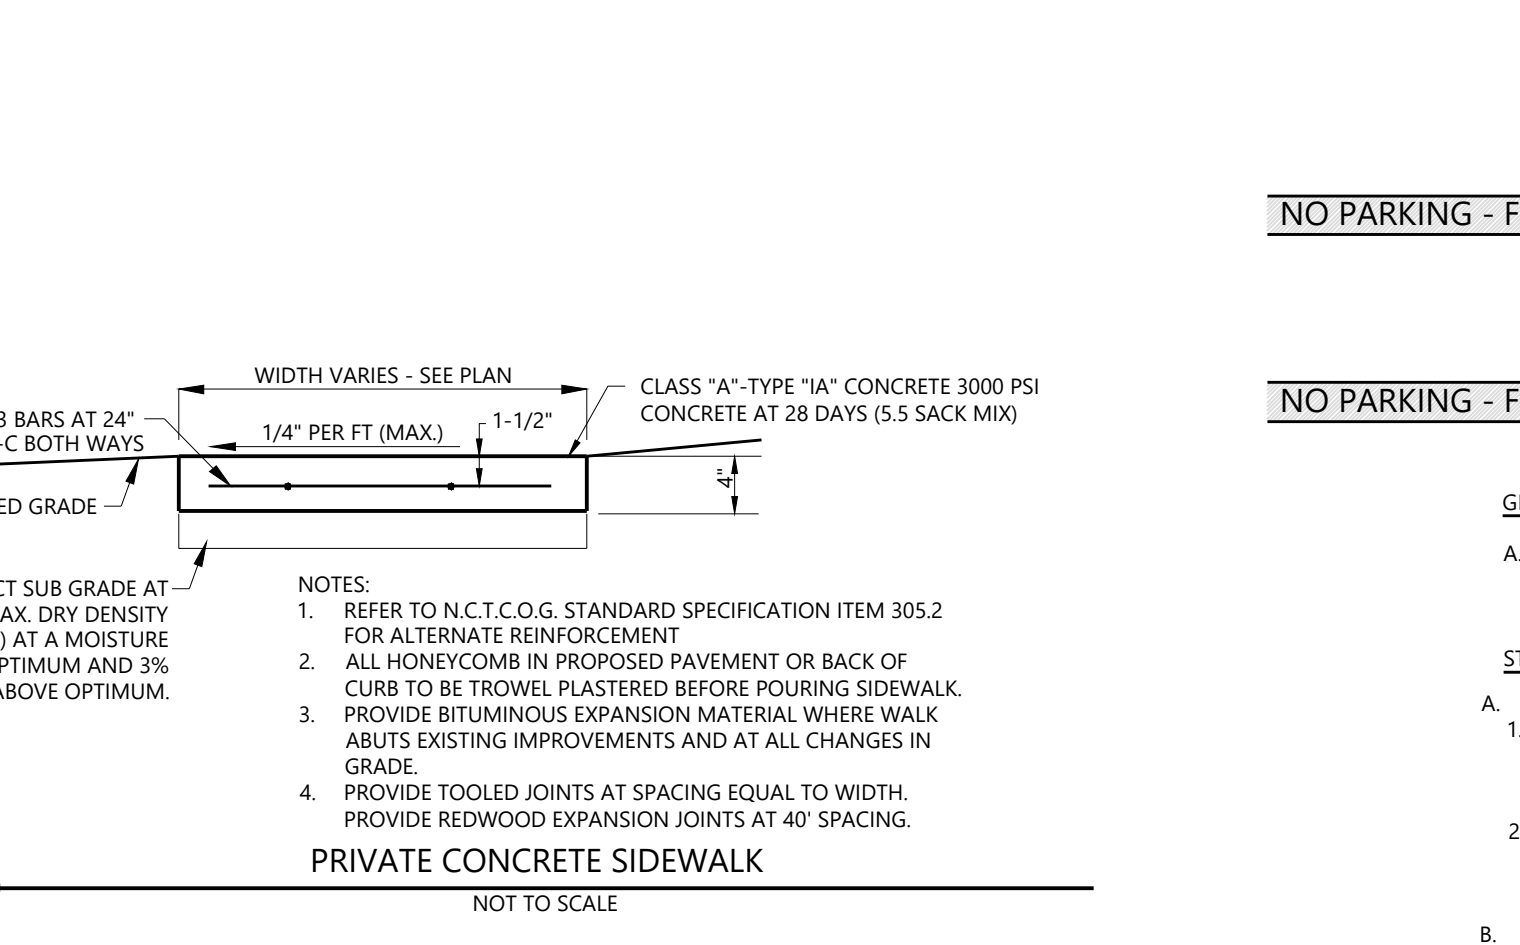

02 PRIVATE CONCRETE SIDEWALK
1.03 NOT TO SCALE

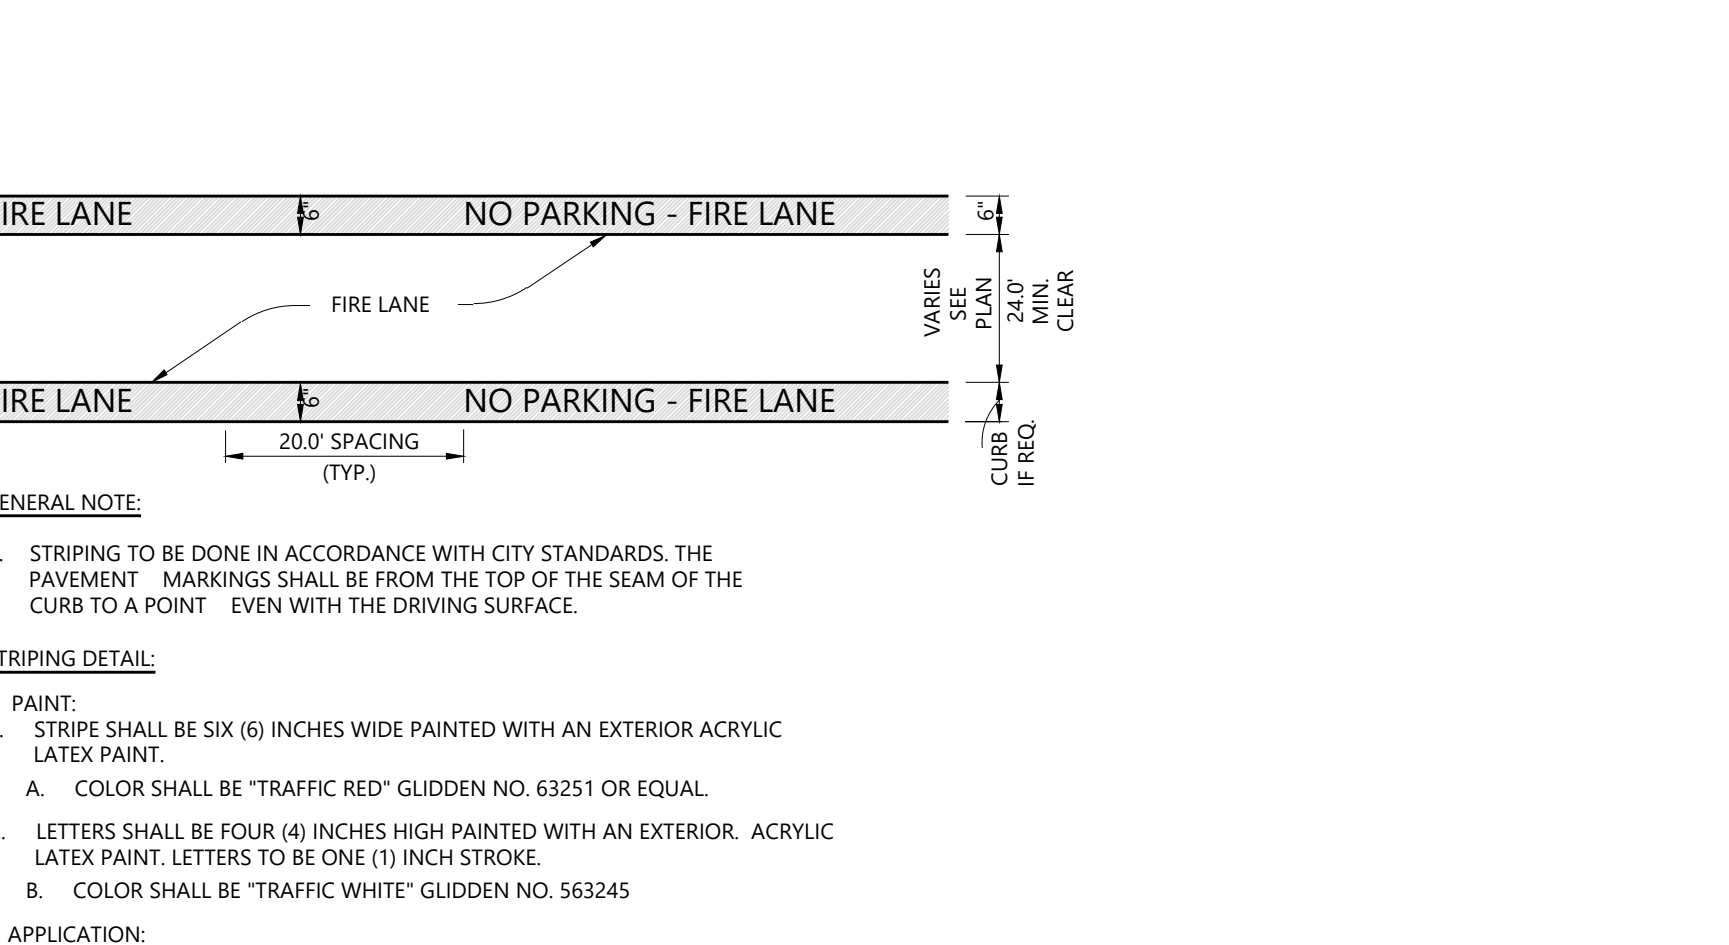

03 FIRE LANE STRIPING
1.03 NOT TO SCALE

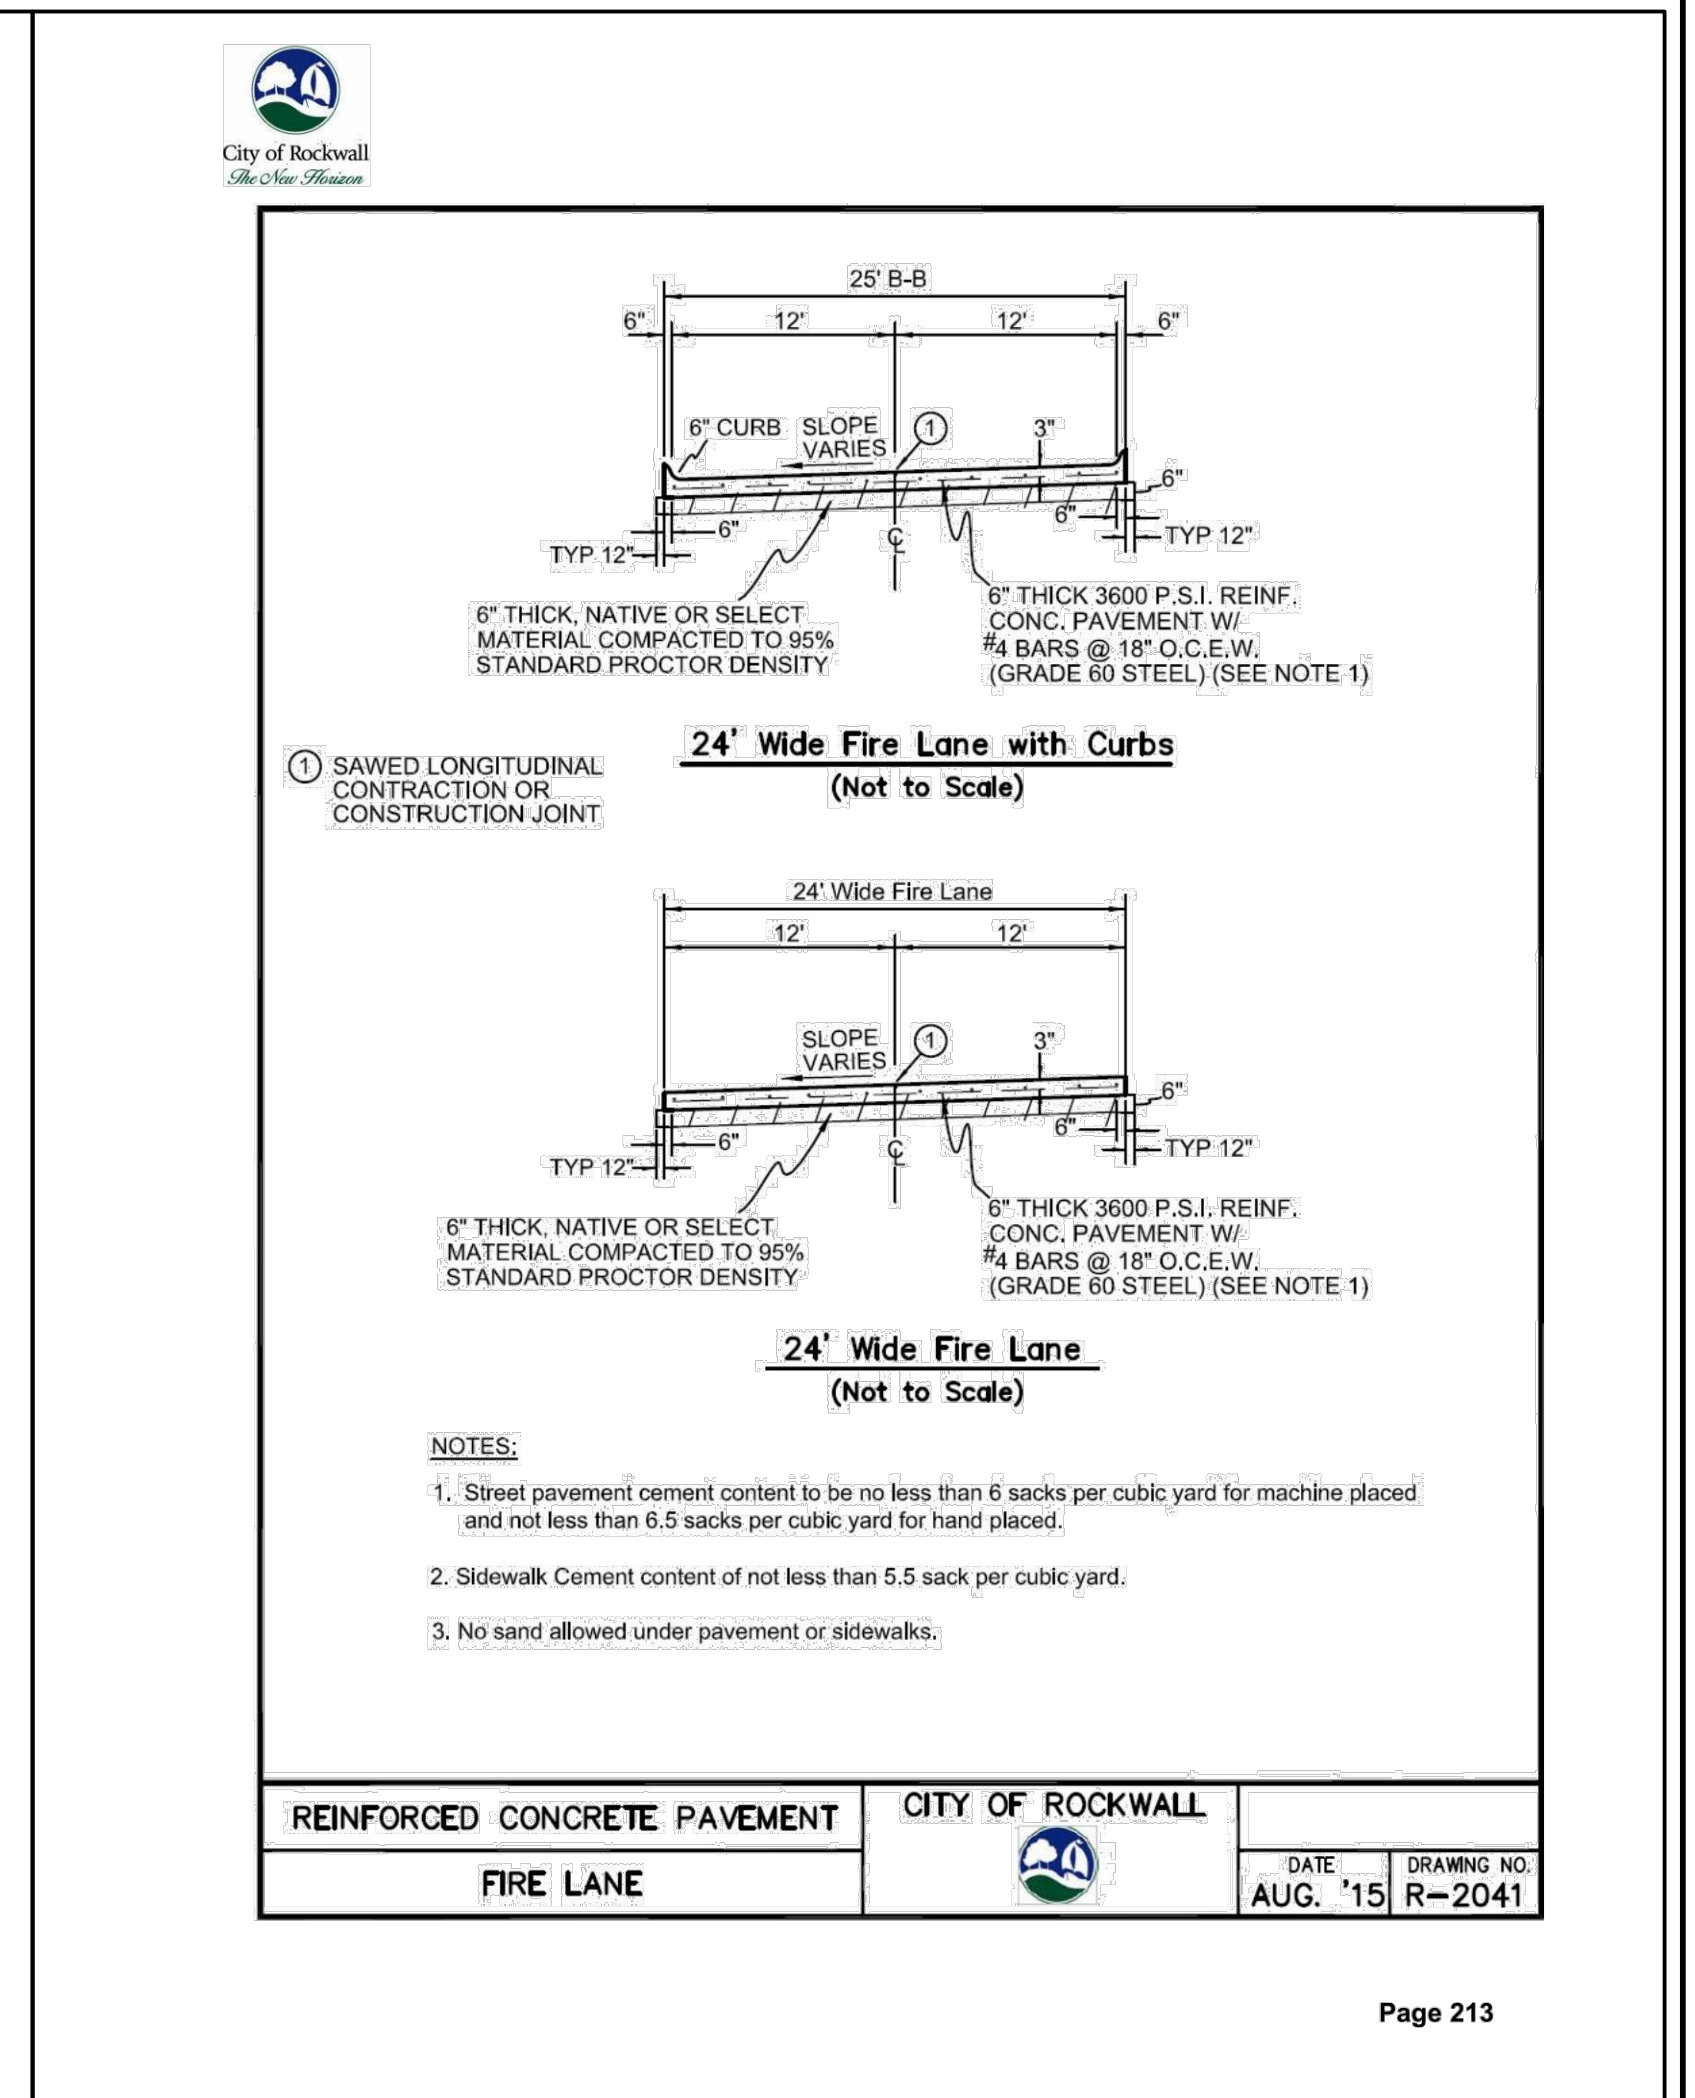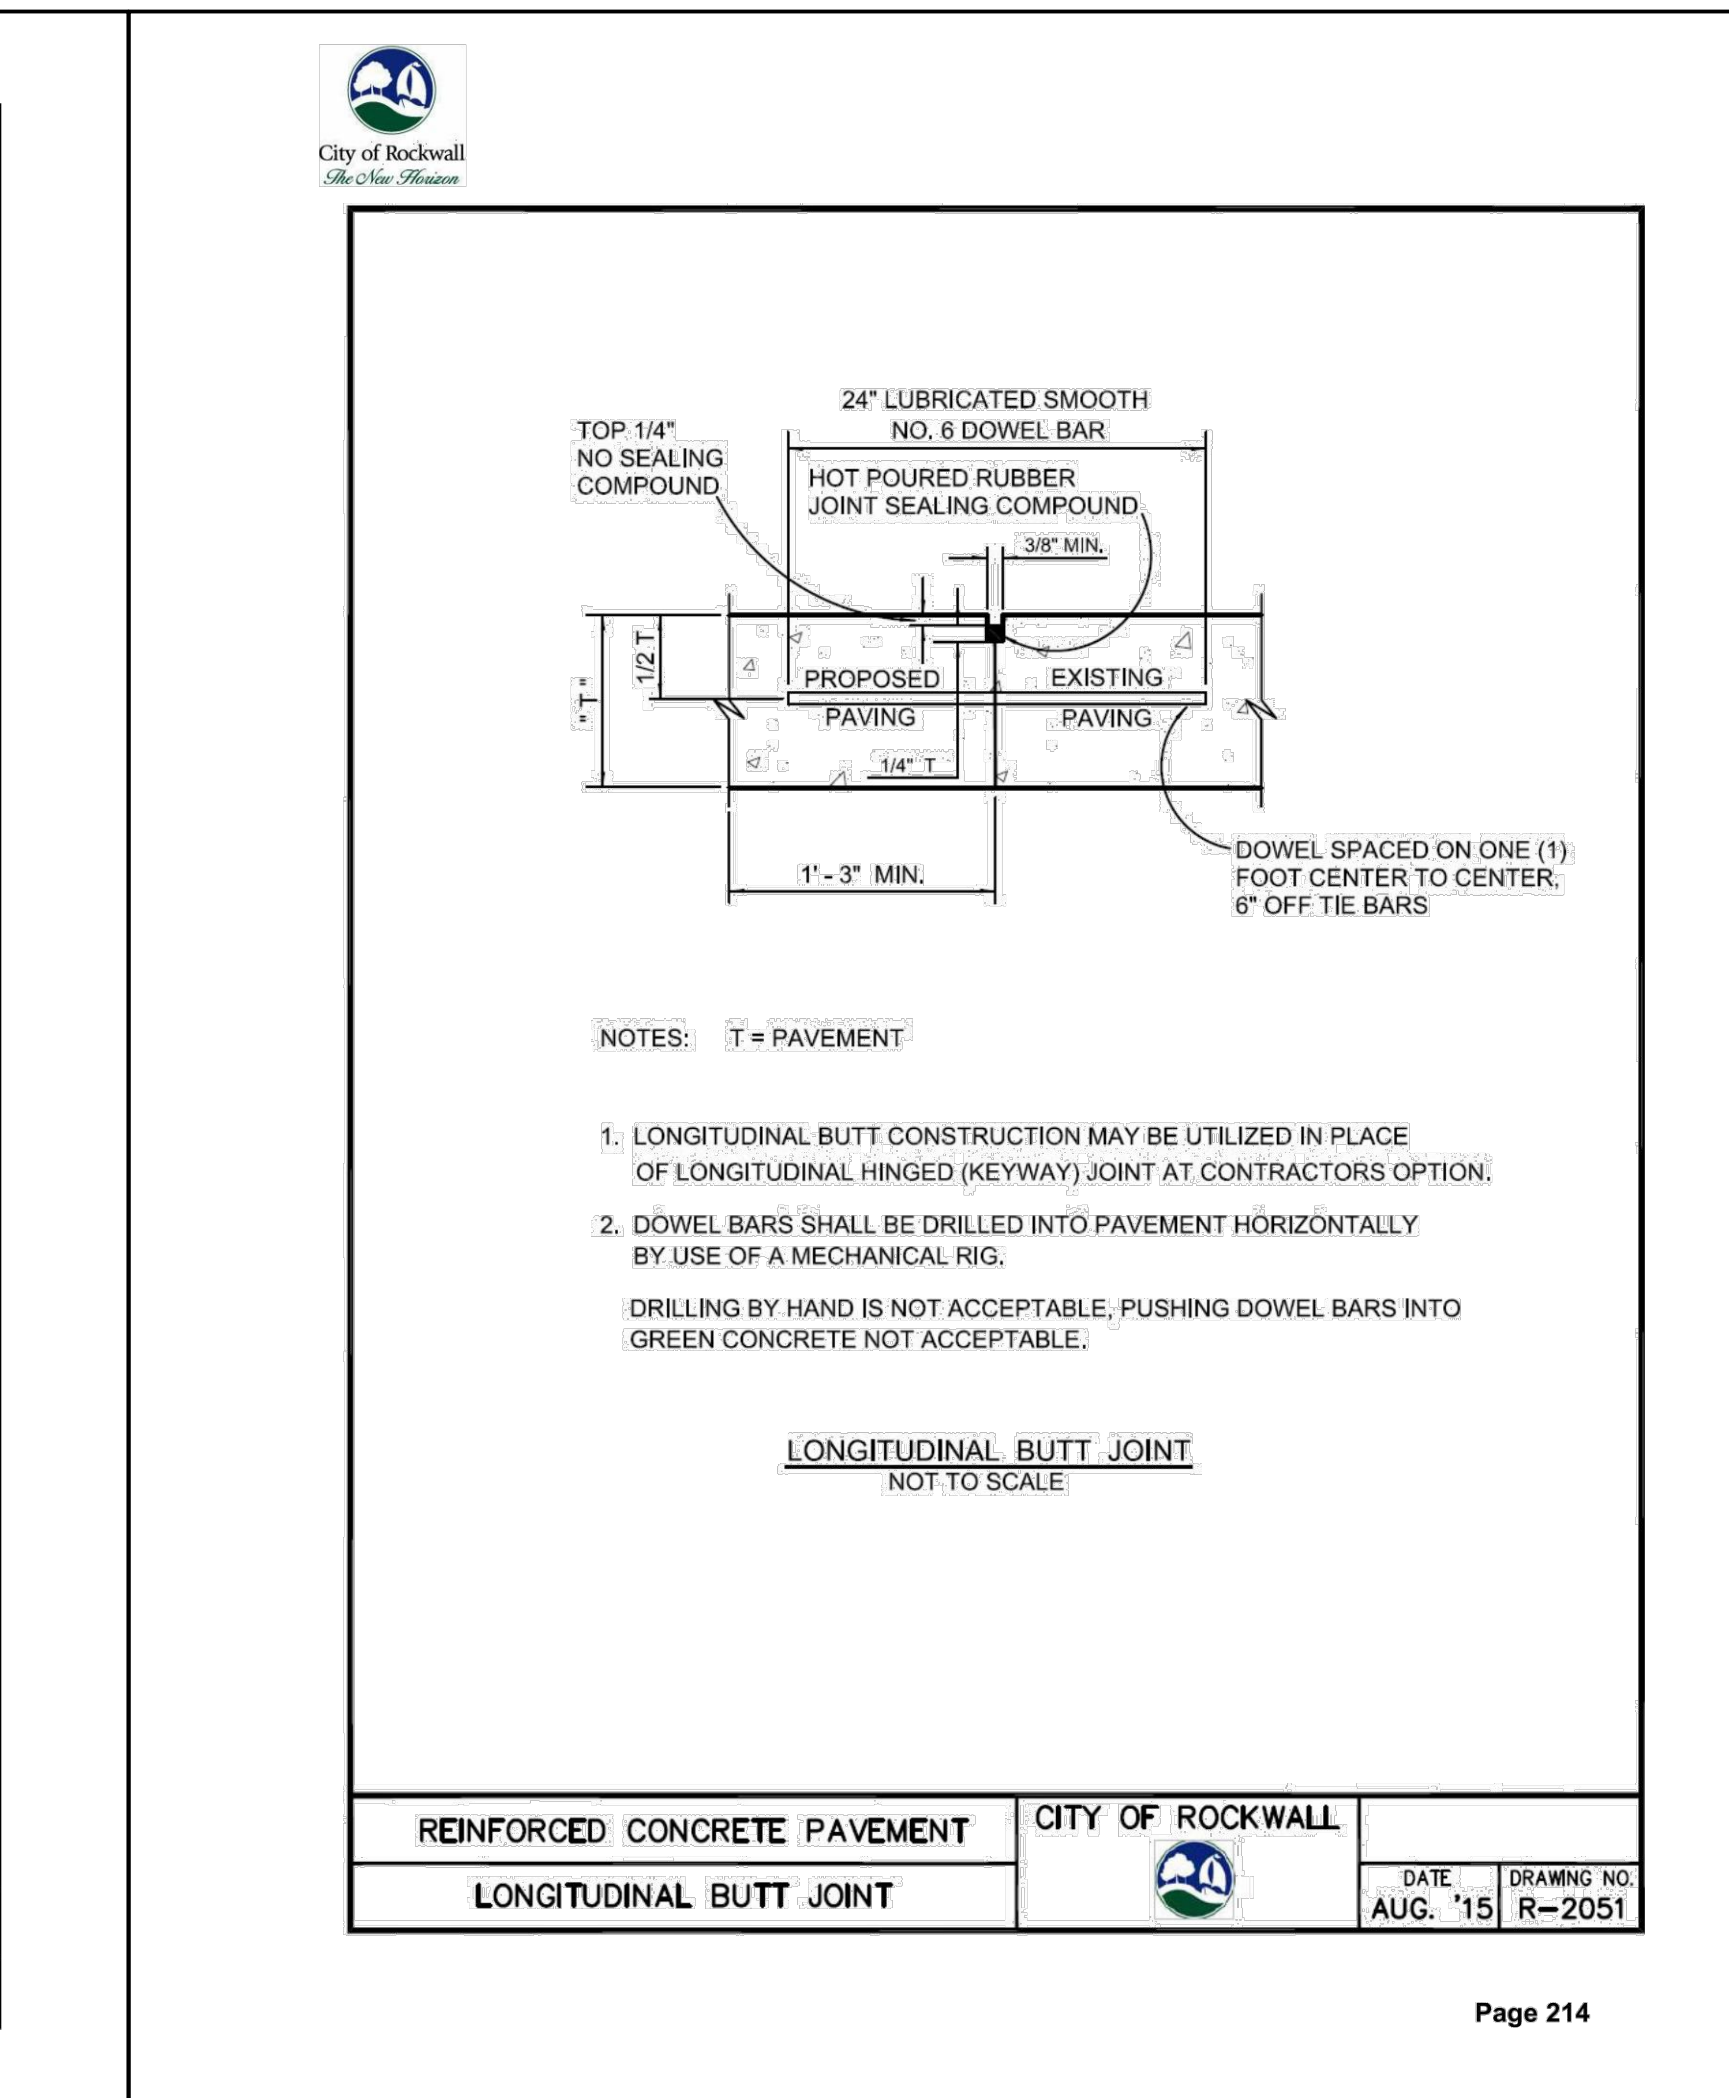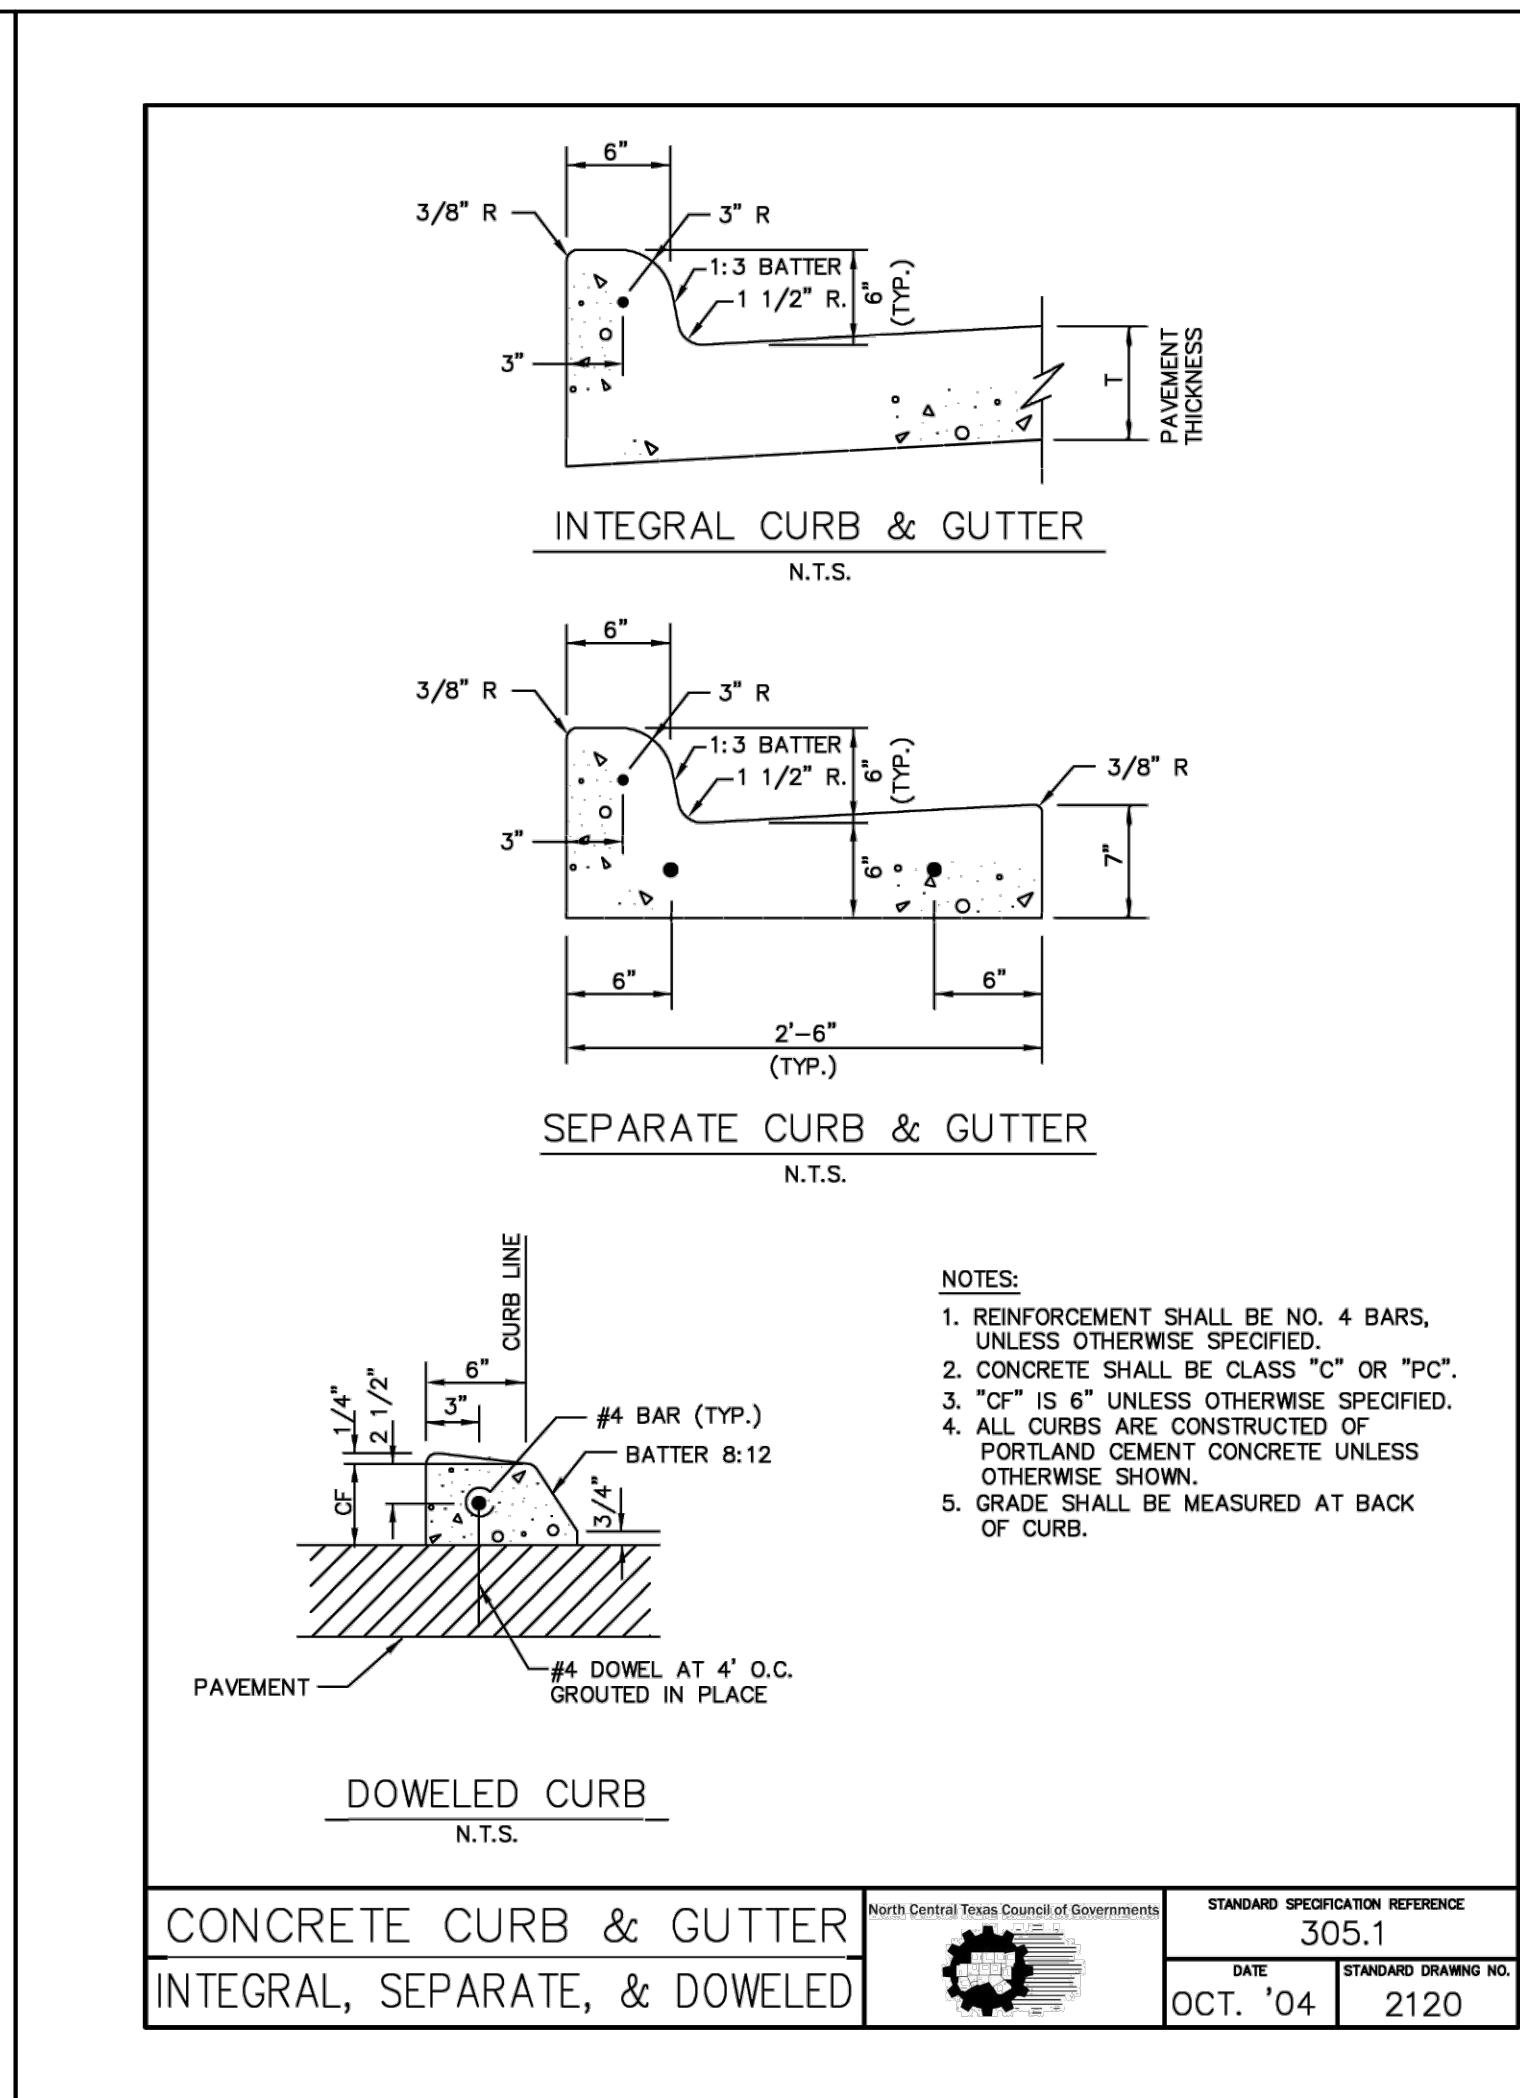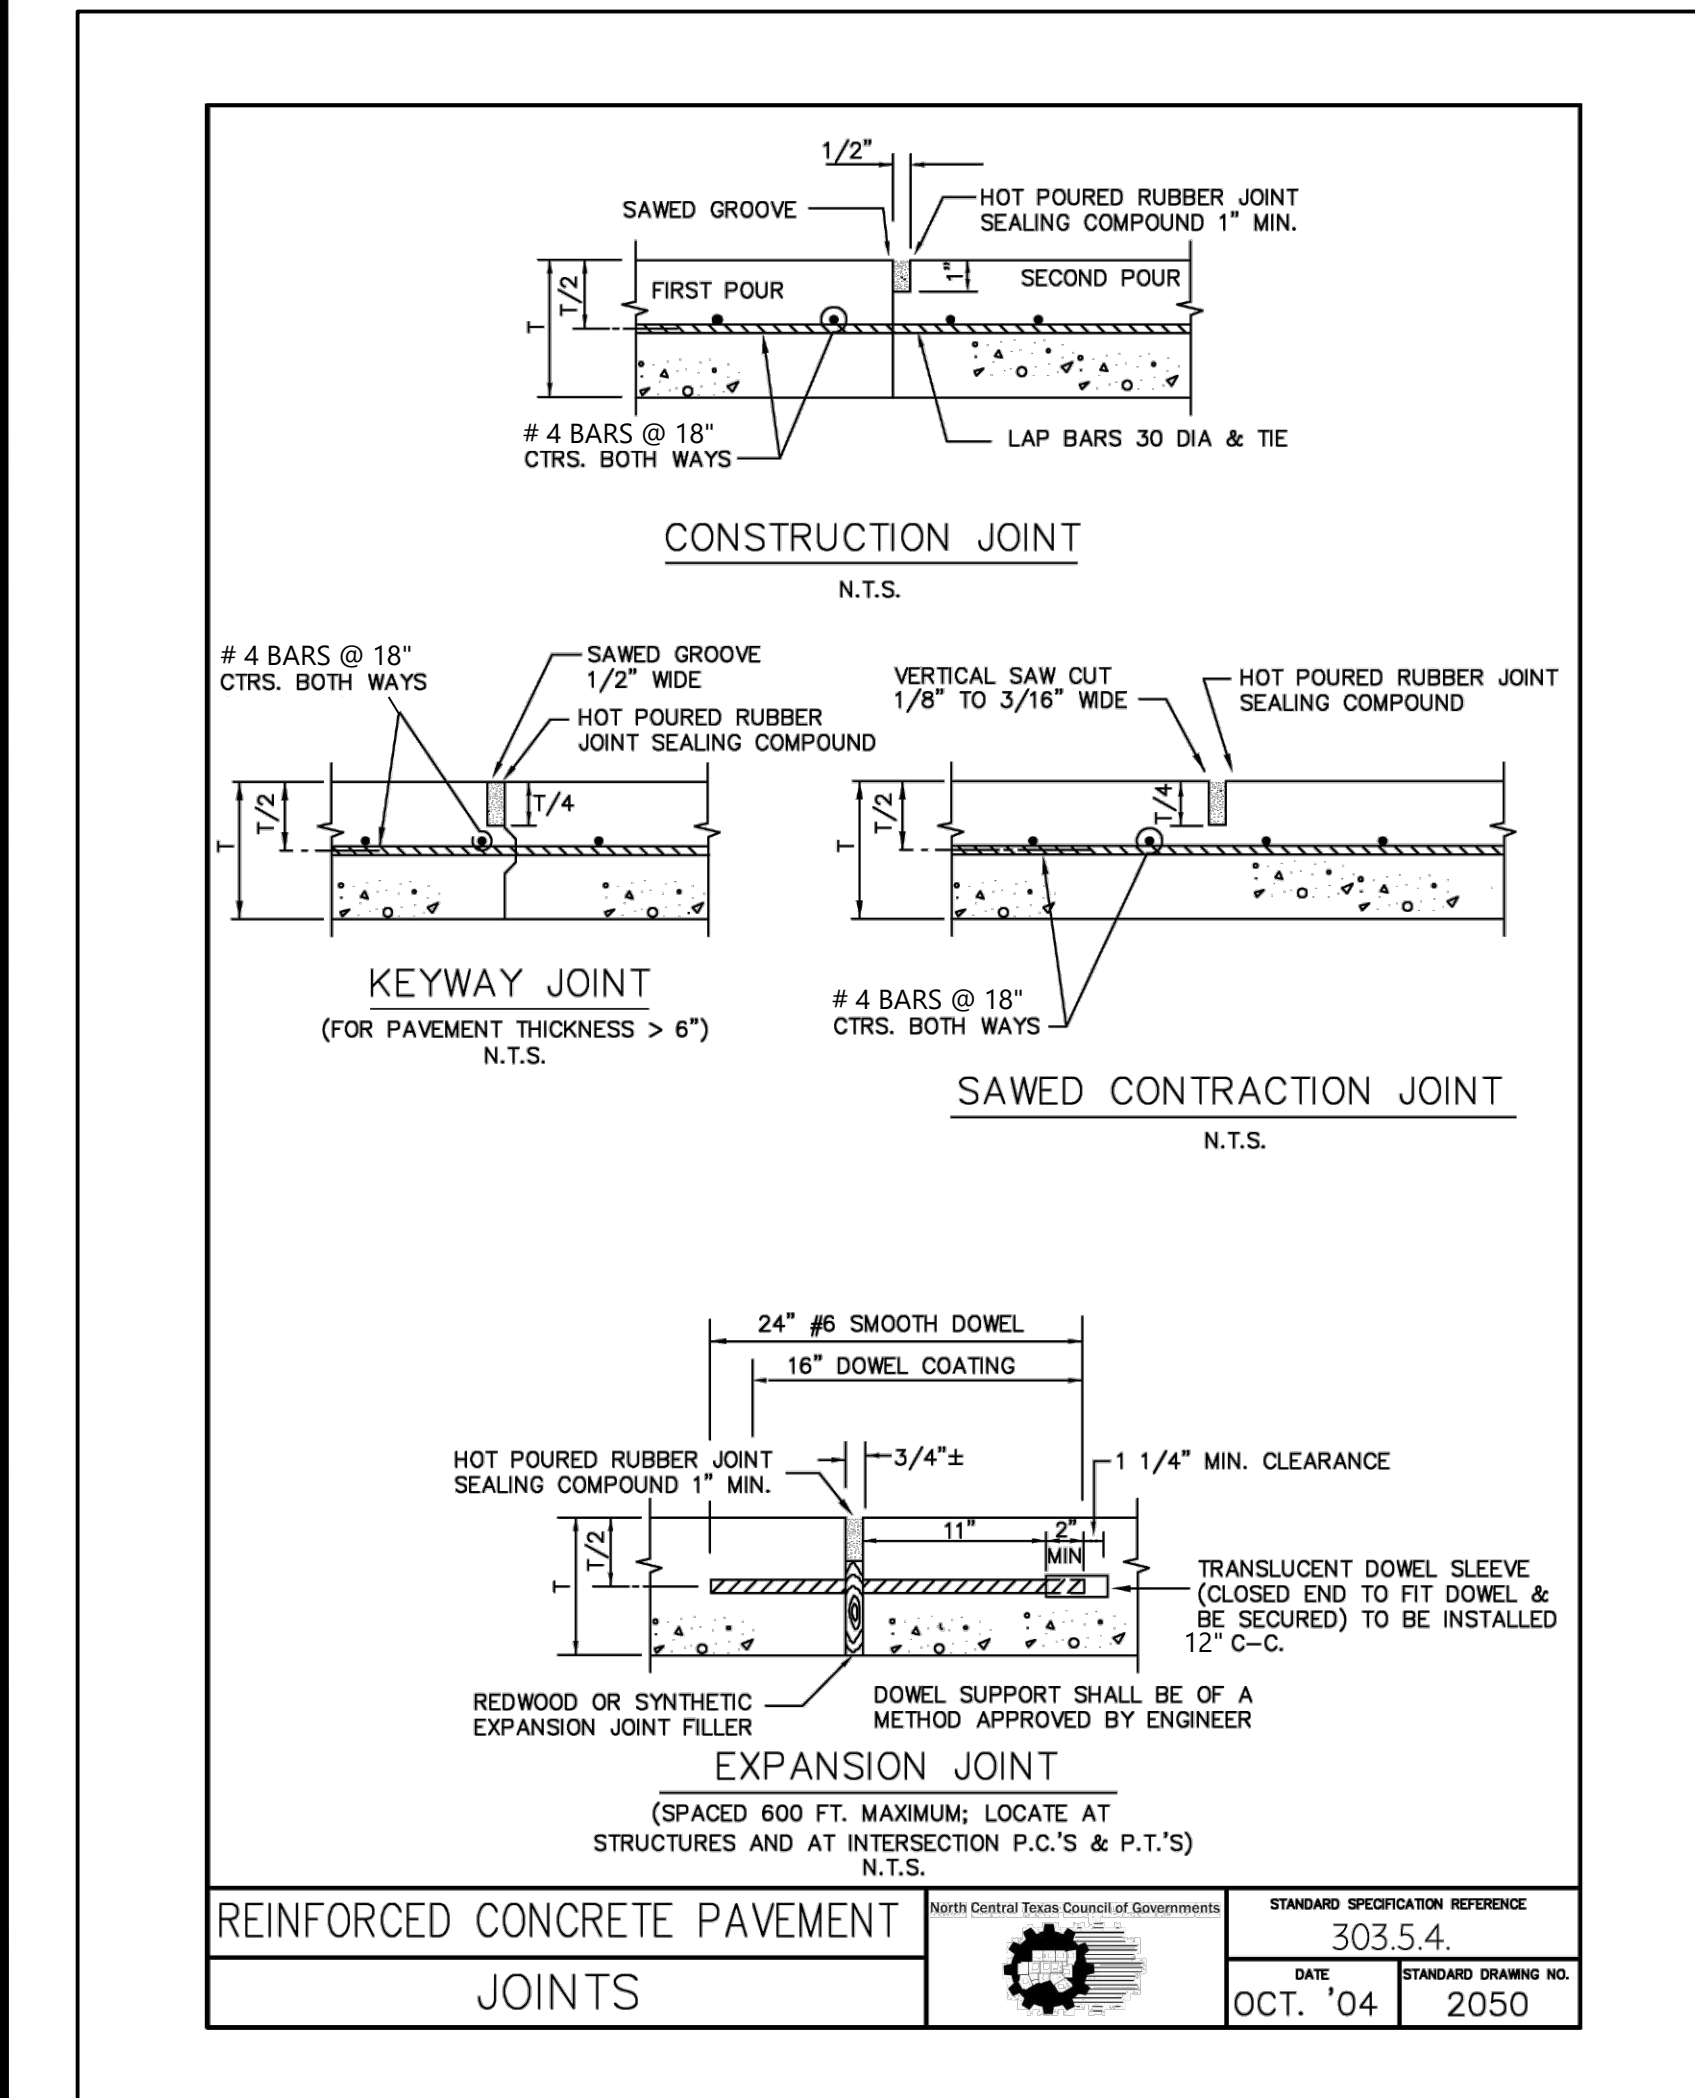

RECORD DRAWINGS:

IT WAS THE INTENT THAT THE IMPROVEMENTS SHOWN BE CONSTRUCTED ACCORDING TO THESE PLANS AS APPROVED BY THE CITY. THE LINES AND GRADES WERE SET ON THE GROUND FOR CONSTRUCTION ACCORDING TO SAID PLANS. THE CITY INSPECTED THE CONSTRUCTION. WE ARE NOT AWARE OF ANY CHANGES OR REVISIONS TO THESE PLANS DURING CONSTRUCTION OTHER THAN THOSE SHOWN. TO THE BEST OF OUR KNOWLEDGE, WESTWOOD PROFESSIONAL SERVICES, INC. HEREBY STATES THAT THIS PLANS IS AS-BUILT. THE INFORMATION PROVIDED IS BASED ON SURVEYING AT THE SITE AND INFORMATION PROVIDED BY THE CONTRACTOR. DATE: 10-09-2020

DESIGNED:	AWJ
CHECKED:	AWJ
DRAWN:	WTW
HORIZONTAL SCALE:	
VERTICAL SCALE:	

INITIAL ISSUE:	11-08-2019
REVISIONS:	
03-16-2020	SITE REVISIONS
10-09-2020	RECORD DRAWINGS

PREPARED FOR:

PROSS DESIGN GROUP, INC.

5310 HARVEST HILL ROAD, SUITE 180
DALLAS, TEXAS 75230

11-08-2019

INK ROOM & LOCKER ROOM ADDITION

ROCKWALL, TEXAS

Westwood

Phone (214) 473-4640 2740 Dallas Parkway, Suite 280
Toll Free (888) 937-5150 Plano, TX 75093
westwoodps.com

Westwood Professional Services, Inc.
TPE FIRM REGISTRATION NO. F-11756
TPELS FIRM REGISTRATION NO. 10074301

SHEET NUMBER:

1.03

DATE: 11-08-2019

0014830-01