


SOUTHERN PACIFIC RAIL ROAD
(100' R.O.W.)

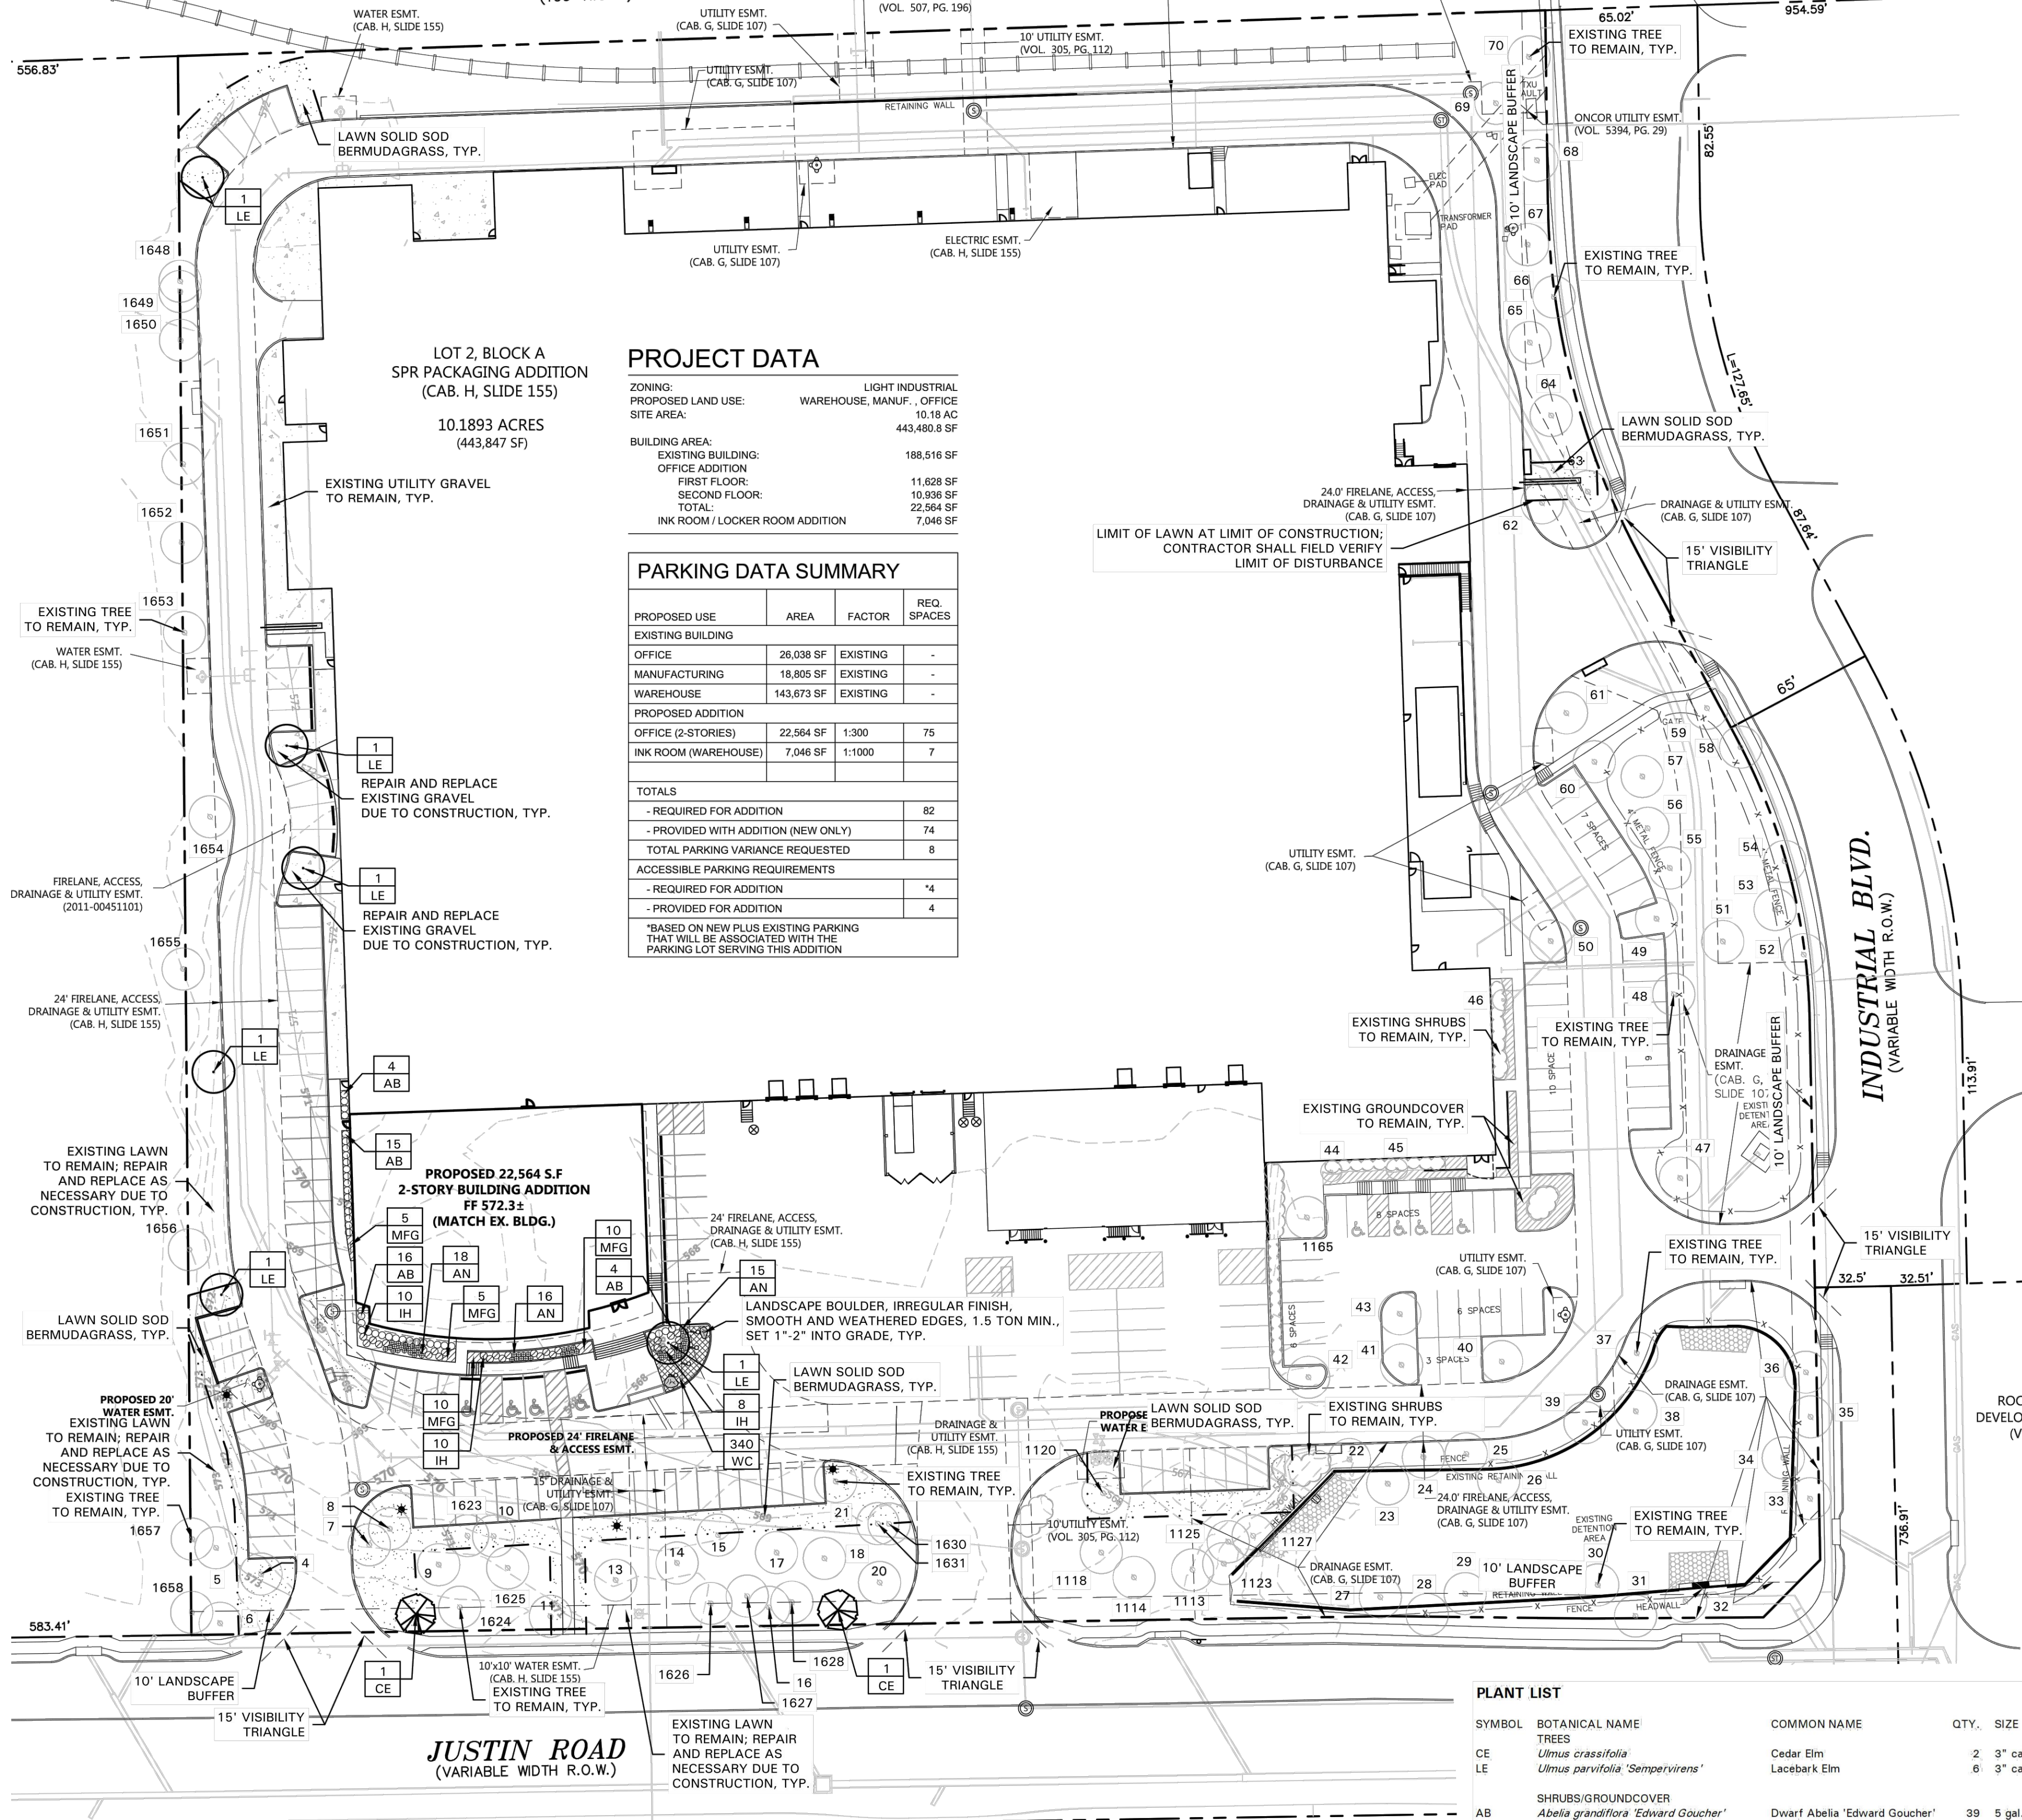

PROJECT DATA

ZONING:	LIGHT INDUSTRIAL
PROPOSED LAND USE:	WAREHOUSE, MANUF., OFFICE
SITE AREA:	10.18 AC
	443,480.8 SF
BUILDING AREA:	188,516 SF
EXISTING BUILDING:	
OFFICE ADDITION:	11,628 SF
FIRST FLOOR:	10,936 SF
SECOND FLOOR:	22,564 SF
TOTAL:	22,564 SF
INK ROOM / LOCKER ROOM ADDITION:	7,046 SF

PARKING DATA SUMMARY

PROPOSED USE	AREA	FACTOR	REQ. SPACES
EXISTING BUILDING			
OFFICE	26,036 SF	EXISTING	-
MANUFACTURING	18,805 SF	EXISTING	-
WAREHOUSE	143,673 SF	EXISTING	-
PROPOSED ADDITION			
OFFICE (2-STORIES)	22,564 SF	1:300	75
INK ROOM (WAREHOUSE)	7,046 SF	1:1000	7
TOTALS			
- REQUIRED FOR ADDITION			82
- PROVIDED WITH ADDITION (NEW ONLY)			74
TOTAL PARKING VARIANCE REQUESTED			8
ACCESSIBLE PARKING REQUIREMENTS			
- REQUIRED FOR ADDITION			*4
- PROVIDED FOR ADDITION			4

*BASED ON NEW PLUS EXISTING PARKING THAT WILL BE ASSOCIATED WITH THE PARKING LOT SERVING THIS ADDITION

LANDSCAPE NOTES

- CONTRACTOR SHALL VERIFY ALL EXISTING AND PROPOSED SITE ELEMENTS AND NOTIFY LANDSCAPE ARCHITECT OF ANY DISCREPANCIES. SURVEY DATA OF EXISTING CONDITIONS WAS SUPPLIED BY OTHERS.
- CONTRACTOR SHALL LOCATE ALL EXISTING UNDERGROUND UTILITIES AND NOTIFY LANDSCAPE ARCHITECT OF ANY CONFLICTS. CONTRACTOR SHALL EXERCISE CAUTION WHEN WORKING IN THE VICINITY OF UNDERGROUND UTILITIES.
- CONTRACTOR SHALL PROVIDE A MINIMUM 2% SLOPE AWAY FROM ALL STRUCTURES.
- CONTRACTOR SHALL FINE GRADE AREAS TO ACHIEVE FINAL CONTOURS AS INDICATED. LEAVE AREAS TO RECEIVE TOPSOIL 3" BELOW FINAL FINISHED GRADE IN PLANTING AREAS AND 1" BELOW FINAL FINISHED GRADE IN LAWN AREAS.
- ALL PLANTING BEDS AND LAWN AREAS SHALL BE SEPARATED BY STEEL EDGING. NO STEEL EDGING SHALL BE INSTALLED ADJACENT TO BUILDINGS, WALKS, OR CURBS. CUT STEEL EDGING AT 45 DEGREE ANGLE WHERE IT INTERSECTS WALKS AND CURBS.
- TOP OF MULCH SHALL BE 1/2" MINIMUM BELOW THE TOP OF WALKS AND CURBS.
- ALL LAWN AREAS SHALL BE SOLID SOD BERMUDAGRASS, UNLESS OTHERWISE NOTED ON THE DRAWINGS.
- ALL REQUIRED LANDSCAPE AREAS SHALL BE PROVIDED WITH AN AUTOMATIC UNDERGROUND IRRIGATION SYSTEM WITH RAIN AND FREEZE SENSORS AND EVAPOTRANSPIRATION (ET) WEATHER-BASED CONTROLLERS AND SAID IRRIGATION SYSTEM SHALL BE DESIGNED BY A QUALIFIED PROFESSIONAL AND INSTALLED BY A LICENSED IRRIGATOR.
- CONTRACTOR SHALL PROVIDE BID PROPOSAL LISTING UNIT PRICES FOR ALL MATERIAL PROVIDED.
- CONTRACTOR SHALL BE RESPONSIBLE FOR OBTAINING ALL REQUIRED LANDSCAPE AND IRRIGATION PERMITS.

MAINTENANCE NOTES

- THE OWNER, TENANT AND THEIR AGENT, IF ANY, SHALL BE JOINTLY AND SEVERALLY RESPONSIBLE FOR THE MAINTENANCE OF ALL LANDSCAPE.
- ALL LANDSCAPE SHALL BE MAINTAINED IN A NEAT AND ORDERLY MANNER AT ALL TIMES. THIS SHALL INCLUDE MOWING, EDGING, PRUNING, FERTILIZING, WATERING, WEEDING AND OTHER SUCH ACTIVITIES COMMON TO LANDSCAPE MAINTENANCE.
- ALL LANDSCAPE AREAS SHALL BE KEPT FREE OF TRASH, LITTER, WEEDS AND OTHER SUCH MATERIAL OR PLANTS NOT PART OF THIS PLAN.
- ALL PLANT MATERIAL SHALL BE MAINTAINED IN A HEALTHY AND GROWING CONDITION AS IS APPROPRIATE FOR THE SEASON OF THE YEAR.
- ALL PLANT MATERIAL WHICH DIES SHALL BE REPLACED WITH PLANT MATERIAL OF EQUAL OR BETTER VALUE.
- CONTRACTOR SHALL PROVIDE SEPARATE BID PROPOSAL FOR ONE YEAR'S MAINTENANCE TO BEGIN AFTER FINAL ACCEPTANCE.

CITY OF ROCKWALL NOTES

- NO TREES WITHIN 5'-0" OF ANY UTILITIES
- IRRIGATION SYSTEM WILL MEET REQUIREMENTS IN THE UDC

GENERAL LAWN NOTES

- CONTRACTOR SHALL COORDINATE OPERATIONS AND AVAILABILITY OF EXISTING TOPSOIL WITH ON-SITE CONSTRUCTION MANAGER.
- CONTRACTOR SHALL LEAVE LAWN AREAS 1" BELOW FINAL FINISHED GRADE PRIOR TO TOPSOIL INSTALLATION.
- CONTRACTOR SHALL FINE GRADE AREAS TO ACHIEVE FINAL CONTOURS AS INDICATED ON CIVIL PLANS. ADJUST CONTOURS TO ACHIEVE POSITIVE DRAINAGE AWAY FROM BUILDINGS. PROVIDE UNIFORM ROUNDING AT TOP AND BOTTOM OF SLOPES AND OTHER BREAKS IN GRADE. CORRECT IRREGULARITIES AND AREAS WHERE WATER MAY STAND.
- ALL LAWN AREAS SHALL BE FINE GRADED, IRRIGATION TRENCHES COMPLETELY SETTLED AND FINISH GRADE APPROVED BY THE OWNER'S CONSTRUCTION MANAGER OR LANDSCAPE ARCHITECT PRIOR TO LAWN INSTALLATION.
- CONTRACTOR SHALL REMOVE ALL ROCKS 3/4" DIAMETER AND LARGER, DIRT CLOUDS, STICKS, CONCRETE SPOOLS, ETC. PRIOR TO PLACING TOPSOIL AND LAWN INSTALLATION.
- CONTRACTOR SHALL MAINTAIN ALL LAWN AREAS UNTIL FINAL ACCEPTANCE. THIS SHALL INCLUDE, BUT NOT BE LIMITED TO: MOWING, WATERING, WEEDING, CULTIVATING, CLEANING AND REPLACING DEAD OR BARE AREAS TO KEEP PLANTS IN A VIGOROUS, HEALTHY CONDITION.
- CONTRACTOR SHALL GUARANTEE ESTABLISHMENT OF ACCEPTABLE TURF AREA AND SHALL PROVIDE REPLACEMENT FROM LOCAL SUPPLY IF NECESSARY.

SOLID SOD NOTES

- PLANT SOD BY HAND TO COVER INDICATED AREAS COMPLETELY. ENSURE EDGES OF SOD ARE TOUCHING. TOP DRESS JOINTS BY HAND WITH TOPSOIL TO FILL VOIDS.
- ROLL GRASS AREAS TO ACHIEVE A SMOOTH, EVEN SURFACE, FREE FROM UNNATURAL UNDULATIONS.
- WATER SOD THOROUGHLY AS SOD OPERATION PROGRESSES.
- IF INSTALLATION OCCURS BETWEEN SEPTEMBER 1 AND MARCH 1, OVER-SEED BERMUDAGRASS SOD WITH WINTER RYEGRASS, AT A RATE OF FOUR (4) POUNDS PER ONE THOUSAND (1000) SQUARE FEET.

LANDSCAPE TABULATIONS
THE CITY OF ROCKWALL, TEXAS

STREET LANDSCAPING

- 10' wide landscape buffer with one tree per 50 l.f.

INDUSTRIAL BLVD.: 684 l.f.
Required (14) trees, 3" cal. Provided (14) existing trees, 4" cal. +

JUSTIN RD.: 671 l.f.
Required (14) trees, 3" cal. Provided (2) trees, 3" cal. (12) existing trees, 4" cal. +

PARKING LOT LANDSCAPING

- 5% of the interior parking lot shall be landscape.
- One (1) tree for every ten (10) parking spaces.
- All parking spaces shall be a minimum eighty (80) feet from a tree.

Total interior parking lot area: 47,792 s.f.
Total parking spaces: 125 spaces

Required 2,340 s.f. (5%) (13) trees
Provided 7,611 s.f. (16%) (6) trees, 3" cal. (11) existing trees

SITE LANDSCAPING

- 10% of the total site shall be landscaped for LIGHT INDUSTRIAL.
- 100% of the total requirements shall be located in the front of and along side buildings for LIGHT INDUSTRIAL.

Total site: 10.18 AC; 443,480 s.f.

Required 44,348 s.f. (10%)
Provided 109,932 s.f. (25%)
44,348 s.f. (100%) 76,460 s.f.

DETENTION BASIN REQUIREMENTS

- A minimum of one (1) tree for every 750 s.f. of dry land area.

Dry Land Area: 26,232 s.f.
Required (35) trees
Provided (35) existing trees

PLANT LIST

SYMBOL	BOTANICAL NAME	COMMON NAME	QTY.	SIZE	REMARKS
CE	TREES				
LE	<i>Ulmus crassifolia</i>	Cedar Elm	2	3" cal.	container grown, 12' ht., 4' spread, 4' branching ht., matching
LE	<i>Ulmus parvifolia 'Sempervirens'</i>	Lacebark Elm	6	3" cal.	container grown, 12' ht., 4' spread, 4' branching ht., matching
AB	SHRUBS/GROUNDCOVER				
AB	<i>Abelia grandiflora 'Edward Goucher'</i>	Dwarf Abelia 'Edward Goucher'	39	5 gal.	container full, 24" spread, 36" o.c.
AN	<i>Juniperus tobinia 'Andorra'</i>	Andorra Juniper	49	5 gal.	container full, 20" spread, 24" o.c.
IH	<i>Rhynchospora indica 'Clara'</i>	Indian Hawthorne 'Clara'	28	5 gal.	container full, 20" spread, 36" o.c.
MFG	<i>Nassella tenuissima</i>	Mexican Feathergrass	30	1 gal.	container full, 24" o.c.
WC	<i>Euonymus fortunei 'Coloratus'</i>	Wintercreeper	340	4" pots	container (3) 12" runners min., 12" o.c.
WC	<i>Cynodon dactylon</i>	Common Bermudagrass			solid sod, refer to Solid Sod Notes


NOTE: ALL TREES SHALL HAVE STRAIGHT TRUNKS AND BE MATCHING WITHIN VARIETIES. PLANT LIST IS AN AID TO BIDDERS ONLY. CONTRACTOR SHALL VERIFY ALL QUANTITIES ON PLAN. ALL HEIGHTS AND SPREADS ARE MINIMUMS. ALL PLANT MATERIAL SHALL MEET OR EXCEED REMARKS AS INDICATED.

OWNER:
ALVAPLAST US, INC. / SPR PACKAGING
CONTACT: CAROLINA MOLINA
1480 JUSTIN ROAD
ROCKWALL, TX 75087
469-402-1232

CASE NO: SP2019-030
ARCHITECT:
PROSS DESIGN GROUP, INC.
CONTACT: BOBBY PROSS
5310 HARVEST HILL RD., SUITE 180
DALLAS, TX 75230
972-759-1400

LANDSCAPE PLAN

- 4245 North Central Expy
- Suite 501
- Dallas, Texas 75205
- 214.865.7192 office

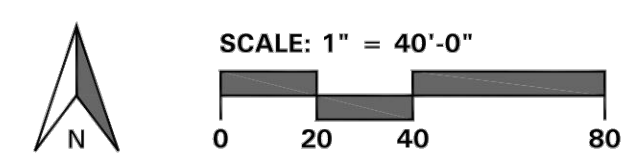

Drawn:
NAY
Checked:
KAT
Date:
08/14/19

#	DATE	DESCRIPTION



09/27/19

ross design group, incorporated
5010 Harvest Hill Road, Suite 180, Dallas, Texas 75230-9727
972-759-1400

SPR PACKAGING
OFFICE ADDITION
1480 JUSTIN RD., ROCKWALL, TEXAS

job no
1854
sheet
L2.01