


© 2019 Westwood Professional Services, Inc.

N:\00148302\1 PROJECT DATA\DWG\CIVIL\0014830-02-4-EC.DWG

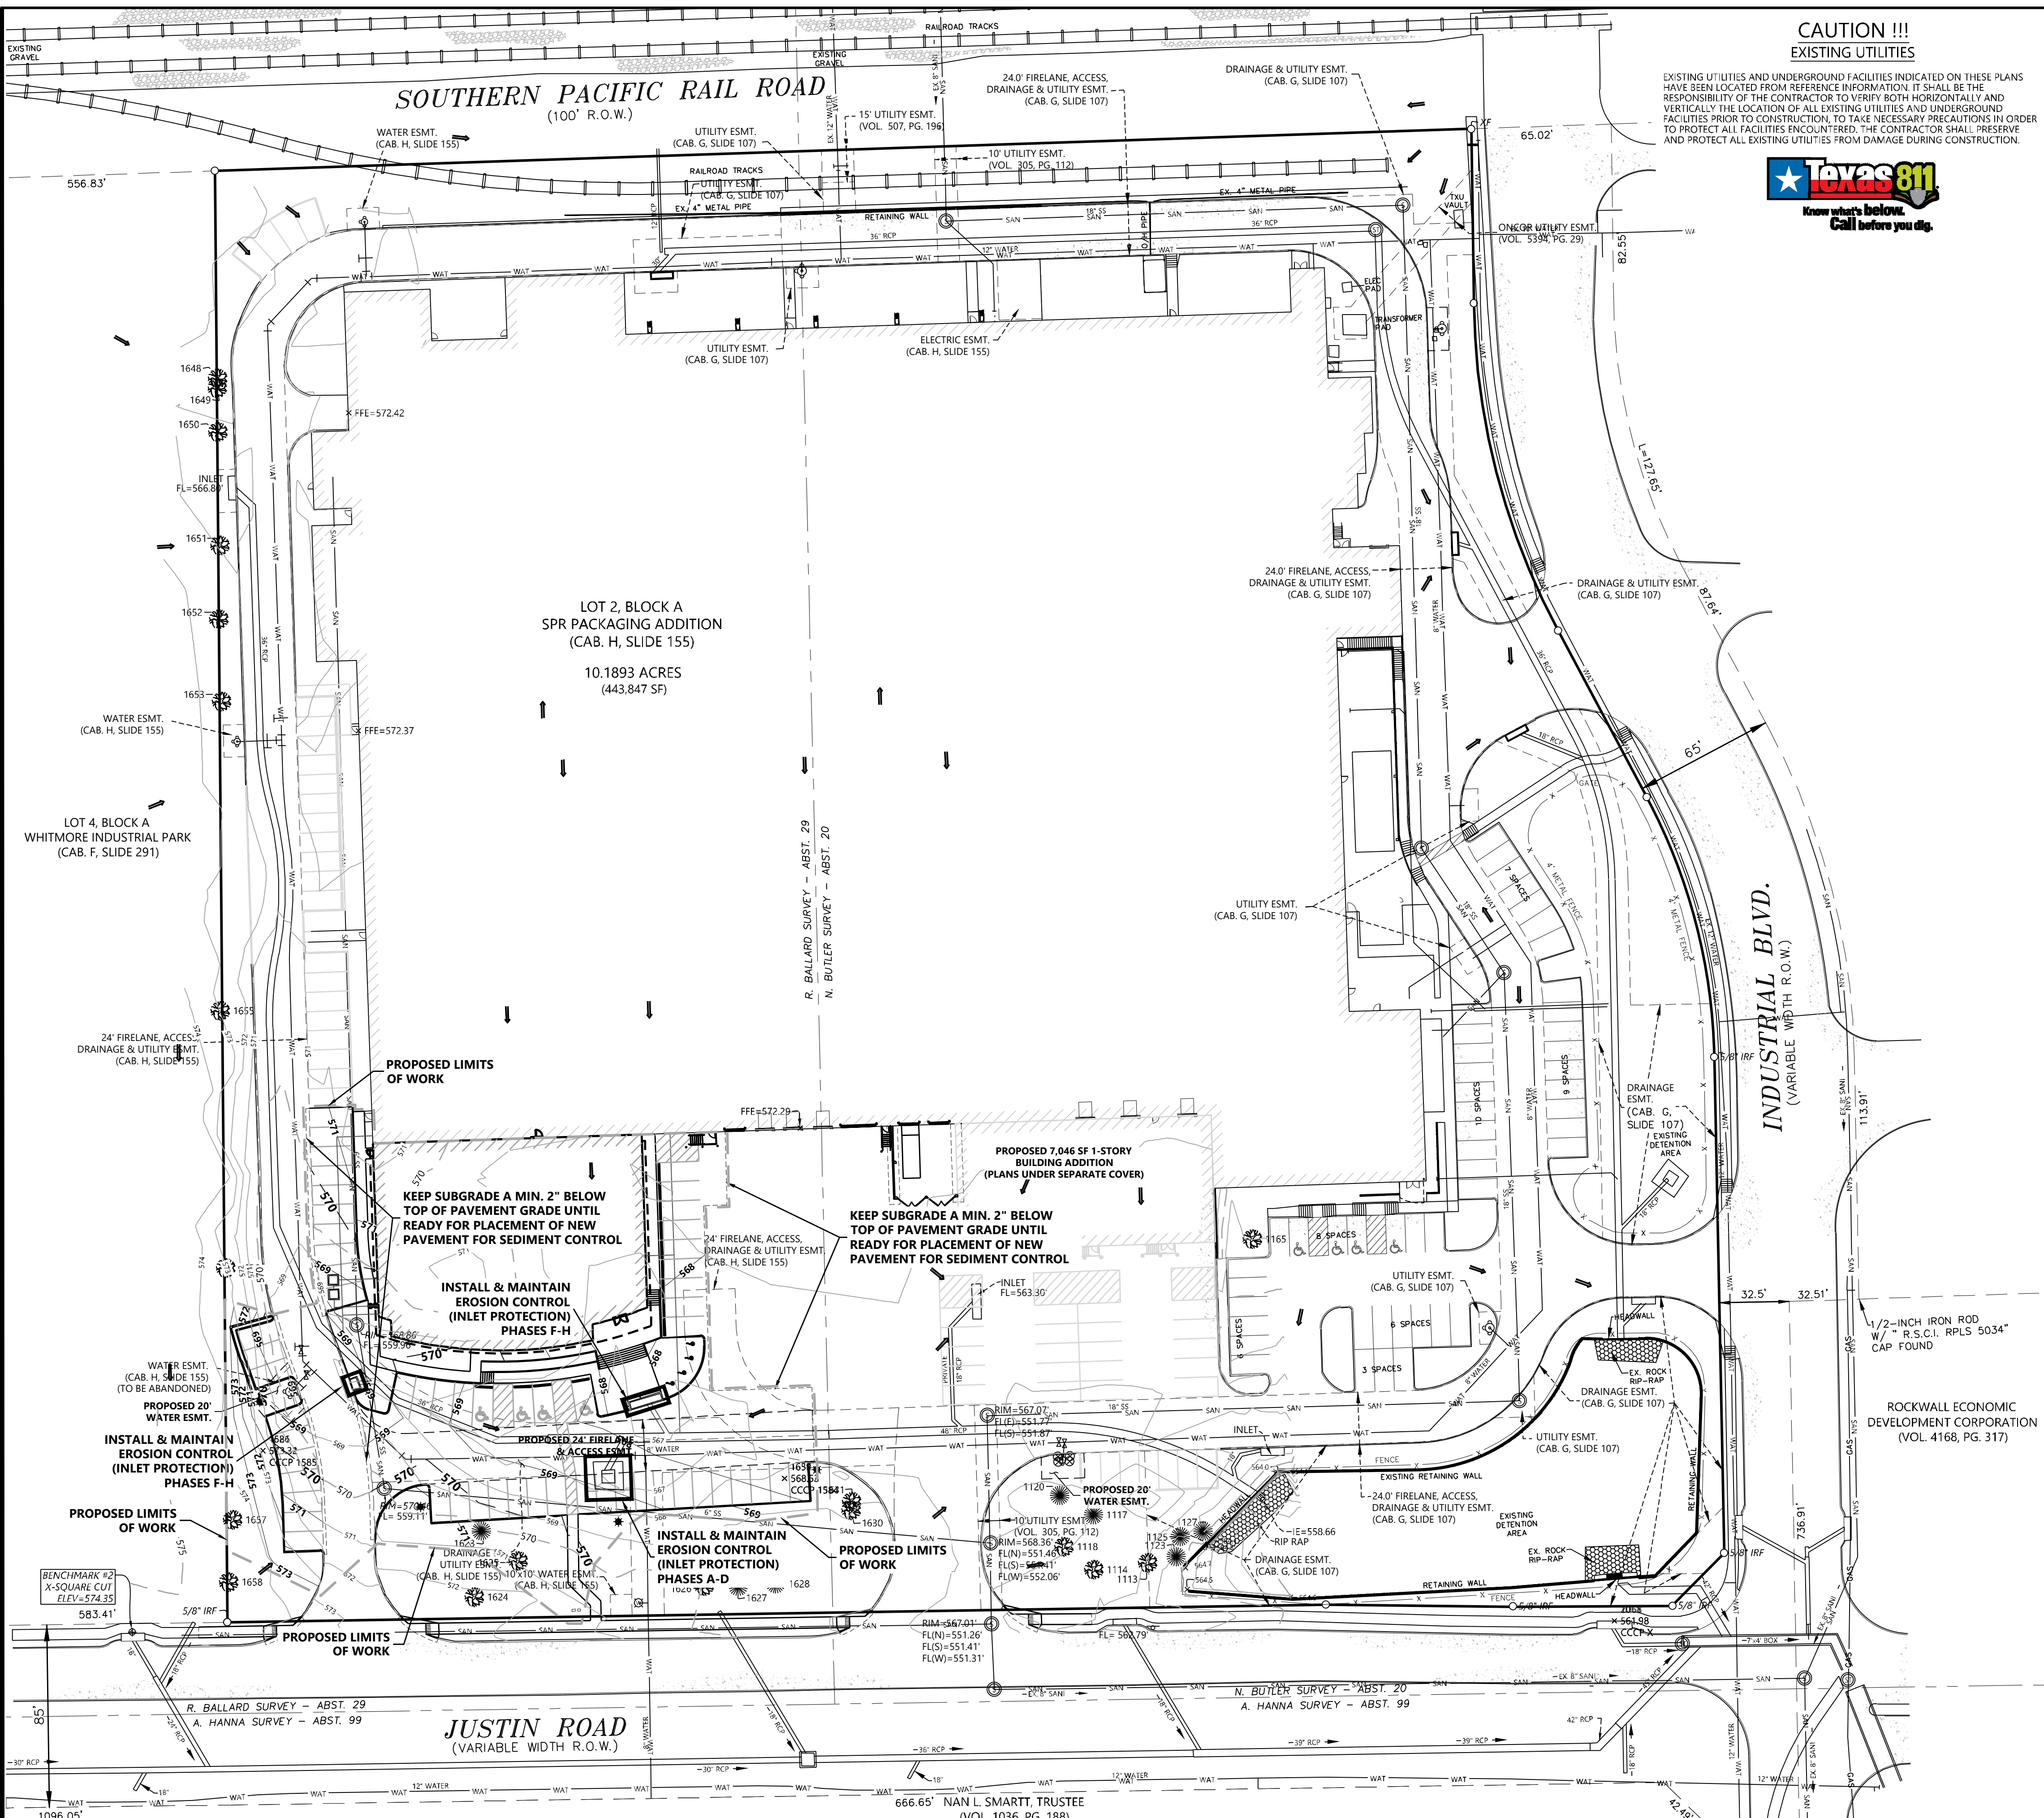

CAUTION !!! EXISTING UTILITIES

EXISTING UTILITIES AND UNDERGROUND FACILITIES INDICATED ON THESE PLANS HAVE BEEN LOCATED FROM REFERENCE INFORMATION. IT SHALL BE THE RESPONSIBILITY OF THE CONTRACTOR TO VERIFY BOTH HORIZONTALLY AND VERTICALLY THE LOCATION OF ALL EXISTING UTILITIES AND UNDERGROUND FACILITIES PRIOR TO CONSTRUCTION. TO TAKE NECESSARY PRECAUTIONS IN ORDER TO PROTECT ALL FACILITIES ENCOUNTERED. THE CONTRACTOR SHALL PRESERVE AND PROTECT ALL EXISTING UTILITIES FROM DAMAGE DURING CONSTRUCTION.

Texas 811
Know what's below. Call before you dig.

Tree Table		Tree Table	
Point #	Description	Point #	Description
1113	CYPRESS 6" 10S	1628	CEDAR 6" 15S
1114	CYPRESS 6" 15S	1629	HACKBERRY 10" 20S
1117	CEDAR 10" 25S	1630	HACKBERRY 12" 30S
1118	CYPRESS 6" 15S	1631	HACKBERRY 12" 30S
1120	CEDAR 12" 30S	1648	HACKBERRY 8" 20S
1123	CEDAR 8" 20S	1649	HACKBERRY 10" 15S
1125	CEDAR 8" 20S	1650	HACKBERRY 8" 20S
1127	CEDAR 8" 20S	1651	HACKBERRY 18" 30S
1165	UNKNOWN 8" 20S	1652	HACKBERRY 15" 20S
1622	CEDAR 6" 20S	1653	HACKBERRY 9" 25S
1623	CEDAR 6" 20S	1654	BOIS D ARC 30" 70S
1624	UNKNOWN 6" 20S	1655	HACKBERRY 12" 25S
1625	CEDAR ELM 6" 20S	1656	HACKBERRY 8" 20S
1626	HACKBERRY 27" 50S	1657	HACKBERRY 8" 20S
1627	CEDAR 6" 15S	1658	MULBERRY 27" 50S

REMOVE EXISTING TREE

ADA ROUTE

NOTE: MAXIMUM SLOPE FOR ALL ADA PATHS 5%; MAX. CROSS FALL IS 2%; FOR THE FIRST FIVE FOOT FROM THE DOOR A 2% SLOPE (MAX.) MUST BE MAINTAINED

1" = 40'

BENCH MARK LIST:

BENCHMARK #1
X-CUT FOUND ON THE TOP OF CURB OF THE SOUTHERN CURB RETURN AT EAST SIDE OF INDUSTRIAL BLVD. 590'± SOUTH FROM CENTERLINE OF RAILROAD. ELEVATION = 564.27

BENCHMARK #2
X-CUT SET AT THE SOUTHEAST CORNER OF CURB INLET LOCATED IN NORTH SIDE OF JUSTIN ROAD 40'± WEST OF SOUTHWEST CORNER OF SITE. ELEVATION = 574.35

DISTURBED AREA = 0.85 ACRES

- EROSIONS CONTROL GENERAL NOTES:**
- REFER TO SHEET 4.02 FOR THE EROSION CONTROL DETAILS AND POLLUTION PREVENTION PLAN NOTES/SPECIFICATIONS/REQUIREMENTS.
 - THE CONTRACTOR SHALL BE RESPONSIBLE FOR MAINTAINING ALL MEASURES OF THIS EROSION CONTROL PLAN (SWPPP) AND COMPLYING WITH ALL FEDERAL, STATE AND LOCAL REQUIREMENTS REGARDING THE SWPPP.
 - THE CONTRACTOR SHALL BE RESPONSIBLE FOR INSTALLING AND MAINTAINING THESE MEASURES INCLUDING WATERING, MOWING AND GENERAL MAINTENANCE UNLESS OTHERWISE RELIEVED OF THESE DUTIES BY THE OWNER.

- VEGETATION NOTES:**
- ALL DISTURBED AREAS NOT BEING RE-DISTURBED WITHIN A MINIMUM OF 14 DAYS MUST BE COVERED AND STABILIZED.
 - THE CONTRACTOR SHALL SEED ALL DISTURBED AREAS IMMEDIATELY UPON COMPLETION OF FINAL GRADING.
 - NO PUBLIC ACCEPTANCE UNTIL (FINAL STABILIZATION) VEGETATION IS ESTABLISHED ON ALL DISTURBED AREAS.
 - FINAL STABILIZATION IS DEFINED AS A UNIFORM PERENNIAL VEGETATIVE COVER AT A MINIMUM OF 70% RESTORATION OF THE NATIVE OR NATURAL PREEXISTING BACKGROUND COVER FOR THE AREA.

- CONSTRUCTION ACTIVITIES:**
- THE CONSTRUCTION ACTIVITY INCLUDED IN THIS PLAN WILL INCLUDE THE FOLLOWING CONSTRUCTION PHASES:
- CLEARING AND GRUBBING
 - STOCK PILING
 - ROUGH GRADING
 - UTILITY INSTALLATION/EXCAVATION OF TRENCHES
 - FINAL OR FINISH GRADING
 - PAVEMENT INSTALLATION
 - BUILDING CONSTRUCTION
 - PREPARATION OF SEEDING AND PLANTING

RECORD DRAWINGS:

IT WAS THE INTENT THAT THE IMPROVEMENTS SHOWN BE CONSTRUCTED ACCORDING TO THESE PLANS AS APPROVED BY THE CITY. THE LINES AND GRADES WERE SET ON THE GROUND FOR CONSTRUCTION ACCORDING TO SAID PLANS. THE CITY INSPECTED THE CONSTRUCTION. WE ARE NOT AWARE OF ANY CHANGES OR REVISIONS TO THESE PLANS DURING CONSTRUCTION OTHER THAN THOSE SHOWN. TO THE BEST OF OUR KNOWLEDGE, WESTWOOD PROFESSIONAL SERVICES, INC. HEREBY STATES THAT THIS PLAN IS AS-BUILT. THE INFORMATION PROVIDED IS BASED ON SURVEYING AT THE SITE AND INFORMATION PROVIDED BY THE CONTRACTOR. DATE: 02-08-2021

DESIGNED:	AWS
CHECKED:	AWS
DRAWN:	WTV
HORIZONTAL SCALE:	##
VERTICAL SCALE:	## or ##

INITIAL ISSUE:	11-08-2019
REVISIONS:	
1	03-16-2020 SITE REVISIONS
2	05-13-2020 FOR CONSTRUCTION
3	12-16-2020 REMOVE AND REPLACE SIDEWALK ALONG JUSTIN ROAD
4	02-05-2021 REVISED ENTRY PLAZA AREA
5	02-08-2021 RECORD DRAWINGS

PREPARED FOR:

PROSS DESIGN GROUP, INC.

5310 HARVEST HILL ROAD, SUITE 180
DALLAS, TEXAS 75230



SPR OFFICE ADDITION

ROCKWALL, TEXAS

Westwood

Phone (214) 473-4640 2740 Dallas Parkway, Suite 280
Toll Free (888) 937-5150 Plano, TX 75093
westwoodps.com

Westwood Professional Services, Inc.
TYPE FIRM REGISTRATION NO. F-11750
TYPE FIRM REGISTRATION NO. 10014301

EROSION CONTROL PLAN

4.01

PROJECT NUMBER: 0014830-02 DATE: 11-08-2019

SPR OFFICE ADDITION