


DESIGNED:	AWS
CHECKED:	AWS
DRAWN:	WTW
HORIZONTAL SCALE:	
VERTICAL SCALE:	

INITIAL ISSUE:	11-08-2019
REVISIONS:	
1	03-16-2020 SITE REVISIONS
2	05-13-2020 FOR CONSTRUCTION
3	12-16-2020 REMOVE AND REPLACE SIDEWALK ALONG JUSTIN ROAD
4	02-05-2021 REVISED ENTRY PLAZA AREA
5	02-08-2021 RECORD DRAWINGS

PREPARED FOR:

PROSS DESIGN GROUP, INC.

5310 HARVEST HILL ROAD, SUITE 180
DALLAS, TEXAS 75230

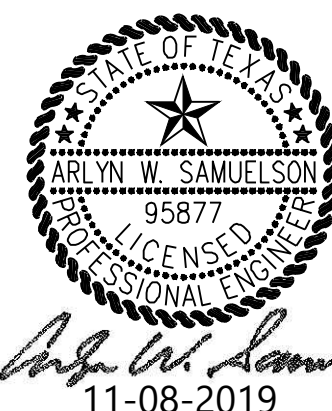

SPR OFFICE ADDITION
ROCKWALL, TEXAS

Westwood

Phone (214) 473-4640 2740 Dallas Parkway, Suite 280
Toll Free (888) 937-5150 Plano, TX 75093
westwoodps.com

Westwood Professional Services, Inc.
TYPE FIRM REGISTRATION NO. F-11756
TSPS FIRM REGISTRATION NO. 10074301

UTILITY DETAILS (1 OF 2)

SHEET NUMBER:

5.02

DATE: 11-08-2019