




CURB INLET
5', 10', 15' OR 20' OPENING
North Central Texas Council of Governments
STANDARD SPECIFICATION REFERENCE: 702
DATE: OCT. '04
STANDARD DRAWING NO.: 6020A

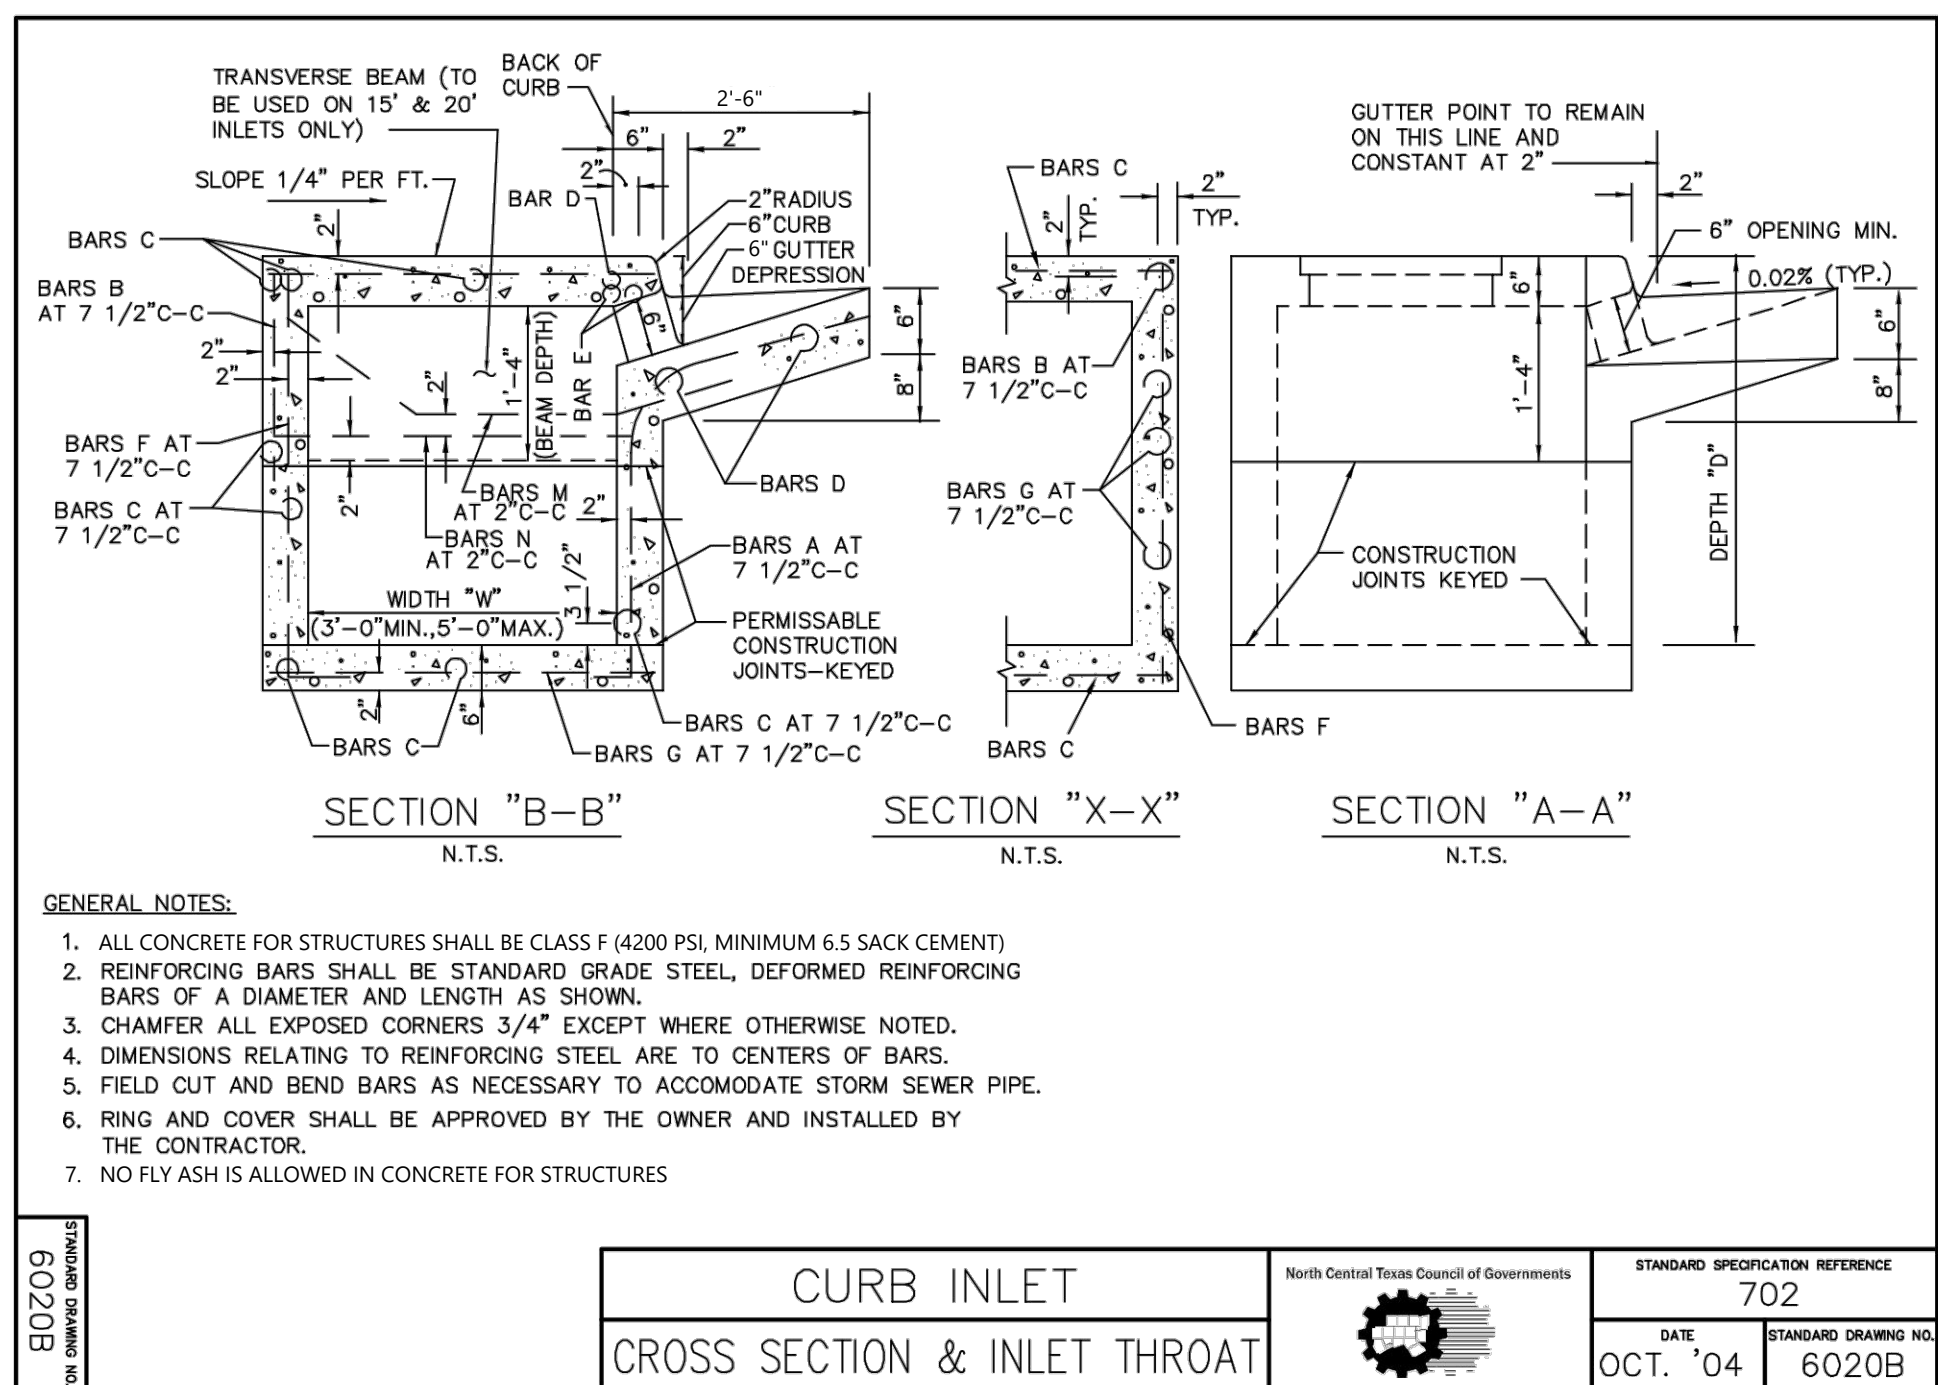

CURB INLET
CROSS SECTION & INLET THROAT
North Central Texas Council of Governments
STANDARD SPECIFICATION REFERENCE: 702
DATE: OCT. '04
STANDARD DRAWING NO.: 6020B

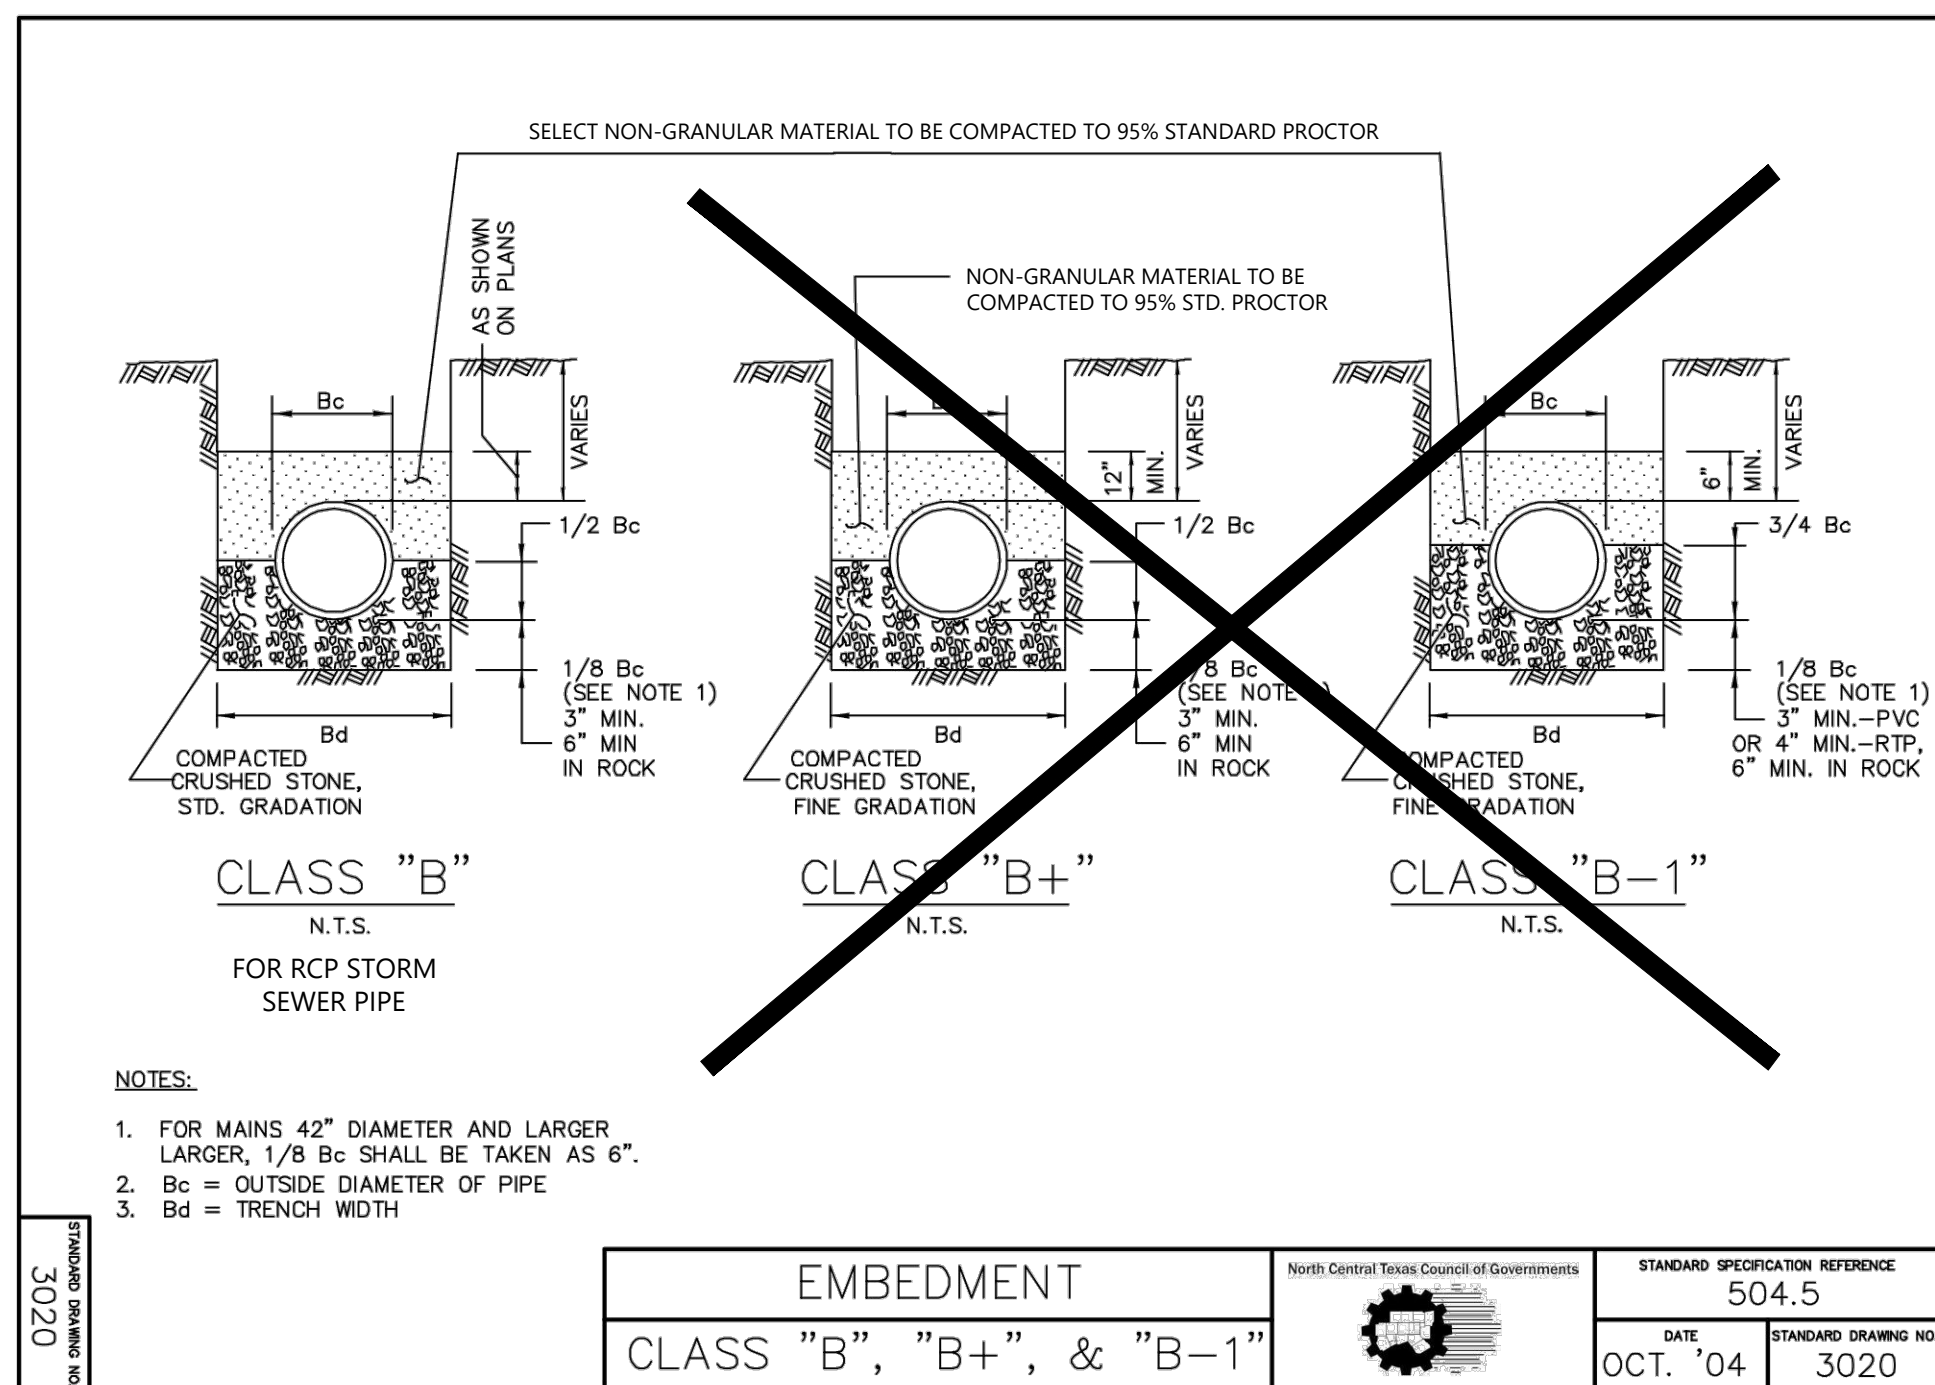

EMBEDMENT
CLASS "B", "B+", & "B-1"
North Central Texas Council of Governments
STANDARD SPECIFICATION REFERENCE: 504.5
DATE: OCT. '04
STANDARD DRAWING NO.: 3020

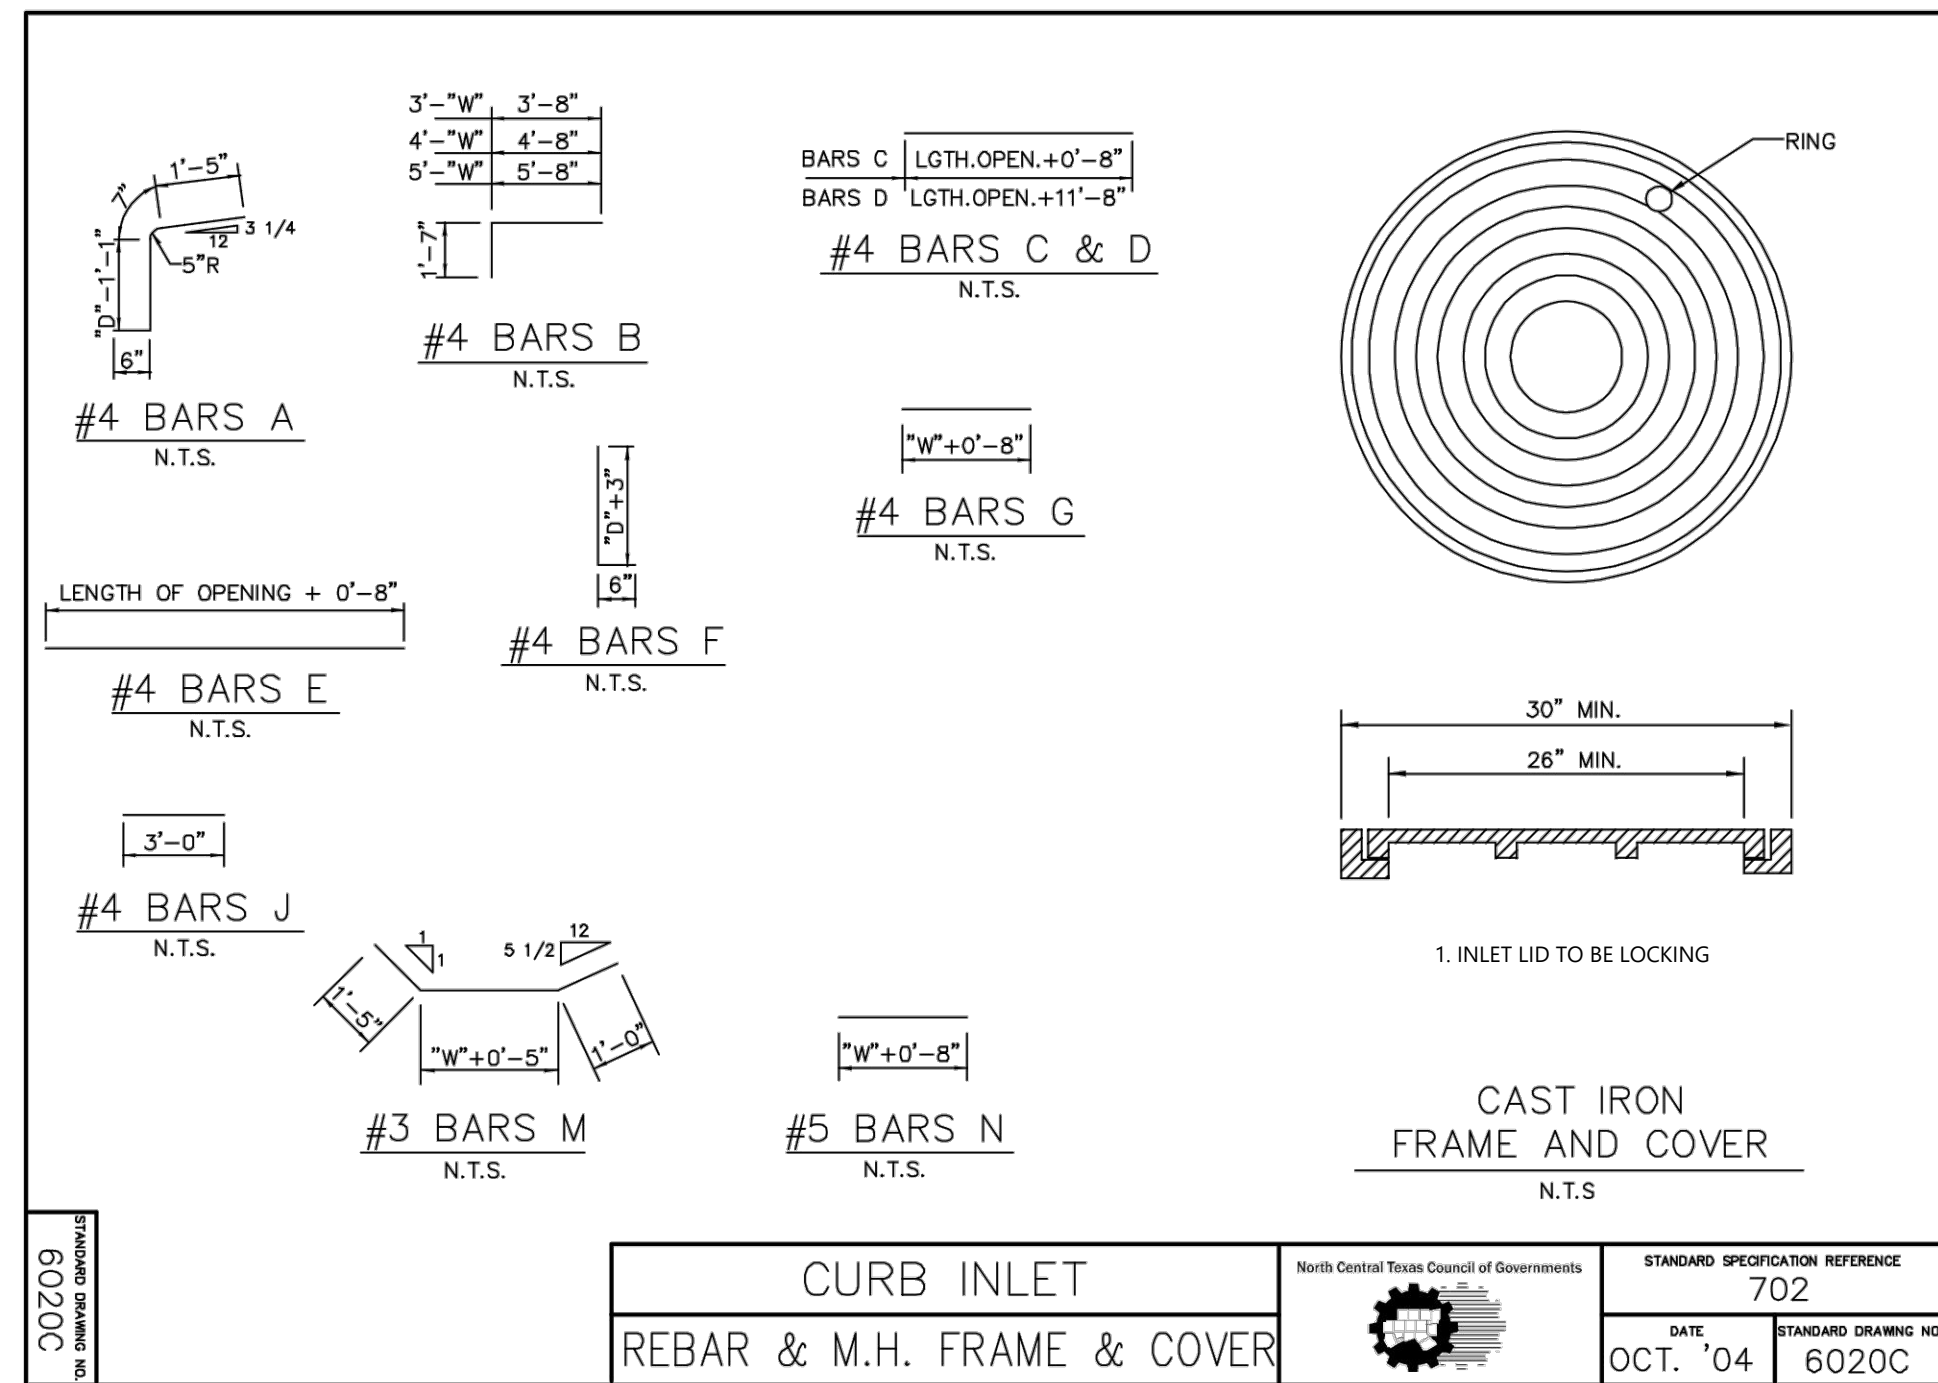

CURB INLET
REBAR & M.H. FRAME & COVER
North Central Texas Council of Governments
STANDARD SPECIFICATION REFERENCE: 702
DATE: OCT. '04
STANDARD DRAWING NO.: 6020C

BILL OF REINFORCING STEEL

DEPTH "D"	OPENING LENGTH "L" = 5ft												OPENING LENGTH "L" = 10ft												OPENING LENGTH "L" = 15 ft												OPENING LENGTH "L" = 20 ft											
	ALL WIDTHS AND LENGTHS			Widths "W"			Widths "W"			Widths "W"			Widths "W"			Widths "W"			Widths "W"			Widths "W"			Widths "W"			Widths "W"			Widths "W"																	
	C	D	E	J	F	F	A	B	G	F	F	A	B	G	M	N	F	F	A	B	G	M	N	F	F	A	B	G	M	N																		
3'-6"	17	3	2	4	20	24	28	10	20	28	32	36	18	18	28	36	40	44	26	36	2	2	44	48	52	34	44	2	2																			
3'-9"	18								20						28																																	
4'-0"	19								24						32																																	
4'-3"	21								24						32																																	
4'-6"	21								26						34																																	
4'-9"	21								26						34																																	
5'-0"	21								26						34																																	
5'-3"	23								28						36																																	
5'-6"	23								28						36																																	
5'-9"	25								30						38																																	
6'-0"	25								30						38																																	
6'-3"	26								30						38																																	
6'-6"	27								32						40																																	
6'-9"	27								32						40																																	
7'-0"	29								34						42																																	
7'-3"	29								34						42																																	
7'-6"	30								34						42																																	
7'-9"	31								36						44																																	
8'-0"	31								36						44																																	
8'-3"	32								36						44																																	
8'-6"	33								38						46																																	
8'-9"	34								38						46																																	
9'-0"	35								40						48																																	
9'-3"	36								40						48																																	
9'-6"	37								42						50																																	
10'-0"	38								42						50																																	

CURB INLET
BILL OF REINFORCING STEEL
North Central Texas Council of Governments
STANDARD SPECIFICATION REFERENCE: 702
DATE: OCT. '04
STANDARD DRAWING NO.: 6020D

SUMMARY OF QUANTITIES FOR CURB INLETS

DEPTH "D"	5'-0" OPENING												10'-0" OPENING												15'-0" OPENING												20'-0" OPENING											
	WIDTH 3'-0"			WIDTH 4'-0"			WIDTH 5'-0"			WIDTH 3'-0"			WIDTH 4'-0"			WIDTH 5'-0"			WIDTH 3'-0"			WIDTH 4'-0"			WIDTH 5'-0"			WIDTH 3'-0"			WIDTH 4'-0"			WIDTH 5'-0"														
	CONC.	STEEL	C.Y.	CONC.	STEEL	C.Y.	CONC.	STEEL	C.Y.	CONC.	STEEL	C.Y.	CONC.	STEEL	C.Y.	CONC.	STEEL	C.Y.	CONC.	STEEL	C.Y.	CONC.	STEEL	C.Y.	CONC.	STEEL	C.Y.	CONC.	STEEL	C.Y.	CONC.	STEEL	C.Y.															
3'-6"	2.62	3.06	2.95	3.32	3.28	3.73	4.12	4.79	4.64	5.21	5.20	5.64	5.69	6.67	6.40	7.21	7.10	7.75	7.20	8.46	8.11	9.09	8.03	9.76	2.70	3.09	3.04	3.41	3.39	3.73	4.25	4.94	4.78	5.36	5.34	5.79	5.87	6.87	6.58	7.41	7.30	7.96	7.42	8.74	8.34	9.37	8.27	10.10
3'-9"	2.78	3.28	3.14	3.64	3.49	3.99	4.38	5.18	4.92	5.65	5.49	6.10	6.05	7.18	6.77	7.76	7.49	8.35	7.64	9.09	8.58	9.76	8.51	10.46	2.87	3.34	3.23	3.70	3.59	4.06	4.51	5.26	5.06	5.73	5.64	6.19	6.22	7.29	6.95	7.87	7.69	8.47	7.87	9.22	8.81	9.90	9.75	10.61
4'-0"	2.95	3.56	3.32	3.94	3.69	4.31	4.64	5.58	5.20	6.07	5.79	6.56	6.40	7.70	7.14	8.30	8.00	8.93	8.04	9.73	9.04	10.43	9.99	11.15	3.03	3.61	3.41	4.10	3.79	4.38	4.77	5.66	5.34	6.16	5.94	6.65	6.57	7.80	7.32	8.41	8.07	9.03	8.31	9.86	9.27	10.56	10.23	11.29
4'-3"	3.12	3.67	3.51	4.16	3.90	4.45	4.90	5.74	5.47	6.24	6.09	6.74	6.75	7.91	7.51	8.53	8.27	9.15	8.53	9.99	9.50	10.70	10.47	11.44	3.20	3.83	3.60	4.24	4.00	4.65	5.03	6.00	5.61	6.52	6.23	7.04	6.93	8.27	7.69	8.90	8.46	9.55	8.76	10.44	9.73	11.18	10.71	11.94
4'-6"	3.28	3.99	3.69	4.30	4.10	4.72	5.16	6.08	5.75	6.61	6.38	7.13	7.11	8.57	8.89	9.01	8.66	9.67	8.98	10.57	9.97	11.31	10.95	12.08	3.37	4.05	3.78	4.51	4.20	4.95	5.29	6.35	5.89	6.90	6.53	7.44	7.28	8.74	8.07	9.40	8.85	10.07	9.20	11.02	10.20	11.78	11.19	12.58
4'-9"	3.45	4.15	3.88	4.60	4.30	5.04	5.42	6.46	6.03	7.02	6.68	7.57	7.45	8.88	8.25	9.54	9.05	10.22	9.42	11.19	10.43	11.96	11.43	12.76	3.53	4.25	3.97	4.70	4.41	5.15	5.55	6.61	6.17	7.18	6.83	7.73	7.63	9.08	8.44	9.75	9.24	10.44	9.64	11.47	10.66	12.23	11.67	13.05
5'-0"	3.62	4.37	4.08	4.86	4.51	5.32	5.68	6.81	6.31	7.39	6.97	7.97	7.81	9.35	8.62	10.05	9.43	10.57	9.87	11.78	10.89	12.58	11.92	13.40	3.70	4.41	4.15	4.90	4.61	5.37	5.81	6.88	6.45	7.47	7.12	8.06	7.98	9.45	8.81	10.15	9.63	10.66	10.09	11.91	11.12	12.72	12.15	13.55
5'-3"	3.78	4.60	4.25	5.10	4.71	5.60	5.94	7.16	6.59	7.77	7.27	8.37	8.16	9.81	8.99	10.53	9.82	11.26	10.31	12.37	11.35	13.19	12.40	14.04	3.86	4.65	4.34	5.16	4.81	5.67	6.07	7.24	6.72	7.85	7.42	8.46	8.33	9.92	9.18	10.53	10.22	11.38	10.53	12.49	11.59	13.33	12.64	14.18
5'-6"	3.95	4.77	4.43	5.29	4.91	5.70	6.20	7.42	6.86	8.04	7.57	8.66	8.51	10.16	9.36	10.89	10.21	11.63	10.75	12.90	11.82	13.65	12.88	14.51	4.03	4.91	4.53	5.44	5.02	5.97	6.33	7.62	7.00	8.28	7.71	8.90	8.67	10.40	9.55	11.16	10.41	11.93	10.98	13.13	12.05	13.99	13.12	14.98
5'-9"	4.12	4.96	4.62	5.50	5.12	6.04	6.46	7.70	7.14	8.34	7.86	8.99	8.86	10.51	9.73	11.29	10.60	12.05	11.20	13.25	12.28	14.12	13.36	15.10	4.20	5.04	4.71	5.59	5.22	6.13	6.59	7.84	7.28	8.49	8.01	9.15	9.04	10.69	9.92	11.49	10.80	12.28	11.42	13.53	12.51	14.40	13.60	15.29
6'-0"	4.28	5.19	4.80	5.76	5.32	6.32	6.72	8.04	7.42	8.71	8.16	9.38	9.21	11.07	10.19	11.78	10.99	12.57	11.64	13.85	12.74	14.74	13.84	15.65	4.37	5.28	4.90	5.86	5.42	6.43	6.84	8.19	7.56	8.86	8.31	9.54	9.39	11.19	10.29	11.99	11.18	12.80	11.87	14.10	12.97	15.00	14.08	15.92
6'-3"	4.45	5.45	4.99	6.05	5.53	6.64	6.97	8.42	7.70	9.12	8.46	9.82	9.56	11.48	10.47	12.13	11.38	13.13	12.09	14.47	13.21	15.39	14.32	16.31	4.62	5.68	5.17	6.30	5.73	6.92	7.23	8.78	7.97	9.50	8.75	10.22	9.92	11.95	10.84	12.80	11.77	13.65	12.53	15.05	13.67	16.00	14.80	16.96
6'-6"	4.78	5.82	5.36	6.45	5.93	7.08	7.49	9.00	8.11	9.74	9.05	10.48	10.27	12.27	11.21	13.12	12.16	13.99	12.98	15.46	14.13	16.42	15.29	17.39																								

CURB INLET
SUMMARY OF QUANTITIES
North Central Texas Council of Governments
STANDARD SPECIFICATION REFERENCE: 702
DATE: OCT. '04
STANDARD DRAWING NO.: 6020E

RECORD DRAWINGS:
IT WAS THE INTENT THAT THE IMPROVEMENTS SHOWN BE CONSTRUCTED ACCORDING TO THESE PLANS AS APPROVED BY THE CITY. THE LINES AND GRADES WERE SET ON THE GROUND FOR CONSTRUCTION ACCORDING TO SAID PLANS. THE CITY INSPECTED THE CONSTRUCTION. WE ARE NOT AWARE OF ANY CHANGES OR REVISIONS TO THESE PLANS DURING CONSTRUCTION OTHER THAN THOSE SHOWN. TO THE BEST OF OUR KNOWLEDGE, WESTWOOD PROFESSIONAL SERVICES, INC. HEREBY STATES THAT THIS PLANS IS AS-BUILT. THE INFORMATION PROVIDED IS BASED ON SURVEYING AT THE SITE AND INFORMATION PROVIDED BY THE CONTRACTOR. DATE: 02-08-2021

DESIGNED:	AWS
CHECKED:	AWS
DRAWN:	WTW
HORIZONTAL SCALE:	
VERTICAL SCALE:	

INITIAL ISSUE:	11-08-2019
REVISIONS:	
03-16-2020	SITE REVISIONS
05-13-2020	FOR CONSTRUCTION
12-16-2020	REMOVE AND REPLACE SIDEWALK ALONG JUSTIN ROAD
02-05-2021	REVISED ENTRY PLAZA AREA
02-08-2021	RECORD DRAWINGS

PREPARED FOR:
PROSS DESIGN GROUP, INC.
5310 HARVEST HILL ROAD, SUITE 180
DALLAS, TEXAS 75230

11-08-2019

SPR OFFICE ADDITION
ROCKWALL, TEXAS

Westwood
Phone: (