

FIRE HYDRANT NOTE:

1. FIRE HYDRANTS SHALL BE LOCATED 3' OFF BACK OF CURB IN RESIDENTIAL, & 4' OFF BACK OF CURB IN INDUSTRIAL, OR AS NOTED ON PLANS.
2. FIRE HYDRANTS SHALL BE COATED WITH KEM-LUSTRAL VERMILION RED (F6SRI) OR AN EQUIVALENT COATING.
3. ALL FIRE HYDRANTS SHALL BE PAINTED AFTER INSTALLATION AND COLOR CODED PER CITY SPECIFICATIONS (BLUE FOR HYDRANTS ATTACHED TO AN 8" WATER MAIN)
4. CONTRACTOR SHALL INSTALL MEGALUGS FOR ALL MECHANICAL JOINT RESTRAINTS.

6" STEEL PIPE W/CONCRETE FILL 6" LENGTH (3" ABOVE PAVING, 3" BELOW PAVING) TO BE CASED IN 16" PIER TO DEPTH OF 1'-0" BELOW BOTTOM OF PIPE USE 2-#6X12" THRU PIPE INTO CONCRETE PIER. PIPES TO BE PAINTED SAME AS F.H. - ALUMINUM.

NOTE:
A 5' CLEAR SPACE SHALL BE MAINTAINED AROUND THE CIRCUMFERENCE OF ALL FIRE HYDRANTS.

NOTE:
FOR ALL OTHER WATER & SANITARY SEWER DETAILS, USE CITY OF ROCKWALL DETAILS.

RECORD DRAWINGS:
IT WAS THE INTENT THAT THE IMPROVEMENTS SHOWN BE CONSTRUCTED ACCORDING TO THESE PLANS AS APPROVED BY THE CITY. THE LINES AND GRADES WERE SET ON THE GROUND FOR CONSTRUCTION ACCORDING TO SAID PLANS. THE CITY INSPECTED THE CONSTRUCTION. THE ENGINEER DID NOT VERIFY LINES OR GRADES AFTER CONSTRUCTION. WE ARE NOT AWARE OF ANY CHANGES OR REVISIONS TO THESE PLANS DURING CONSTRUCTION OTHER THAN THOSE SHOWN.

RANDALL P. POGUE, P.E. DATE: FEBRUARY 25, 2008
TX LIC. NO. 84780

BOX: 05/07/2008 - 5:01PM
N:\085\1500-199\1512-06-094\DWG\1512-06-094-07A.DWG
© POGUE ENGINEERING & DEVELOPMENT COMPANY, INC. 2008. ALL RIGHTS RESERVED. THE ENGINEERING DESIGN, DETAIL AND ENGINEERING DRAWINGS FOR THIS PROJECT AND/OR OVERALL PROJECT ARE THE LEGAL PROPERTY OF POGUE ENGINEERING & DEVELOPMENT COMPANY, INC. THEIR USE FOR REPRODUCTION, CONSTRUCTION, OR DISTRIBUTION IS PROHIBITED UNLESS AUTHORIZED IN WRITING BY POGUE ENGINEERING & DEVELOPMENT COMPANY, INC.


NO.	DATE	REVISION / DESCRIPTION		
02-25-08		RECORD DRAWINGS		
04-12-07		FIRE HYDRANT DETAILS REVISIONS		
03-12-07		CITY WATER MAIN RELOCATION		
02-26-07		SITE PLAN REVISIONS		
02-09-07		NORTHERNMOST ACCESS DRIVE & FIRE HYDRANT REVISIONS		
DESIGN	DRAWN	DATE	SCALE	NOTES
RPP	BEC	01-29-2007	AS SHOWN	-

OWNER
THE WHITMORE MANUFACTURING COMPANY
P.O. BOX 9300
ROCKWALL, TEXAS 75083
MR. RAY SCHWERTNER
(972) 771-1000 PHONE
(972) 722-2108 FAX

DEVELOPER
SPR VENTURE, INC.
5720 SPERLING, SUITE 630
DALLAS, TEXAS 75240
MR. STEVEN ROSENBERG
(214) 862-8680 PHONE
(972) 385-0279 FAX

THE SEAL APPEARING ON THIS DOCUMENT WAS AUTHORIZED BY RANDALL P. POGUE, P.E. 84780 ON 02-25-2007. ALTERATION OF A SEALED DOCUMENT WITHOUT PRIOR NOTIFICATION TO THE RESPONSIBLE ENGINEER IS AN OFFENSE UNDER THE TEXAS ENGINEERING PRACTICE ACT.

R.P.P. 01-29-07

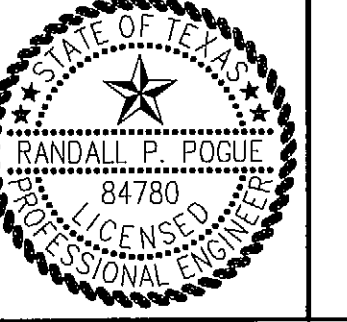

POGUE
ENGINEERING & DEVELOPMENT COMPANY, INC.
1515 HERITAGE DRIVE SUITE 105 MCKINNEY, TEXAS 75069
(214) 544-8880 PHONE (214) 544-8882 FAX
www.PogueEngineering.com

WATER & SANITARY SEWER DETAILS
BLOCK A, LOT 1, SPR PACKAGING ADDITION
NWC OF INDUSTRIAL BLVD. @ JUSTIN ROAD
CITY OF ROCKWALL, TEXAS

SHEET NO. C6.03