




PAVING SPECIFICATIONS:



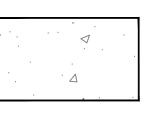

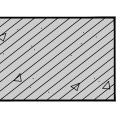

()XA())

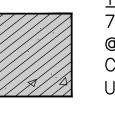

CITY ROW AREA:

FIRE LANE:

GEOTECHNICAL REPORT

COMPACTED TO 95% SPD

