

GENERAL NOTES

- CONTRACTOR TO USE DETAILS AS OUTLINED IN THE STANDARD SPECIFICATIONS FOR PUBLIC WORKS CONSTRUCTION, NORTH CENTRAL TEXAS, THIRD EDITION AND CITY OF ROCKWALL STANDARDS OF DESIGN AND CONSTRUCTION.
- SOME OF THE DETAILS IN THE STANDARD SPECIFICATIONS FOR PUBLIC WORKS CONSTRUCTION, NORTH CENTRAL TEXAS, FOURTH EDITION HAVE BEEN ADJUSTED PER THE CITY OF ROCKWALL'S STANDARDS OF DESIGN AND CONSTRUCTION SECTION 8 SPECIAL PROVISIONS TO THE NCTCOG'S STANDARD SPECIFICATIONS FOR PUBLIC WORKS CONSTRUCTION STANDARDS.

SWBC ROCKWALL PHASE II
Lot 1, Block A
SWBC ROCKWALL ADDITION, PHASE II
21275 Acres
in the
J.M. ALLEN SURVEY ABSTRACT NO. NO. 2
CITY OF ROCKWALL,
ROCKWALL COUNTY, TEXAS


The John R. McAdams Company, Inc.
111 Hillside Drive
Lewisville, Texas 75057
972.435.9712
201 Country View Drive
Rockwall, Texas 75087
940.240.1012
TBPE: 19762 TBPLS: 10194440
www.mcadams.com

PAVING AND WATER STANDARD CONSTRUCTION DETAILS

AS-BUILT RECORD DRAWING

THE INFORMATION ON THESE PLANS HAS BEEN REVISED TO REFLECT CHANGES TO PUBLIC IMPROVEMENTS MADE DURING CONSTRUCTION. UNLESS OTHERWISE NOTED, THE CONSTRUCTION OF THE PUBLIC IMPROVEMENTS IS IN GENERAL CONFORMANCE WITH THESE PLANS, BASED UPON INFORMATION PROVIDED BY THE CONTRACTOR AND FIELD VERIFICATIONS. THE RESPONSIBILITY FOR ACCURACY AND COMPLETENESS BELONGS TO THE CONTRACTOR.

Matthew G. St. Marie
THE JOHN R. MCADAMS COMPANY, INC.
Date: 09/25/2023

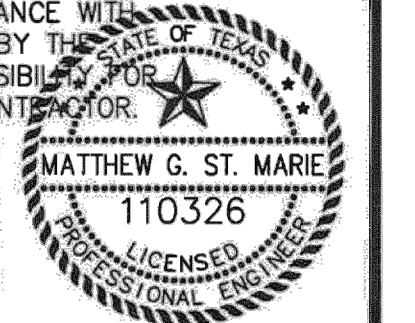

MCADAMS
TBPE 19762

| | |
|------------|------------|
| Drawn By: | CMK |
| Date: | 12/30/2020 |
| Scale: | N.T.S. |
| Revisions: | |
| 02/11/2021 | |
| 03/11/2021 | |
| 05/07/2021 | |
| 07/12/2021 | |

09/25/2023 - AS-BUILT

WBC2000

OWNER/DEVELOPER
SWBC ROCKWALL LP
5049 SHERRY LANE, SUITE 760
DALLAS, TEXAS 75225
Ph. (214) 987-0700
Contact: Spencer Byington

C8.02