


S 89°46'21" W 1841.02'

MATCH A

STA 38+55
PROPERTY
LINE


N. COUNTRY LANE F.M. 1141

STA 1+99
PROPERTY
LINE
 $\Delta = 39^\circ 15' 36"$
 $R = 533.14$
 $T = 190.16'$
 $L = 365.32'$
 $CB = S 19^\circ 00' 43" W$
 $CI = 358.21'$

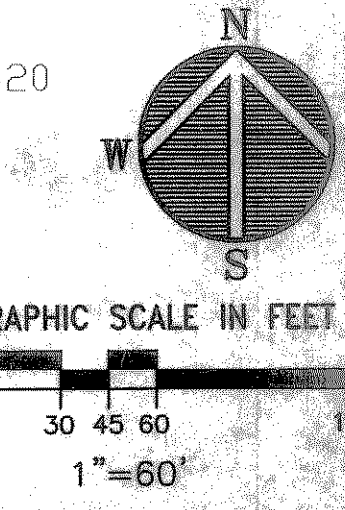

PAVING, WATER, & DRAINAGE PLAN
SADDLEBROOK II
HENNESSEY ENGINEERING, INC.
 1417 W. MAIN ST., SUITE 100, CARROLLTON, TX 75006-6912
 PHONE: 972-245-9478 FAX: 972-245-7087
ROCKWALL COUNTY, TX

DESIGN	DRAWN	DATE	SCALE	NOTES	FILE	NO.
H-E	J.S.	3/31/00	1"=60'		9951	C2&3

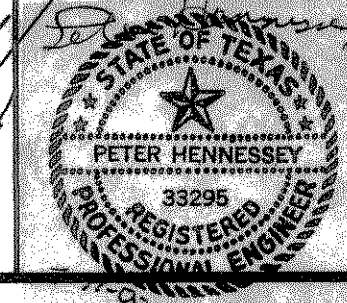

S 89°48'15" W 1565.02'