

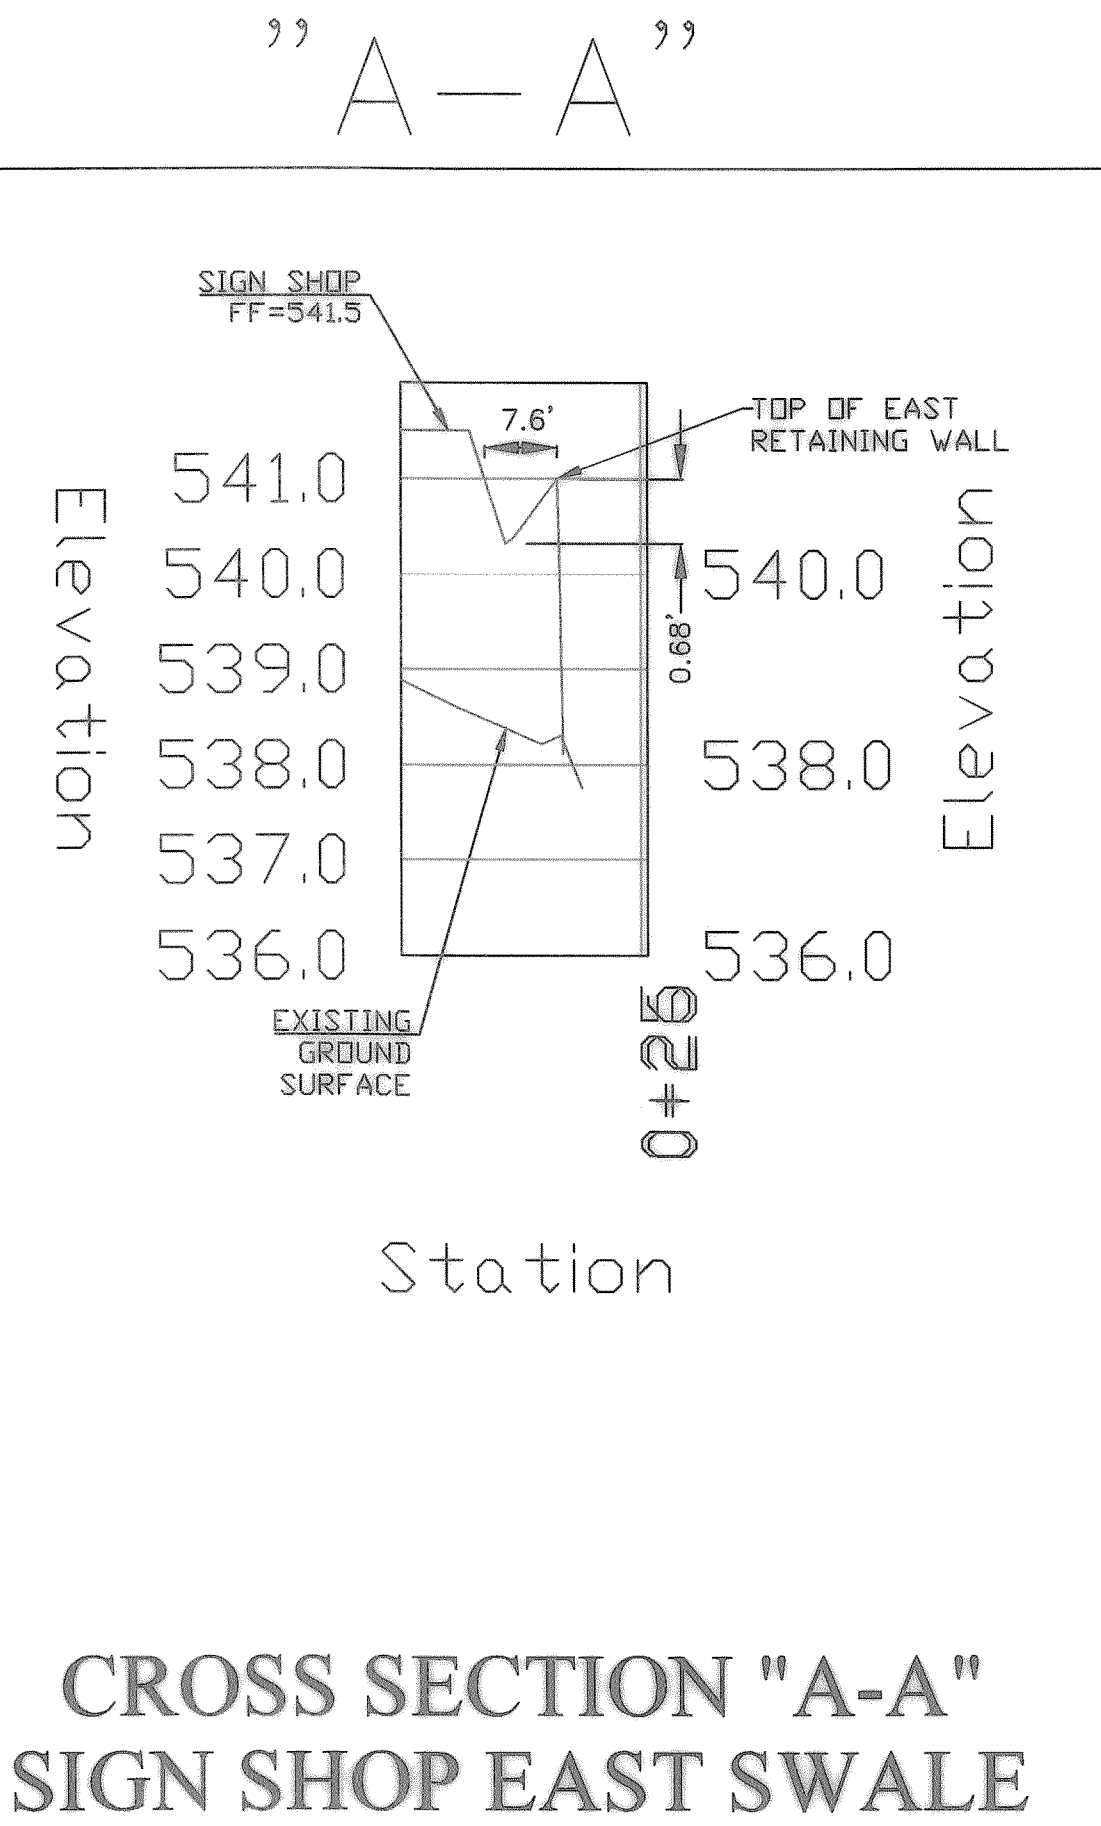


PROPOSED 8" PUBLIC SANITARY SEWER PROFILE

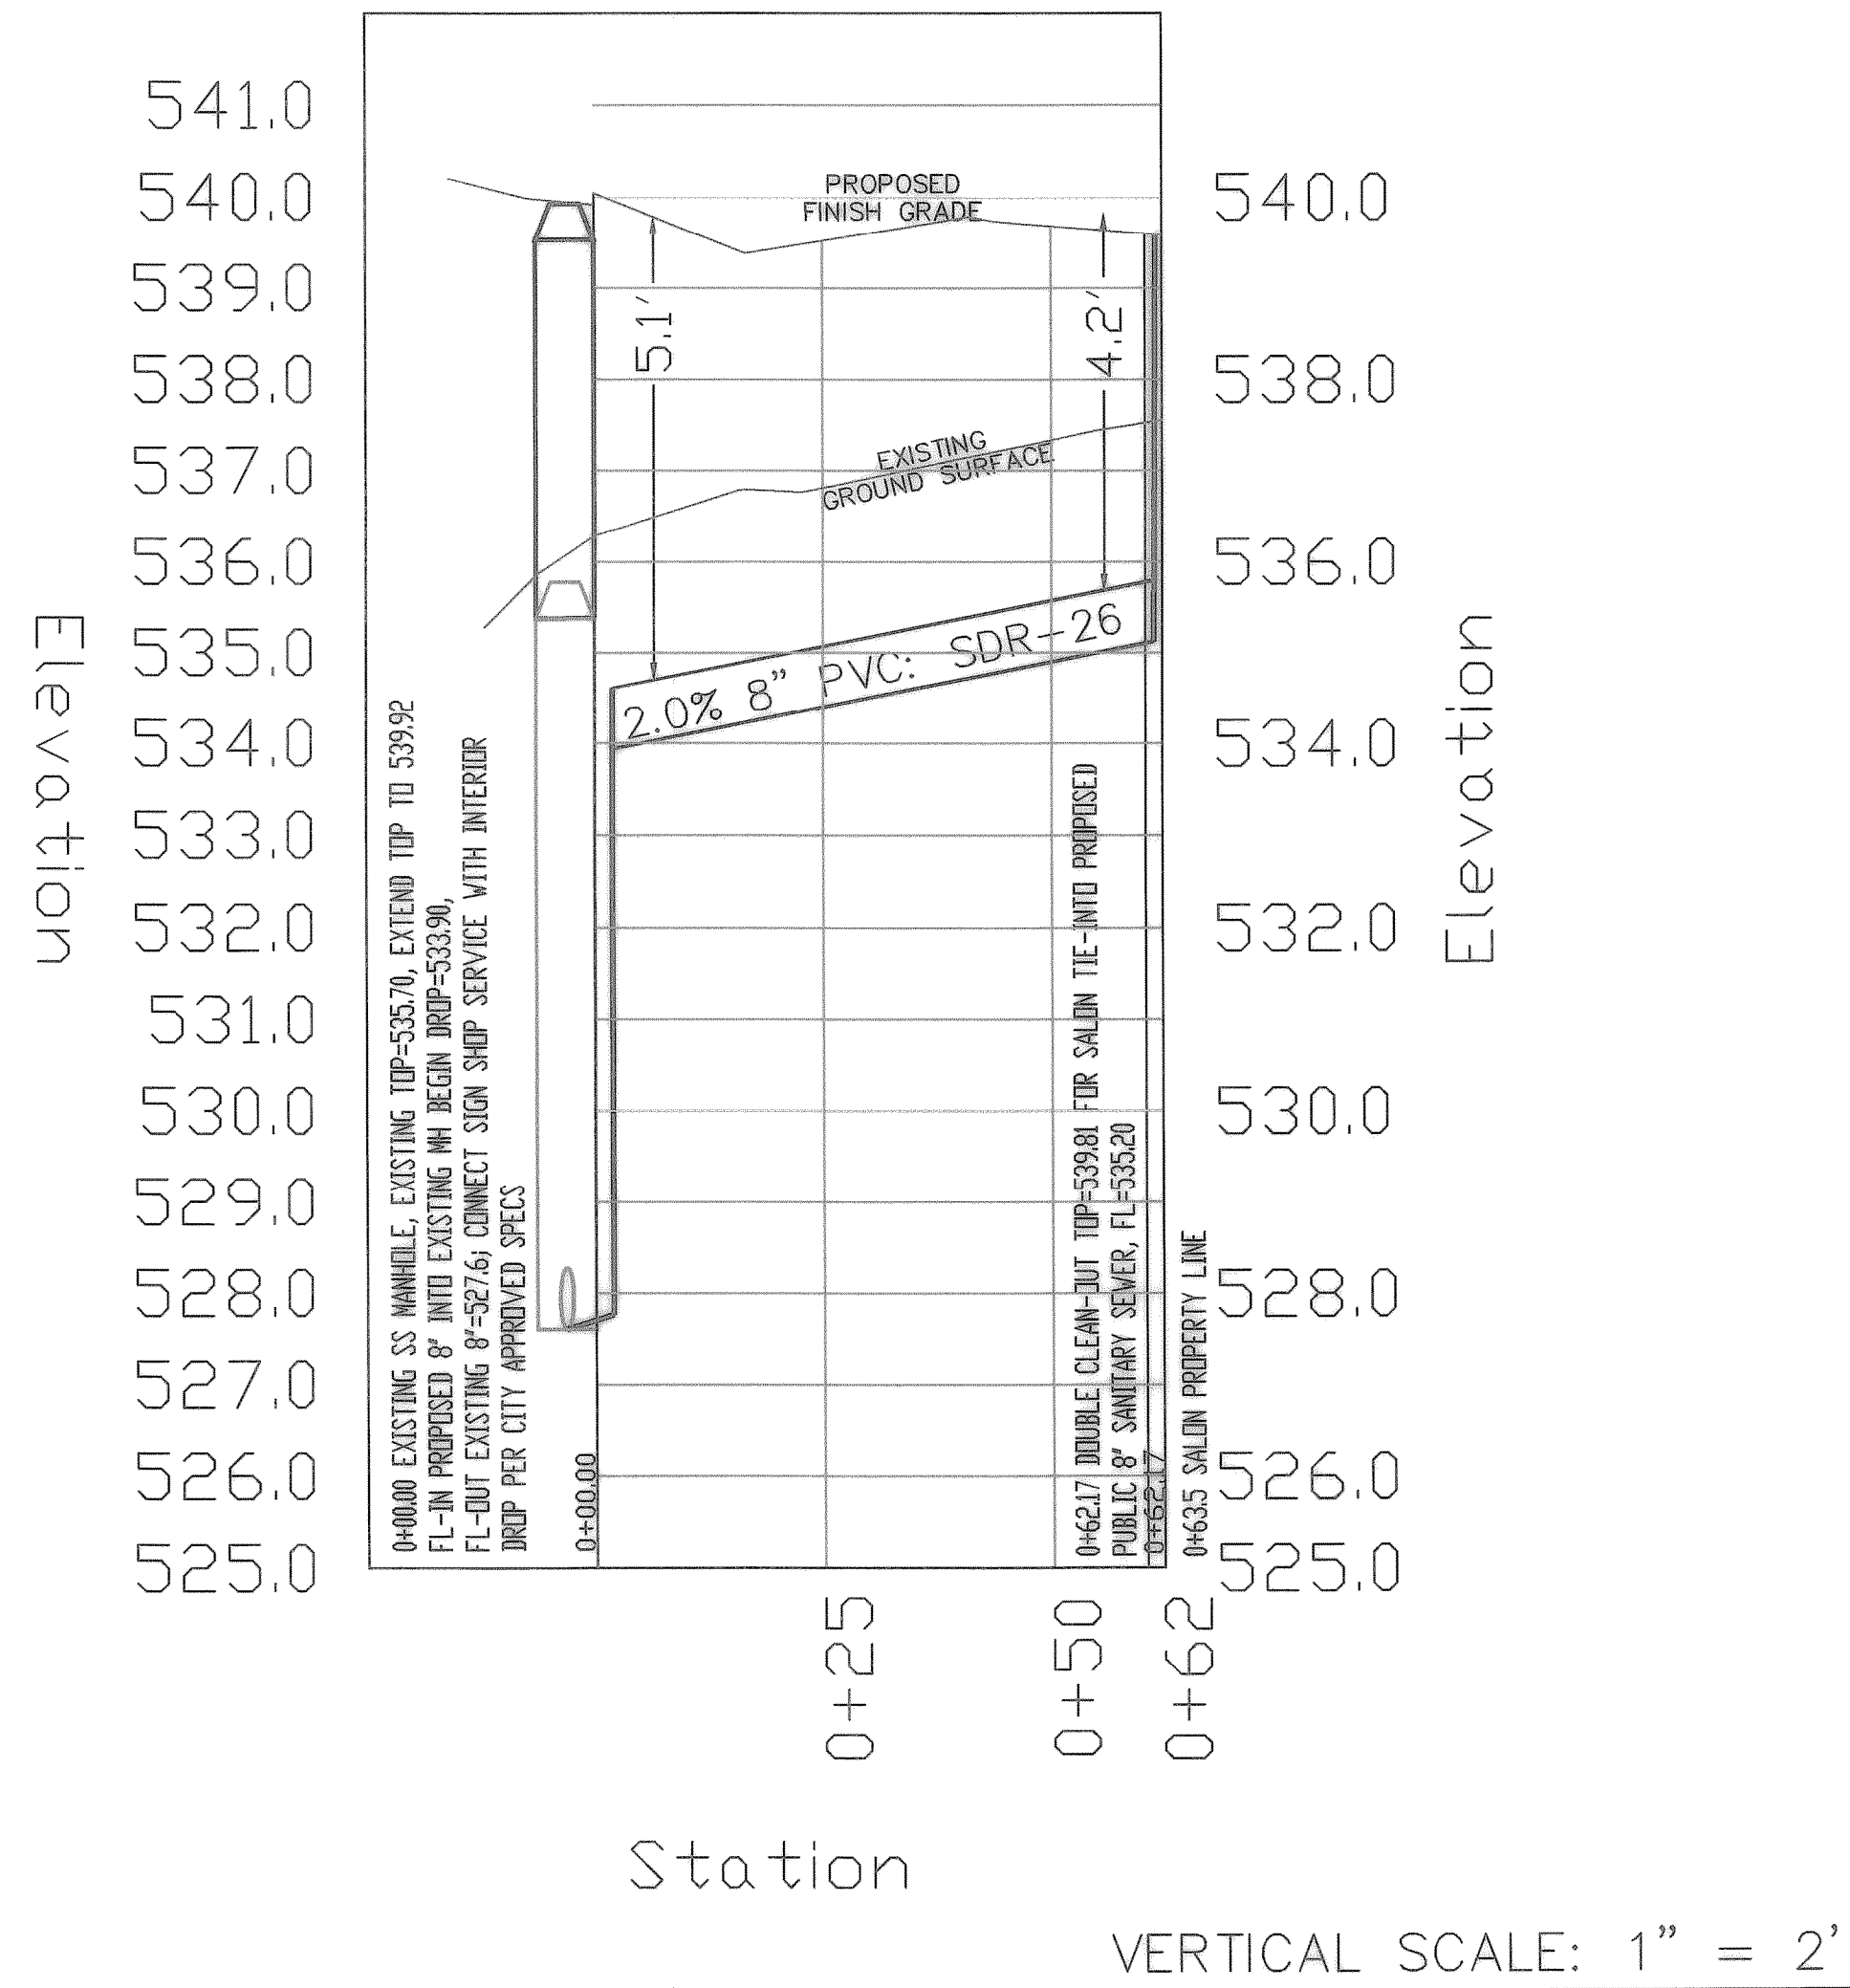


**CROSS SECTION "A-A"
SIGN SHOP EAST SWALE**

VERTICAL SCALE: 1" = 2'

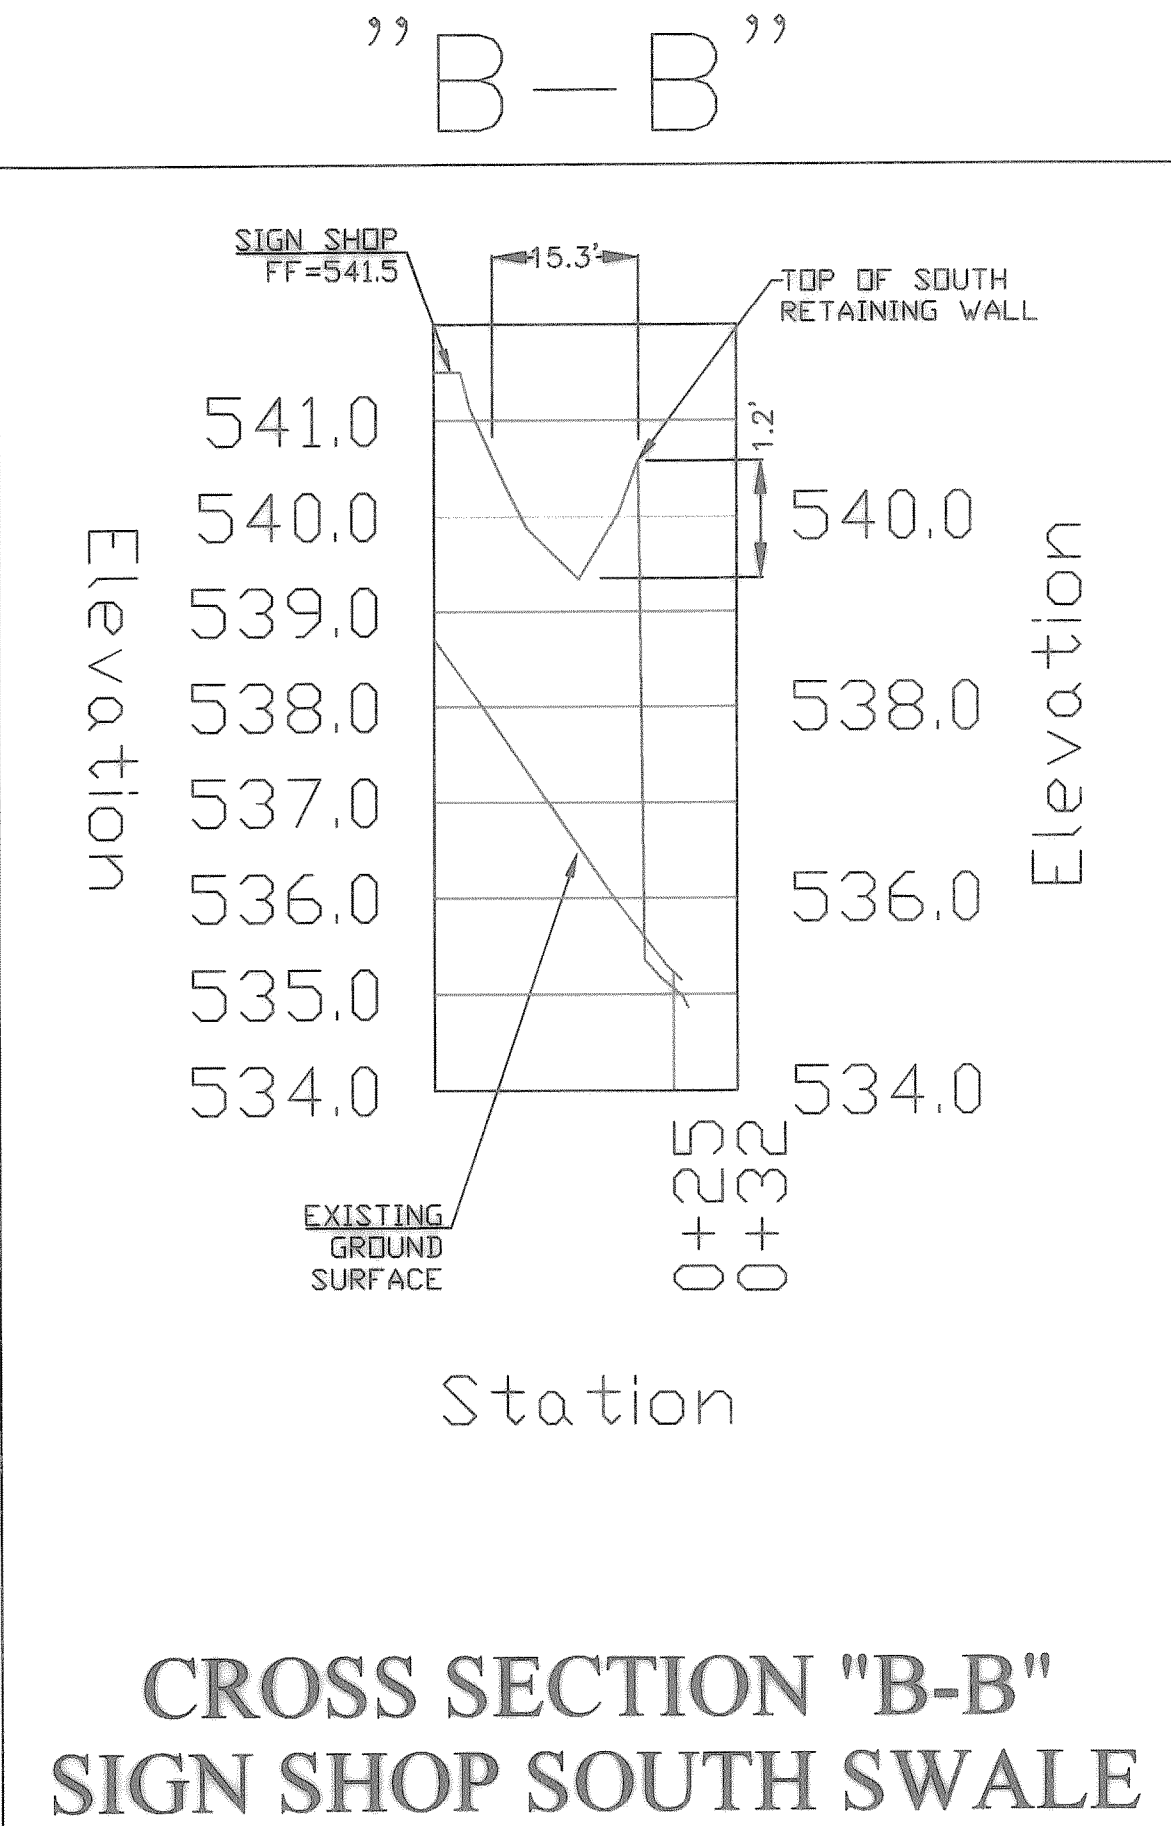

**CROSS SECTION "B-B"
SIGN SHOP SOUTH SWALE**

VERTICAL SCALE: 1" = 2'

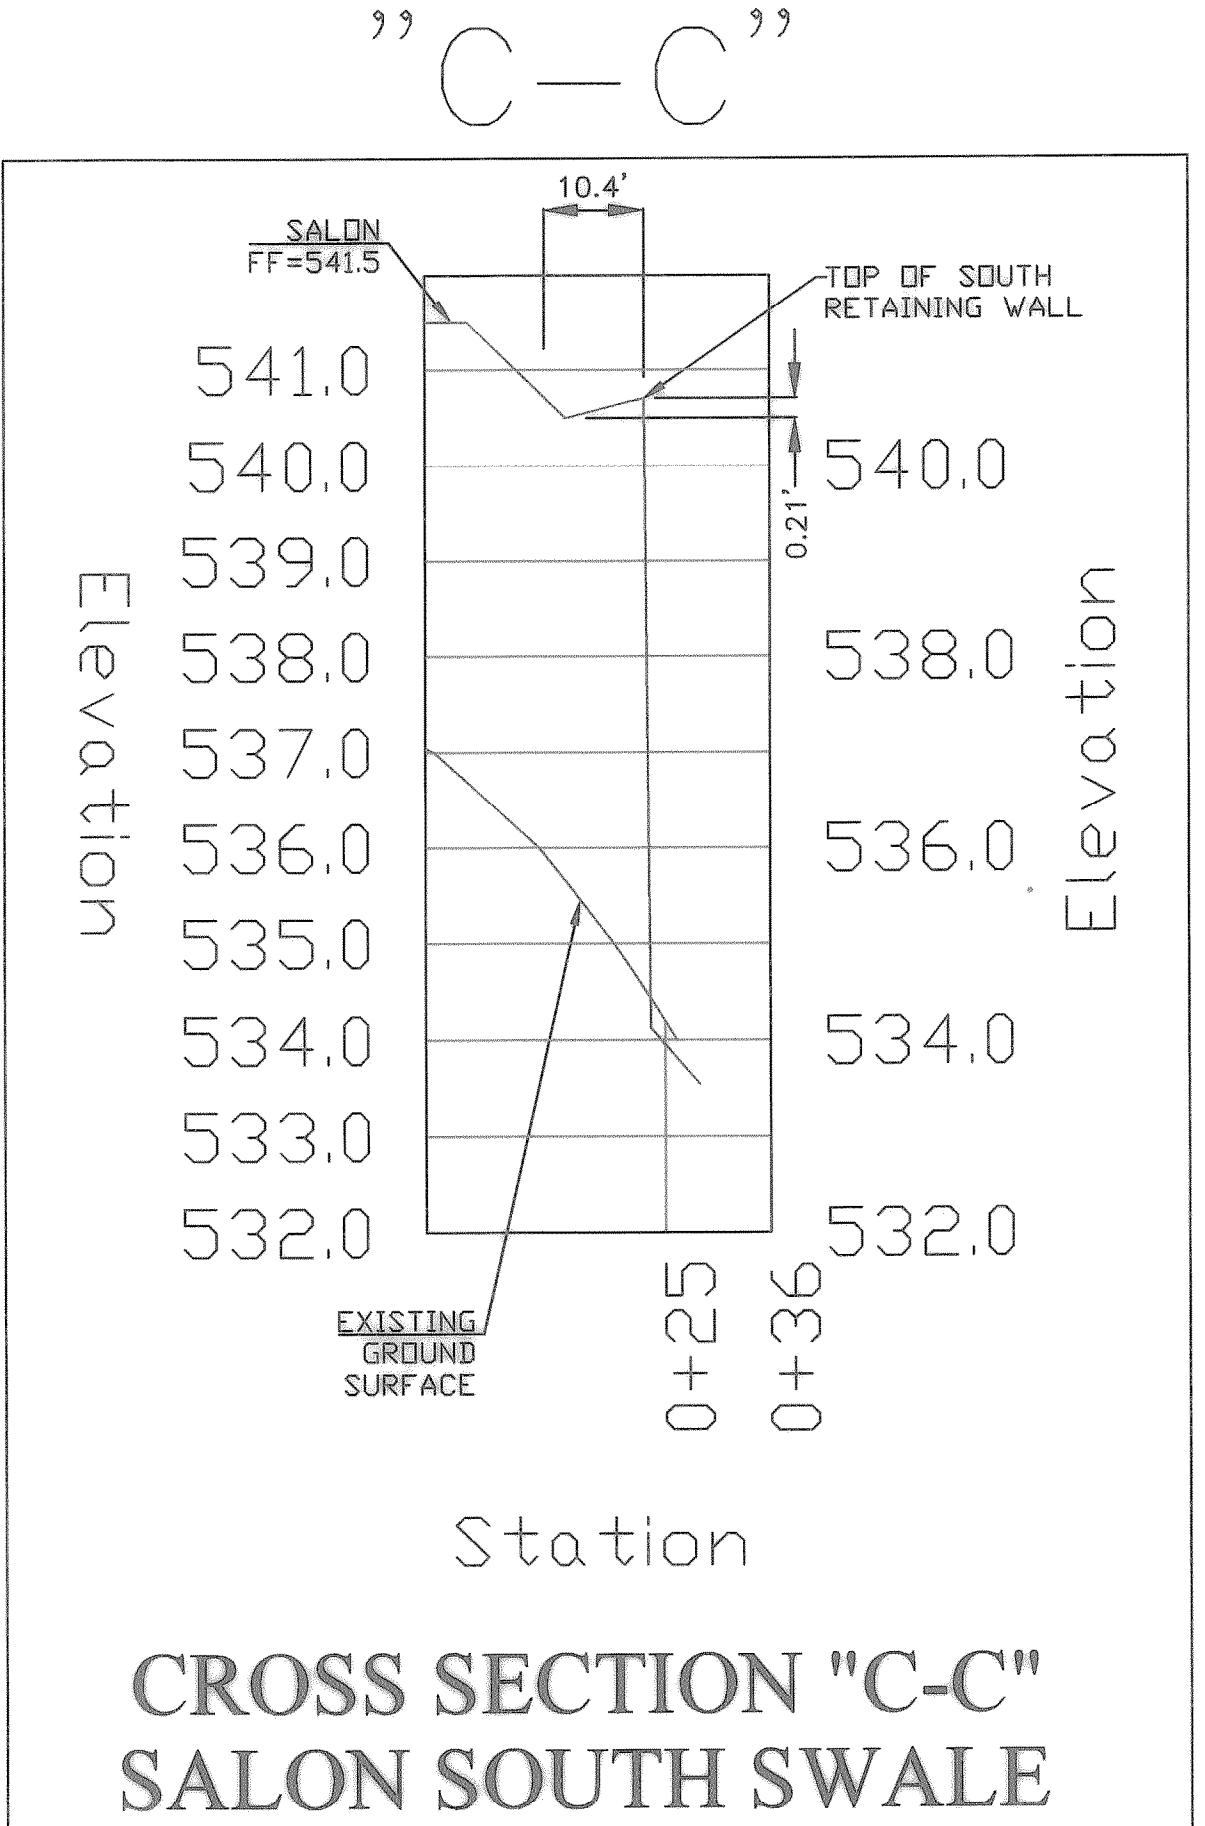


**CROSS SECTION "C-C"
SALON SOUTH SWALE**

VERTICAL SCALE: 1" = 2'

CONSTRUCTION DETAILS ARE AS OUTLINED IN THE STANDARD SPECIFICATIONS FOR PUBLIC WORKS CONSTRUCTION, NORTH CENTRAL TEXAS, THIRD EDITION AND CITY OF ROCKWALL STANDARDS OF DESIGN AND CONSTRUCTION

WELDON BROWN ENGINEERING, L.C.
 TBPE #10477
 297 WATERFORD WAY
 MONTGOMERY TEXAS 77356
 (832) 691-1581

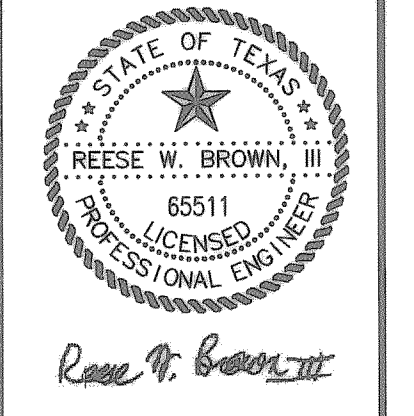

THE SEAL AND SIGNATURE APPEARING ON THIS DOCUMENT WAS AUTHORIZED BY REESE W. BROWN, III, P.E. TBPE #85511 DA 11-13-12

OWNER:
ROCKWALL SALONS, LLC
 dba SALONS ELITE
 P.O. BOX 846
 SEAGOVILLE, TX 75159

TO THE BEST OF OUR KNOWLEDGE WELDON BROWN ENGINEERING, L.C. HEREBY STATES THAT THIS PLAN IS AS-BUILT. THIS INFORMATION PROVIDED IS BASED ON SURVEYING AT THE SITE AND INFORMATION PROVIDED BY THE CONTRACTOR.

PFEFFER/INMAN ADDITION
 2 LOTS - 1.6989 ACRES
 J.D. McFARLAND SURVEY, ABSTRACT NO. 145
 CITY OF ROCKWALL, ROCKWALL COUNTY, TEXAS

SHEET TITLE:
AS-BUILT SANITARY & SWALE PROFILES

DATE: 11/13/12

C-6