


TOP VIEW

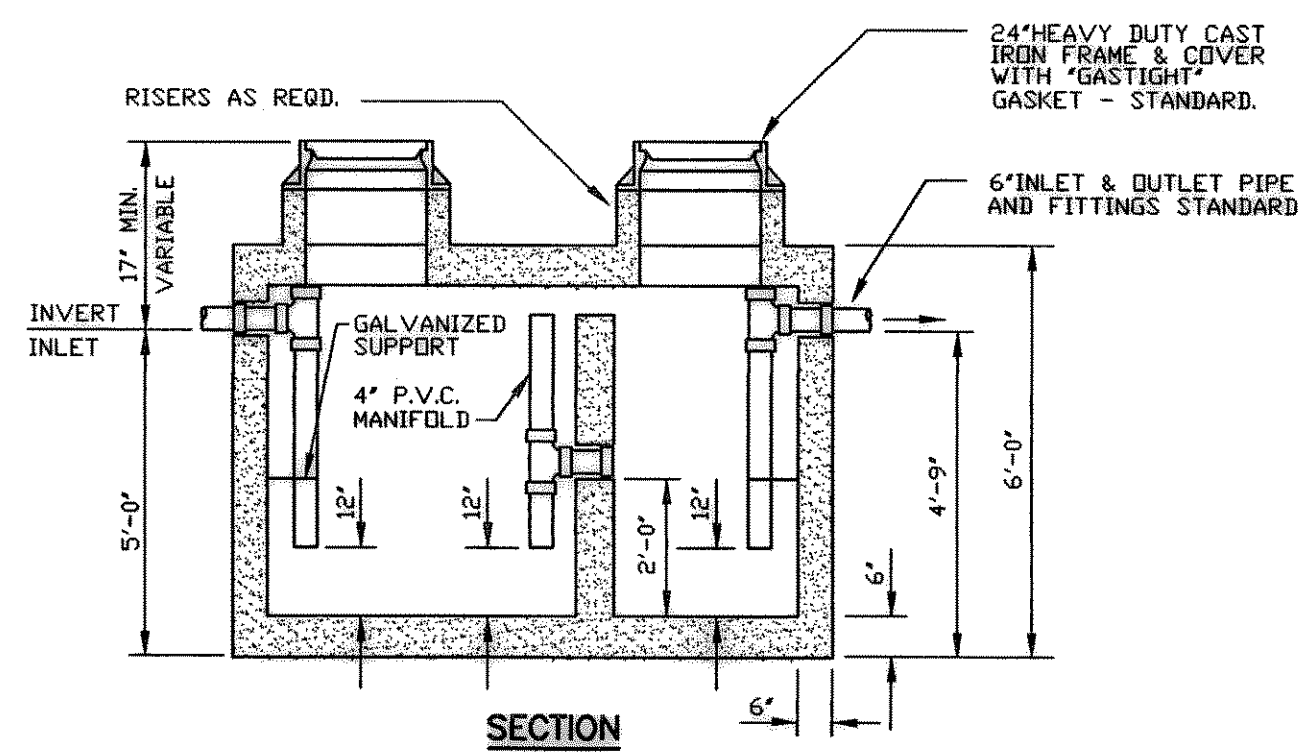


SECTION

G.T. SIZE	DIM 'A'	DIM 'B'
500 GALLON	6'-2"	4'-2"
750 GALLON	8'-1"	4'-0"
1000 GALLON	8'-2"	5'-1"


EXTERIOR GREASE TRAP

NTS

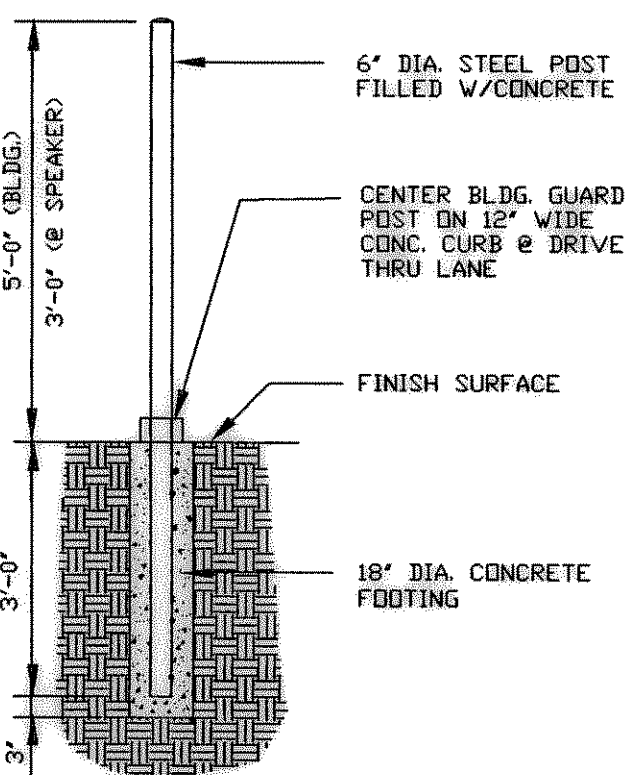


GUARD POST

NTS

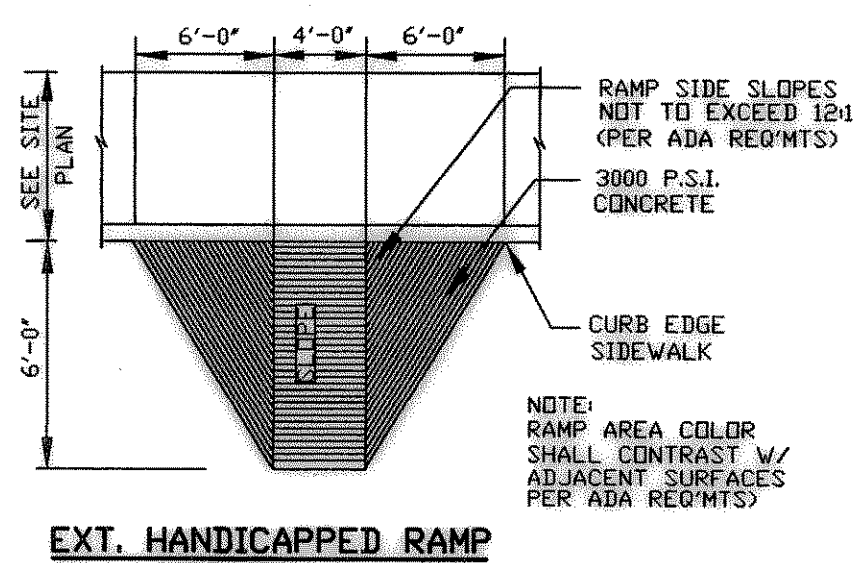

EXT. HANDICAPPED RAMP

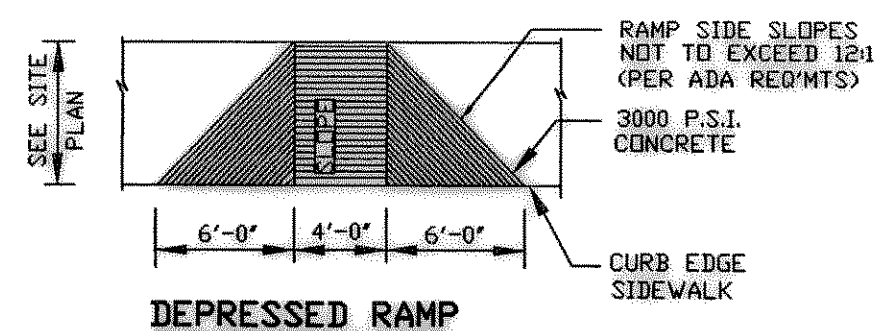

DEPRESSED RAMP

HANDICAP ACCESS RAMP

NTS

GREASE TRAP CALCULATION				
NUMBER OF MEALS PER PEAK HOUR	WASTE FLOW RATE (GAL/MEAL)	RETENTION TIME (HRS)	STORAGE FACTOR	APPROX. INTERCEPTOR SIZE (LIQUID CAPACITY)
110	2.0	1.5	3.0	90 GALLONS

SPECIFICATIONS:


CONCRETE: CLASS 1 CONCRETE WITH DESIGN STRENGTH OF 4500 PSI AT 28 DAYS.

REINFORCEMENT: GRADE 60 REINFORCED NO.4 STEEL REBAR TO CONFORM TO ASTM A615 ON REQUIRED CENTERS OR EQUAL.


MANHOLE COVERS: MANHOLE FRAMES AND COVERS SHALL BE MANUFACTURED OF GREY CAST IRON CONFORMING TO ASTM A48-76 CLASS 35. MANHOLE SHALL HAVE 24" INSIDE DIAMETER AND BE TRAFFIC DUTY.

ENGINEERING DATA:


GREASE TRAP IS STRUCTURALLY AND HYDRAULICALLY ENGINEERED AND CONFORMS TO UNIFORM PLUMBING CODE. LIQUID CAPACITY IS 1,016 GALLONS AND GREASE RETENTION IS APPROXIMATELY 2,600 POUNDS. RECOMMENDED FOR FLOW RATES UP TO 28 GALLONS PER MINUTE. FIELD EXCAVATION AND PREPARATION SHALL BE COMPLETED PRIOR TO DELIVERY OF GREASE TRAP. USE DIMENSIONAL DATA AS SHOWN.

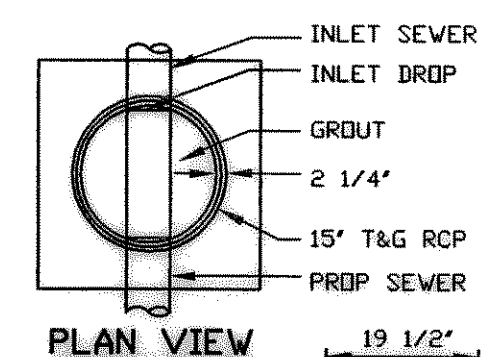

PLAN VIEW

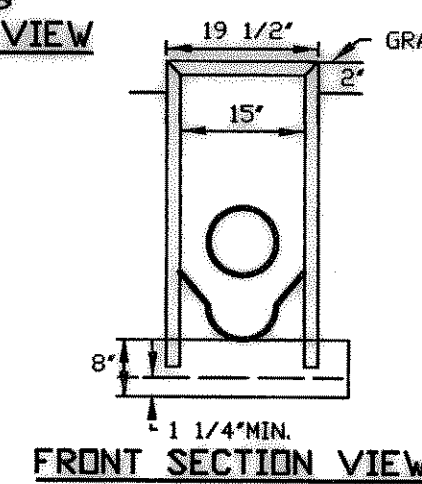

FRONT SECTION VIEW

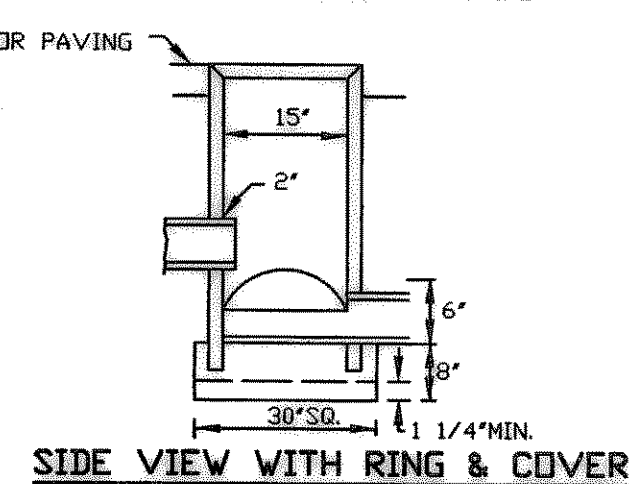


SIDE VIEW WITH RING & COVER

DUCTILE IRON FRAME & LID MANUFACTURED BY GRADE OR PAVING GRADE OR PAVING


SAMPLE WELL DETAIL

NTS

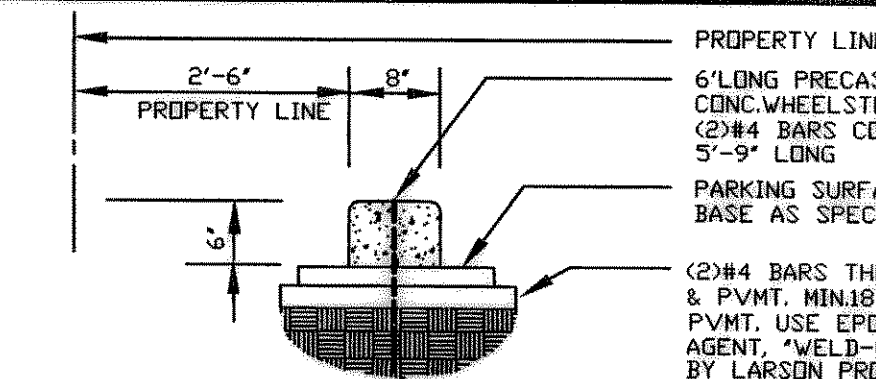

CONC. WHEEL STOP

NTS

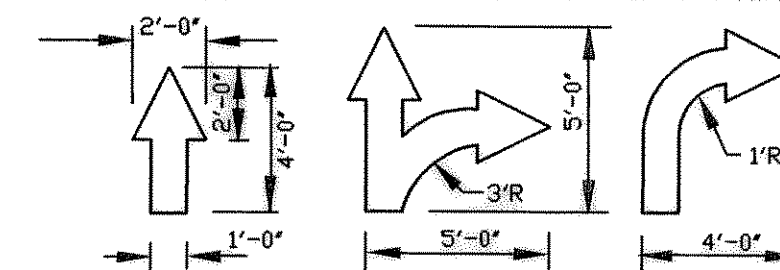


PAINTED TRAFFIC ARROWS

NTS



CONTRACTOR SHALL VERIFY ALL CONDITIONS AND DIMENSIONS AT THE JOB SITE AND NOTIFY THE ARCHITECTS OF ANY DIMENSIONAL ERRORS, OMISSIONS OR DISCREPANCIES BEFORE BEGINNING OR FABRICATING ANY WORK - DO NOT SCALE DRAWINGS.  
THESE DOCUMENTS, THE IDEAS AND THE DECISIONS INCORPORATED HEREIN, ARE THE PROPERTY OF SALTGRASS STEAK HOUSE AND ARE TO BE USED IN WHOLE OR IN PART FOR ANY OTHER PROJECT WITHOUT WRITTEN AUTHORIZATION OF SALTGRASS, INC.

SALTGRASS STEAK HOUSE  
9038 LAY FREEMAN, SUITE 250  
HOUSTON, TX 77024  
PHONE: 713-461-6611  
FAX: 713-500-2006

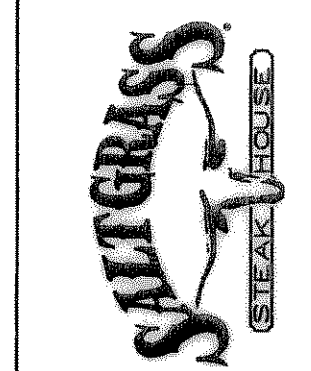

CONSTRUCTION DETAILS  
SALT GRASS STEAK HOUSE  
IH-30 @ HORIZON ROAD  
ROCKWALL, TEXAS

ASA ENGINEERING  
1916 DUNDON, SUITE 210  
DALLAS, TEXAS 75246  
PHONE: (972) 246-1881  
FAX: (972) 246-1881

REVISION	DESCRIPTION	DATE
1	ISSUE FOR PERMIT	7/19/00
2	ISSUE FOR CONSTRUCTION	7/19/00
3	ISSUE FOR BIDDING	7/19/00
4	ISSUE FOR CONSTRUCTION	7/19/00
5	ISSUE FOR CONSTRUCTION	7/19/00
6	ISSUE FOR CONSTRUCTION	7/19/00
7	ISSUE FOR CONSTRUCTION	7/19/00
8	ISSUE FOR CONSTRUCTION	7/19/00
9	ISSUE FOR CONSTRUCTION	7/19/00
10	ISSUE FOR CONSTRUCTION	7/19/00

ISSUE DATE: 7/19/00  
ISSUED FOR: PERMIT  
ADA  
BID  
CONST.  
DRAWN BY: MIR ALI  
CHECKED BY:  
SG O.C. BY:  
DATE:  
VERSION: