
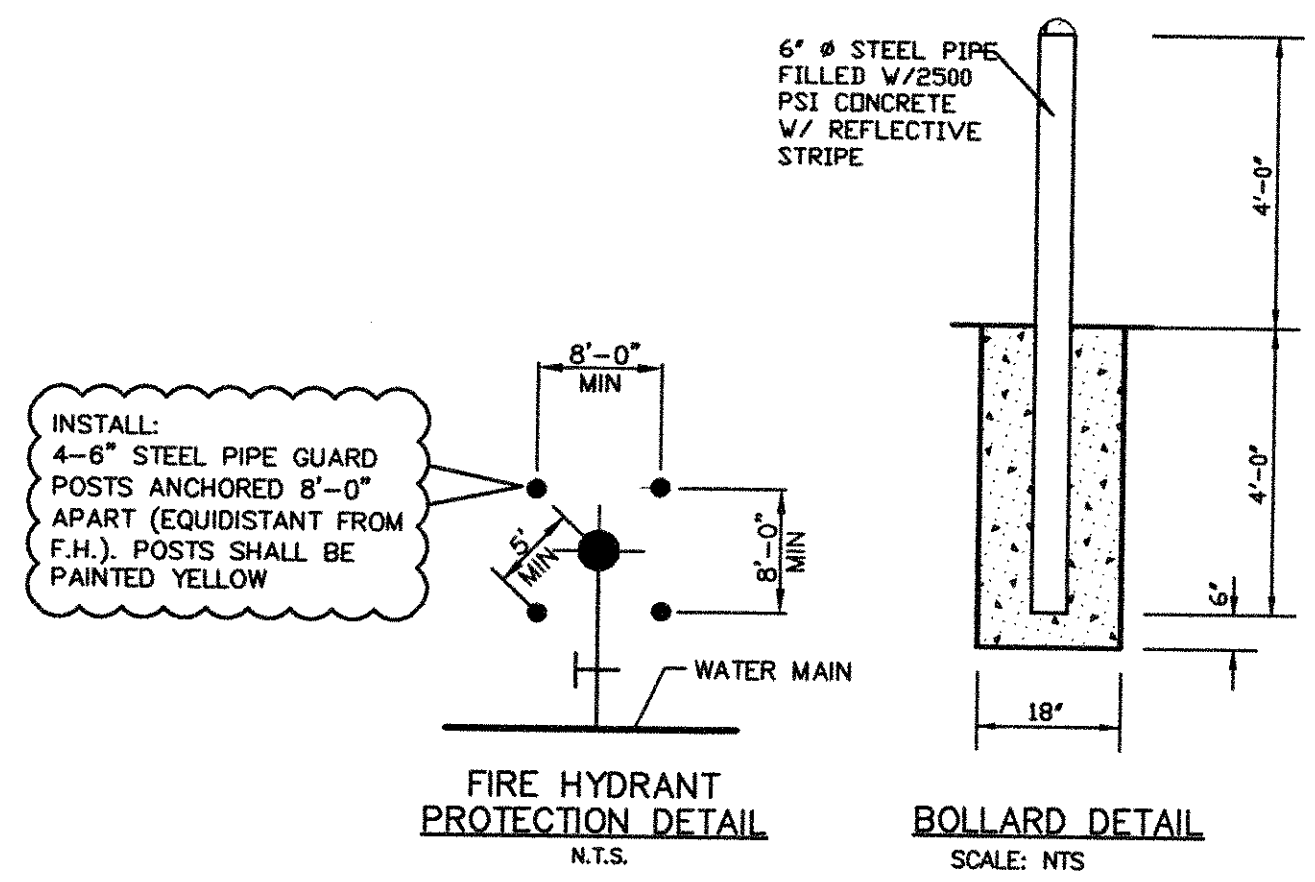
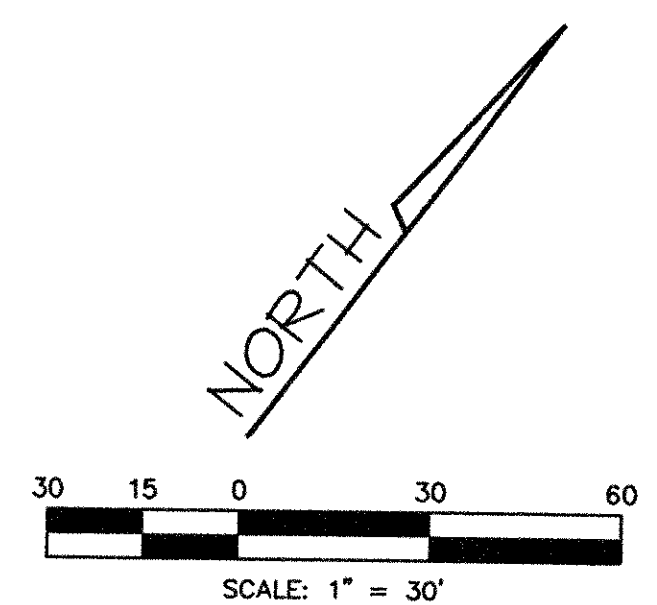


WATER PLAN
SHENANIGANZ
CITY OF ROCKWALL, TEXAS

RECORD DRAWING

No.	Date	Revision
1	7/07/08	REVISED PER CITY COMMENTS
1	6/12/08	REVISED PER CITY COMMENTS

Scale: 1"=30'
File Name: SGSITE
Date: APRIL 2008
Project No.: 28110

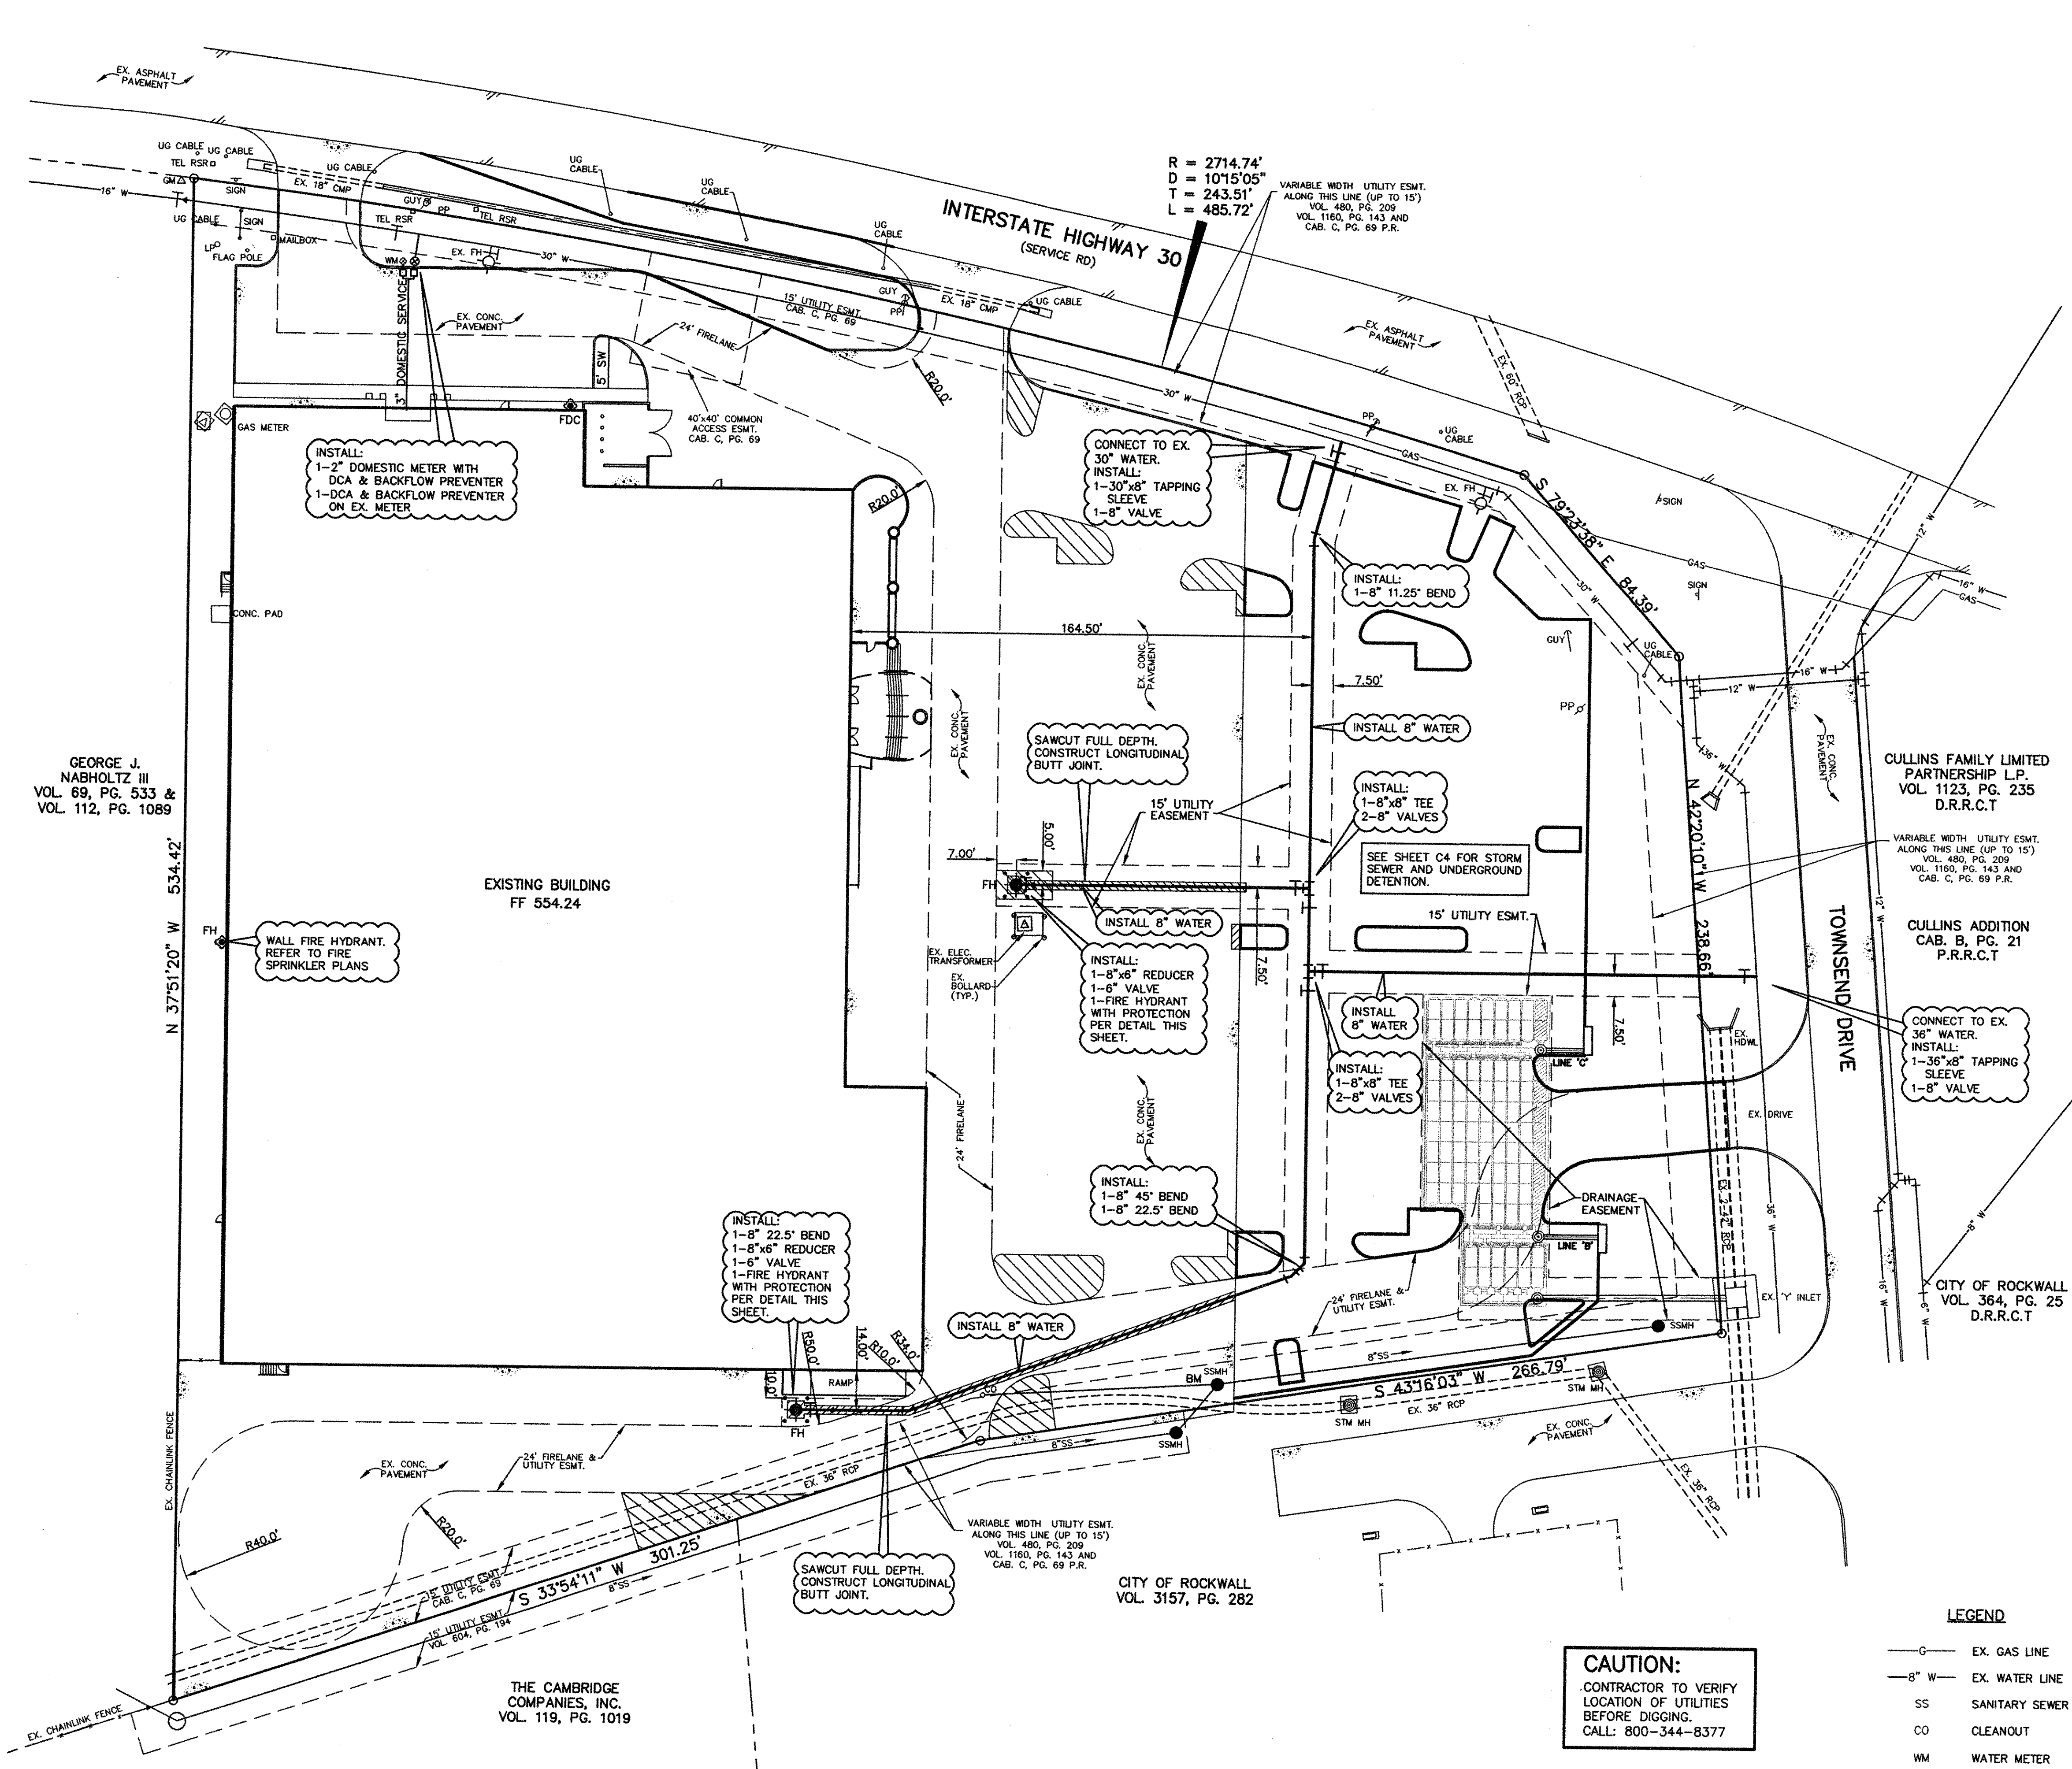

BENCHMARK: CENTER RIM OF EXISTING SANITARY SEWER MANHOLE LOCATED ON THE NORTHEAST CORNER OF EXISTING PARKING LOT AND 180± SOUTH OF THE NORTHEAST PROPERTY CORNER.
ELEV. 545.99

RECORD DRAWING

IMPROVEMENTS INDICATED ON THESE PLANS WHERE REVISED IN ACCORDANCE WITH THE ASBUILT SURVEY PERFORMED BY LANE'S SOUTHWEST SURVEYING, INC. AND PROVIDED TO BENTLEY ENGINEERING, INC. ON 12/03/08.
DATE: DECEMBER 3, 2008