




CURVE	RADIUS	LENGTH	TANGENT	CHORD	BEARING	DELTA
C1	80.00'	51.09'	26.45'	50.22'	S80°23'25" W	36°35'13"
C2	50.00'	44.51'	23.85'	43.05'	S02°24'12" E	51°00'00"
C3	100.00'	63.86'	33.06'	62.78'	S80°23'25" W	36°35'13"
C4	20.00'	36.74'	24.86'	31.17'	S66°42'59" E	102°22'25"
C5	37.50'	17.53'	8.93'	17.37'	S02°08'17" E	28°47'00"
C6	62.50'	20.18'	10.17'	20.07'	S13°51'27" W	18°28'42"
C7	20.00'	23.71'	13.47'	22.35'	N28°08'06" E	67°55'25"
C8	78.50'	36.17'	17.88'	34.87'	S12°27'50" E	25°40'07"
C9	71.50'	28.07'	14.22'	27.88'	S77°20'32" W	22°28'27"

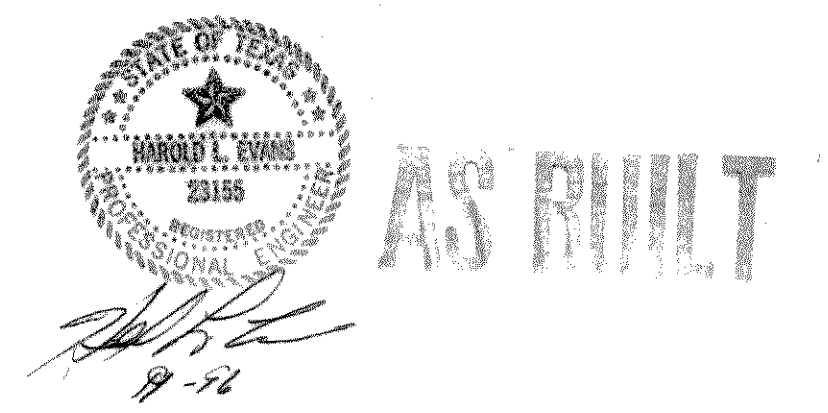

38,585 S.F.  
0.8858 ACRES

HAROLD L. EVANS CONSULTING ENGINEER P.O. BOX 28365 2331 CUS THOMASSON ROAD, SUITE 102 DALLAS, TEXAS 75228, (214) 328-8133		DIMENSION CONTROL SIGNAL RIDGE NO. 4 PHASE 1 CITY OF ROCKWALL		SHEET NO. 9595
REVISION DESCRIPTION 959501M	DATE 8/12/96	SCALE 1" = 20'	DESIGN H.L.E.	DRAWN
ADDED PARKING OFF ENTRANCE REV.	9/28/96 9/6/98			