


NOTE:  
 TO THE BEST OF OUR KNOWLEDGE ERIC L. DAVIS ENGINEERING, INC., HEREBY STATES  
 THAT THIS PLAN IS AS-BUILT. THE INFORMATION PROVIDED IS BASED ON SURVEYING  
 CONDUCTED AT THE SITE AND INFORMATION PROVIDED BY THE CONTRACTOR.

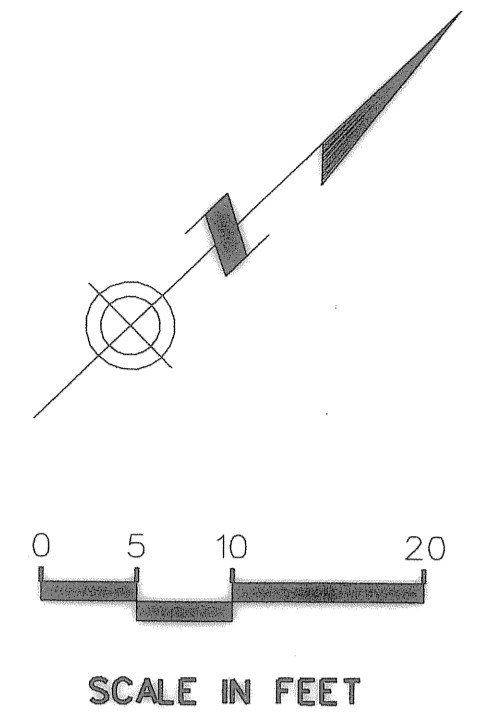


CITY OF ROCKWALL TO SUPPLY WATER  
 METER. CONTRACTOR TO SUPPLY AND  
 INSTALL METER CAN AND TAP.

DOUBLE CHECK VALVE  
 WITH BACKFLOW PREVENTER  
 TYPICAL ALL WATER SERVICES

OFFICE BUILDING  
 APPROX. 6,000 SQ. FT.

DATE	BY	REV	REVISION

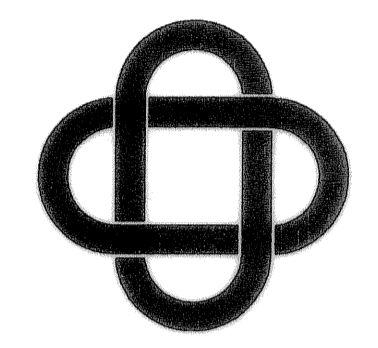


ERIC L. DAVIS  
 ENGINEERING, INC.  
 425 Pinson Road Ste. G  
 Forney, Texas 75126  
 972/564-0592 Fax 972/564-6623  
 E-Mail ericdavis@eldengineering.com

**UTILITY PLAN**  
**SHORELINE PLAZA**  
**CITY OF ROCKWALL, ROCKWALL CO, TEXAS**

DEVELOPER:	
JOB NO.:	
DRAWN BY:	
CHECKED BY:	
DATE:	

AS-BUILT

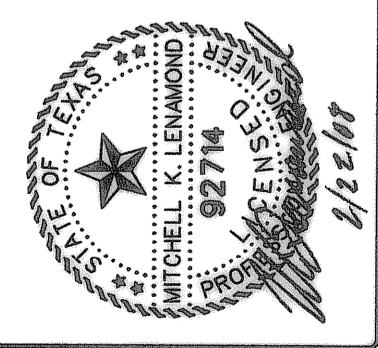

SCALE: 1"=10'

SHEET 11 OF 14

SHEET 11

Shoreline\_Plaza\_11\_Utility\_Plan.sht  
 PLOTTED BY: David  
 2/22/2008 10:29:30 AM

