

GRAPHIC SCALE



(IN FEET)
1 inch = 30 feet




THE SEAL APPEARING ON THIS DOCUMENT WAS AUTHORIZED BY W.L. DOUPHRATE, INC. NO. 60102 ON 7/88

DOUPHRATE & ASSOCIATES, INC.
2235 RIDGEWAY # 200 ROCKWALL, TEXAS 75087
PH: 972-968-1700 FAX: 972-968-1705

DRAINAGE AREA MAP
SHORELINE PLAZA ADDITION
CITY OF ROCKWALL
ROCKWALL COUNTY, TEXAS

1. REVISED AS PER CITY OF ROCKWALL MARK-UPS. REV. 6/20/00

REVISION
W.L.D. CHECKED
K.E.B. DRAWN
4/21/00 DATE
9957 DAM PROJECT

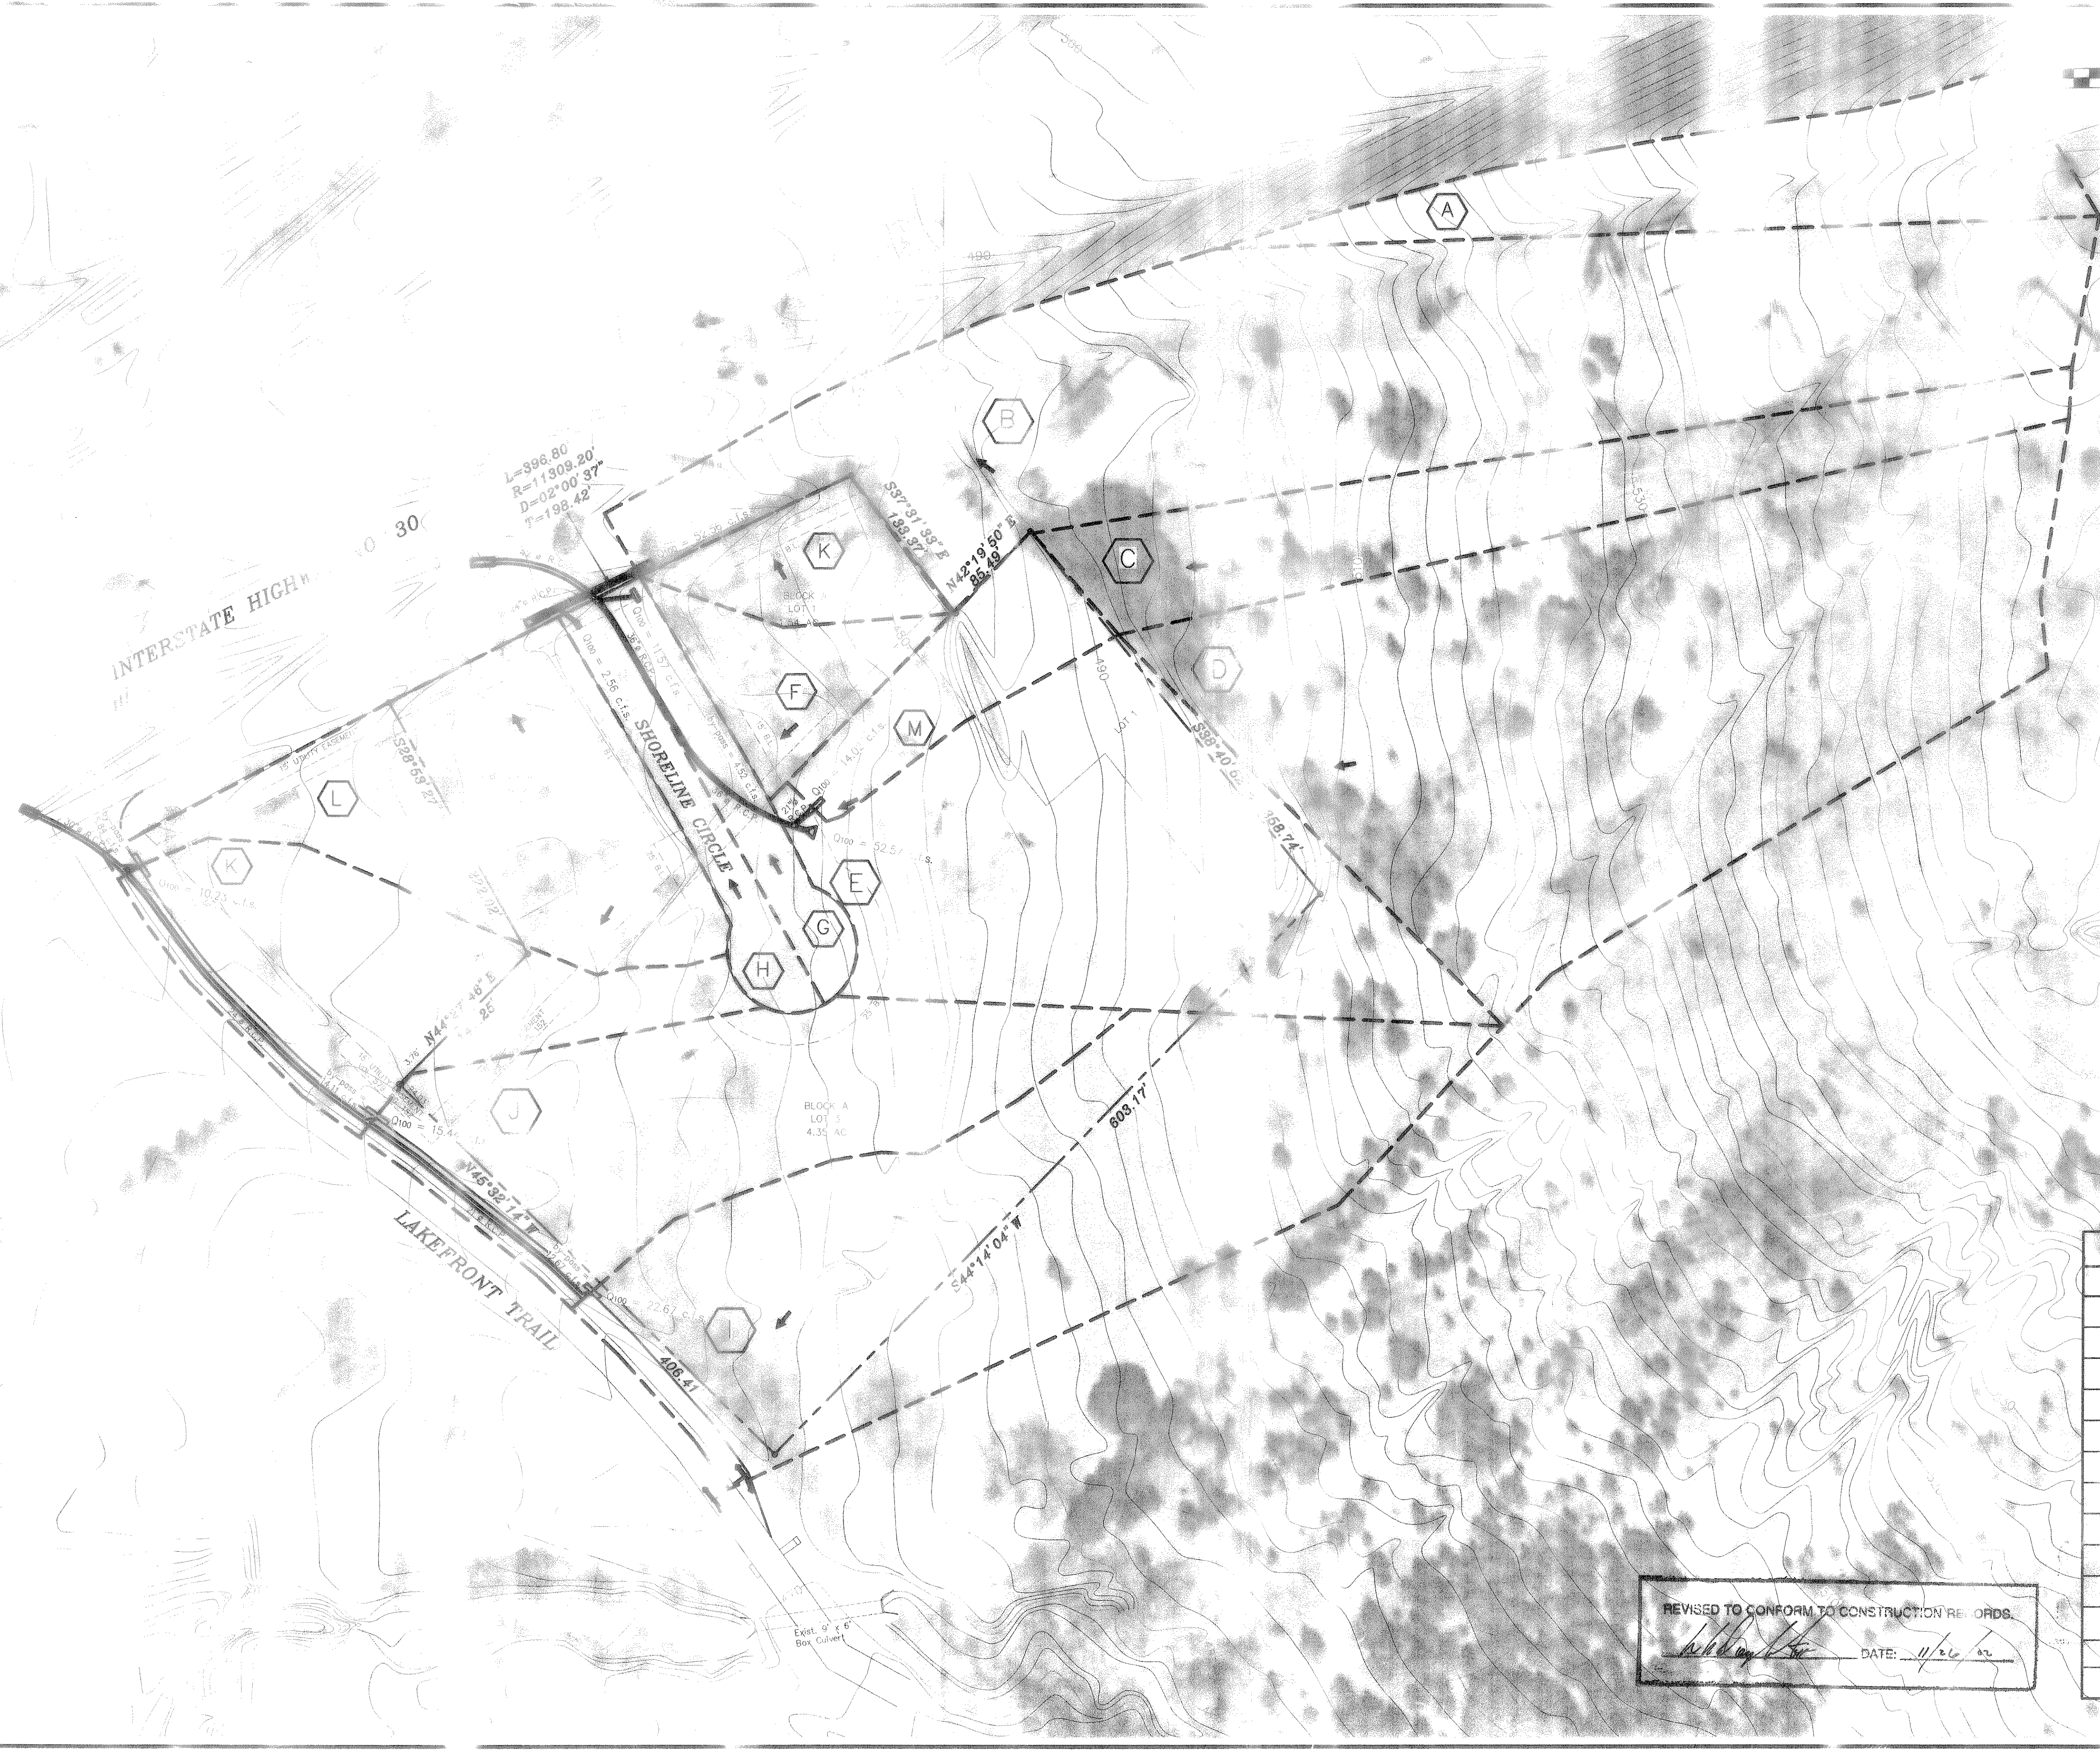

| DRAINAGE TABLE | | | | | |
|----------------|-------|-----|----|------------------|------------------|
| AREA | ACRES | C | Tc | I ₁₀₀ | Q ₁₀₀ |
| A | 0.98 | 0.9 | 10 | 9.80 | 8.64 |
| B | 0.82 | 0.9 | 10 | 9.80 | 8.64 |
| C | 1.15 | 0.9 | 10 | 9.80 | 10.14 |
| D | 3.89 | 0.9 | 10 | 9.80 | 34.31 |
| E | 2.07 | 0.9 | 10 | 9.80 | 18.26 |
| F | 0.49 | 0.9 | 10 | 9.80 | 4.32 |
| G | 0.31 | 0.9 | 10 | 9.80 | 2.73 |
| H | 0.29 | 0.9 | 10 | 9.80 | 2.63 |
| I | 2.57 | 0.9 | 10 | 9.80 | 22.77 |
| J | 1.75 | 0.9 | 10 | 9.80 | 15.64 |
| K | 0.16 | 0.9 | 10 | 9.80 | 1.43 |
| L | 1.37 | 0.9 | 10 | 9.80 | 12.08 |
| M | 0.44 | 0.9 | 10 | 9.80 | 3.89 |

REVISED TO CONFORM TO CONSTRUCTION RECORDS.
DATE: 11/26/02