


REVISED TO CONFORM TO CONSTRUCTION RECORDS.
 DATE: 1/26/00

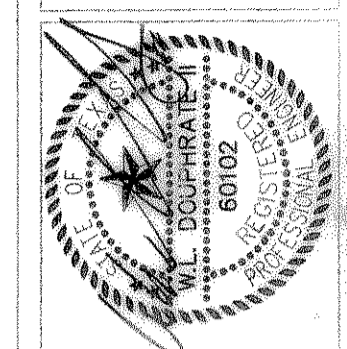

THE SEAL APPEARING ON THIS DOCUMENT WAS AUTHORIZED BY W.L. DOUPHRATE IN TEXAS P.E. NO. 60107 ON 11/14/00

DOUPHRATE & ASSOCIATES, INC.
 ENGINEERING - PROJECT MANAGEMENT - SURVEYING
 2295 RIDGE RD. # 200 ROCKWALL, TEXAS 75087
 PHONE: (972)771-9004 FAX: (972)771-9005

GRADE TO DRAIN & CROSS SECTIONS
 THE OAR HOUSE
 CITY OF ROCKWALL
 ROCKWALL, ROCKWALL COUNTY, TEXAS

REVISION	W.L.D.
CHECKED	K.E.B.
DRAWN	4/20/2000
DATE	9957GTD1
PROJECT	