



CURVE TABLE

CURVE	DELTA	RADIUS	TANGENT	ARC LENGTH
1	22°34'03"	200.00	39.90	78.77
2	25°07'30"	638.00	142.17	279.77
3	12°35'06"	662.00	73.00	145.41

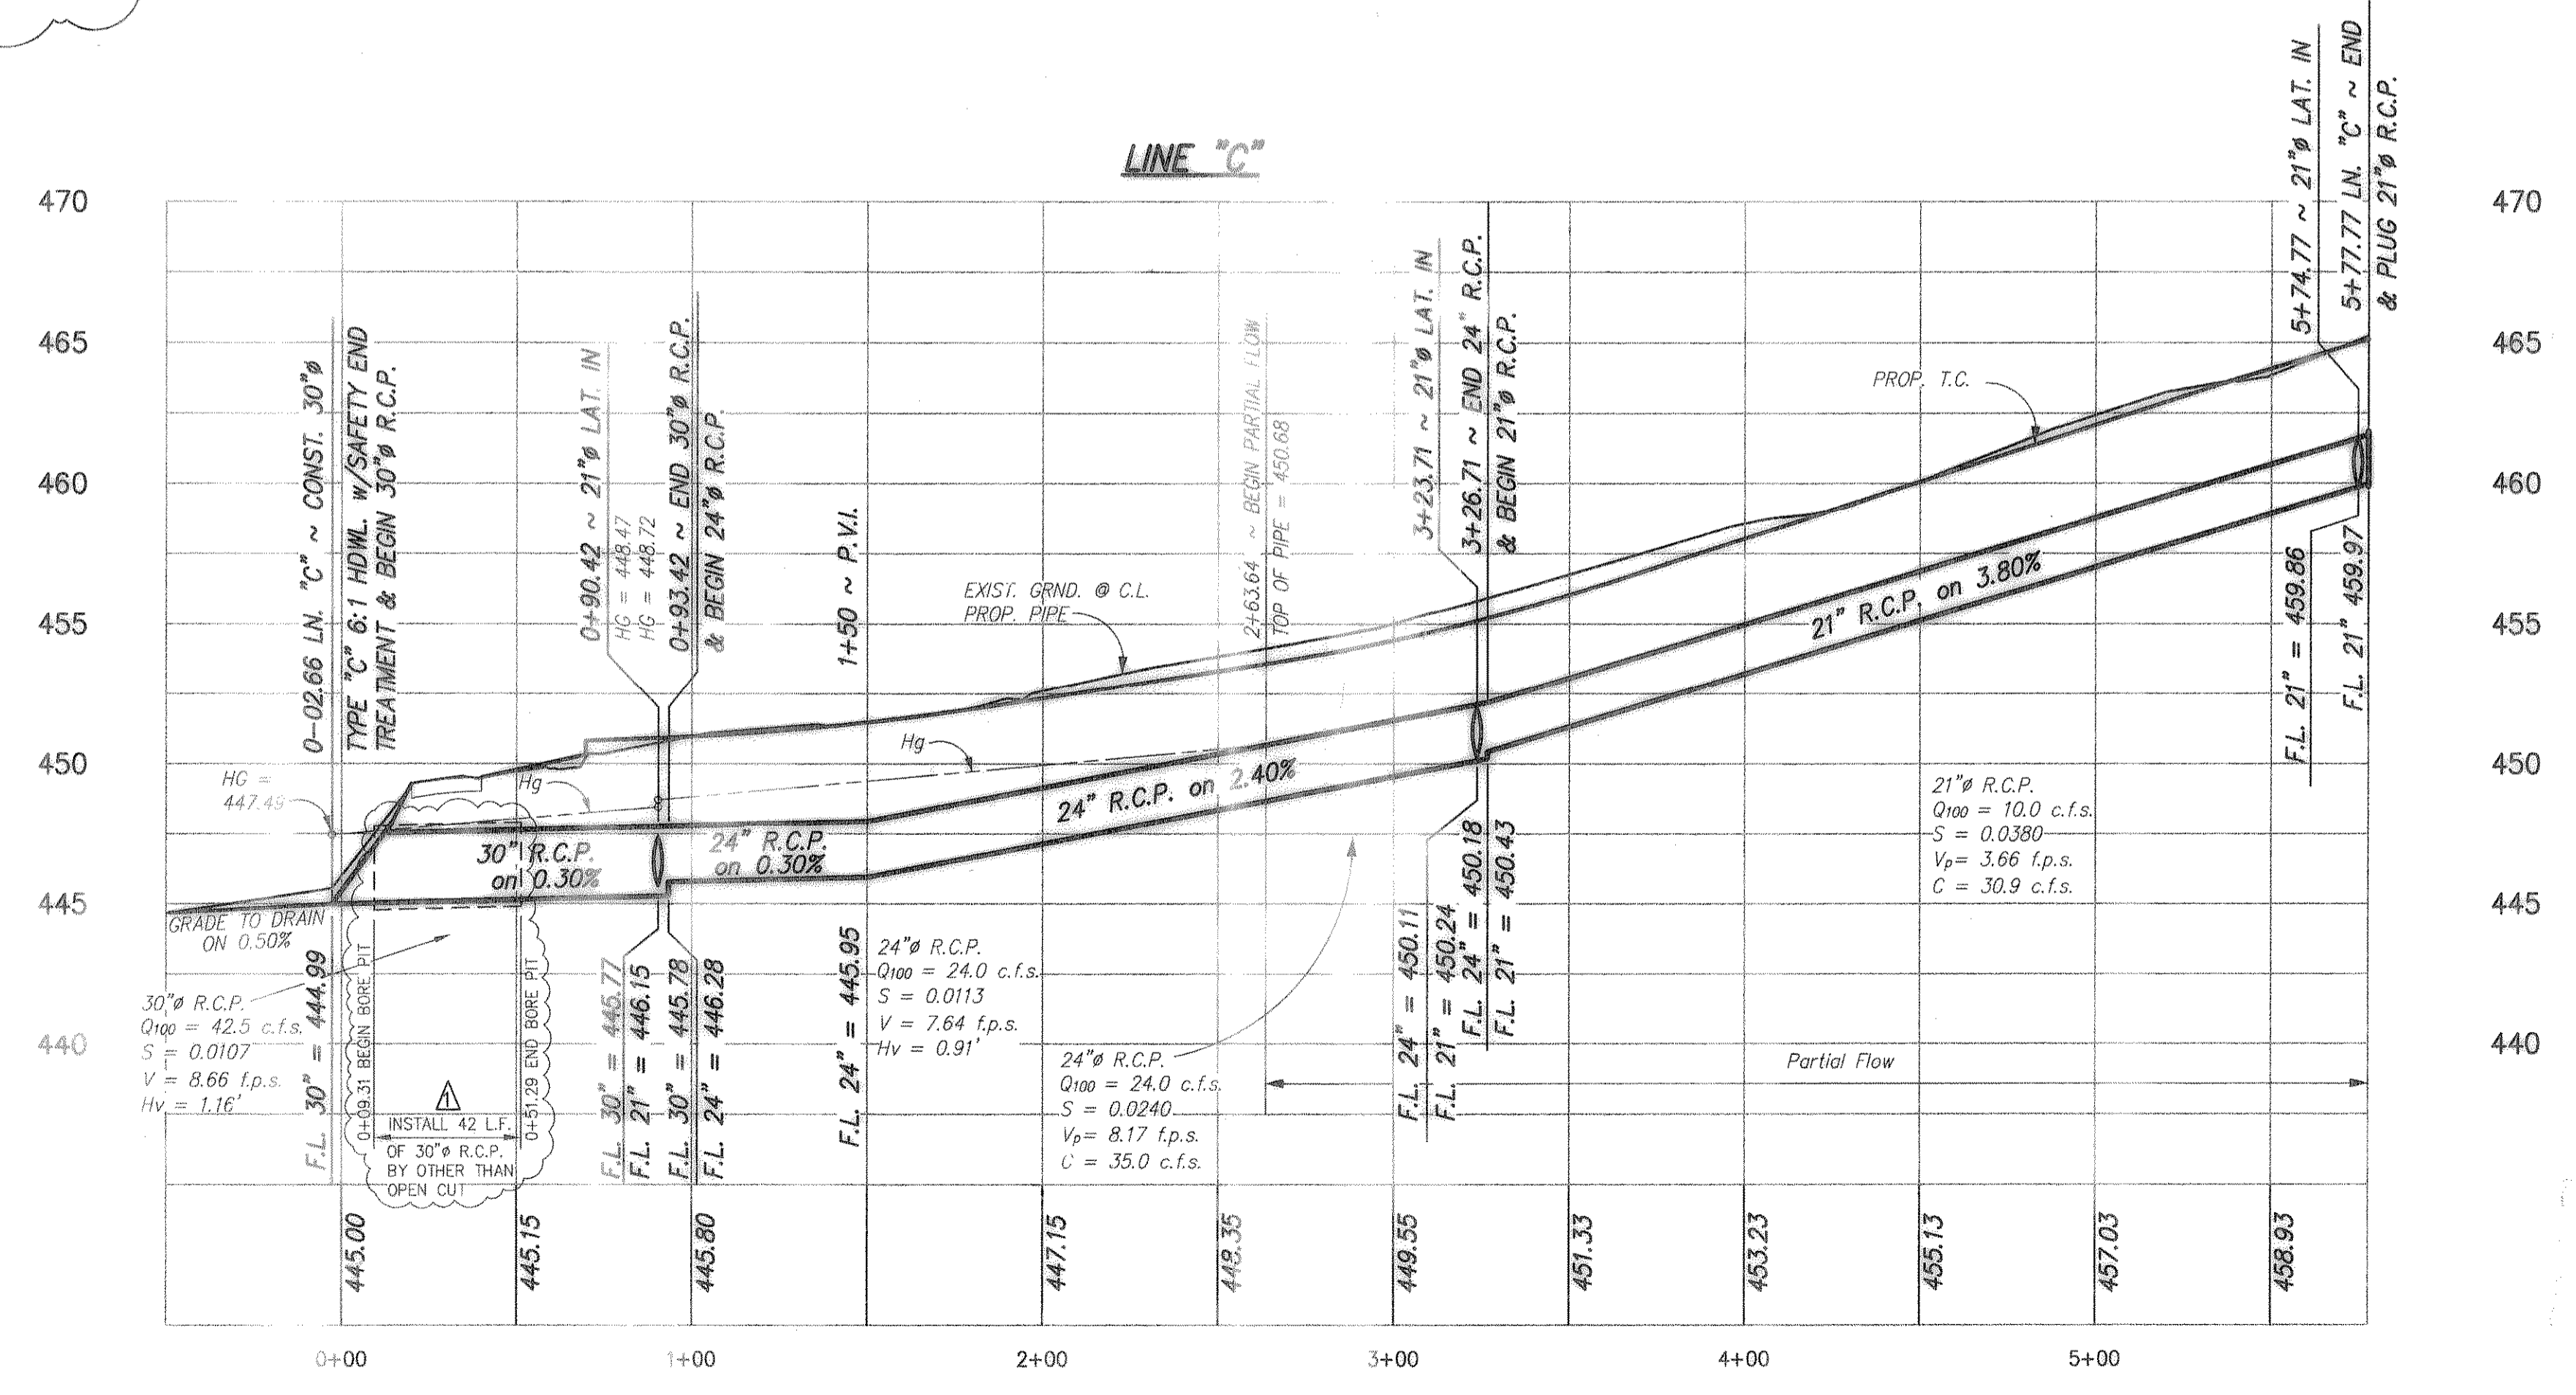

REVISED TO CONFORM TO CONSTRUCTION RECORDS.
 DATE: 4/24/00

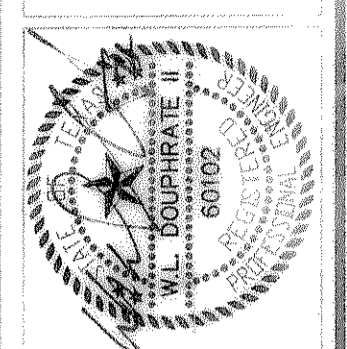

THE SEAL APPEARING ON THIS DOCUMENT WAS AUTHORIZED BY THE BOARD OF ENGINEERING EXAMINERS, STATE OF TEXAS, P.E. NO. 60102 ON 10/29/00

DOUPHRATE & ASSOCIATES, INC.
 ENGINEERS • PROJECT MANAGEMENT • SURVEYING
 2236 RIDGE RD., # 200 ROCKWALL, TEXAS 75087
 PHONE: (972)771-6004 FAX: (972)771-9005

STORM DRAINAGE PLAN & PROFILE
LAKEFRONT TRAIL
SHORELINE PLAZA ADDITION
 CITY OF ROCKWALL, ROCKWALL COUNTY, TEXAS

REVISION

10/20/00	W.L.D.
	CHECKED
	B.W.H.
	DRAWN
4/13/2000	DATE
9957STM2	PROJECT