

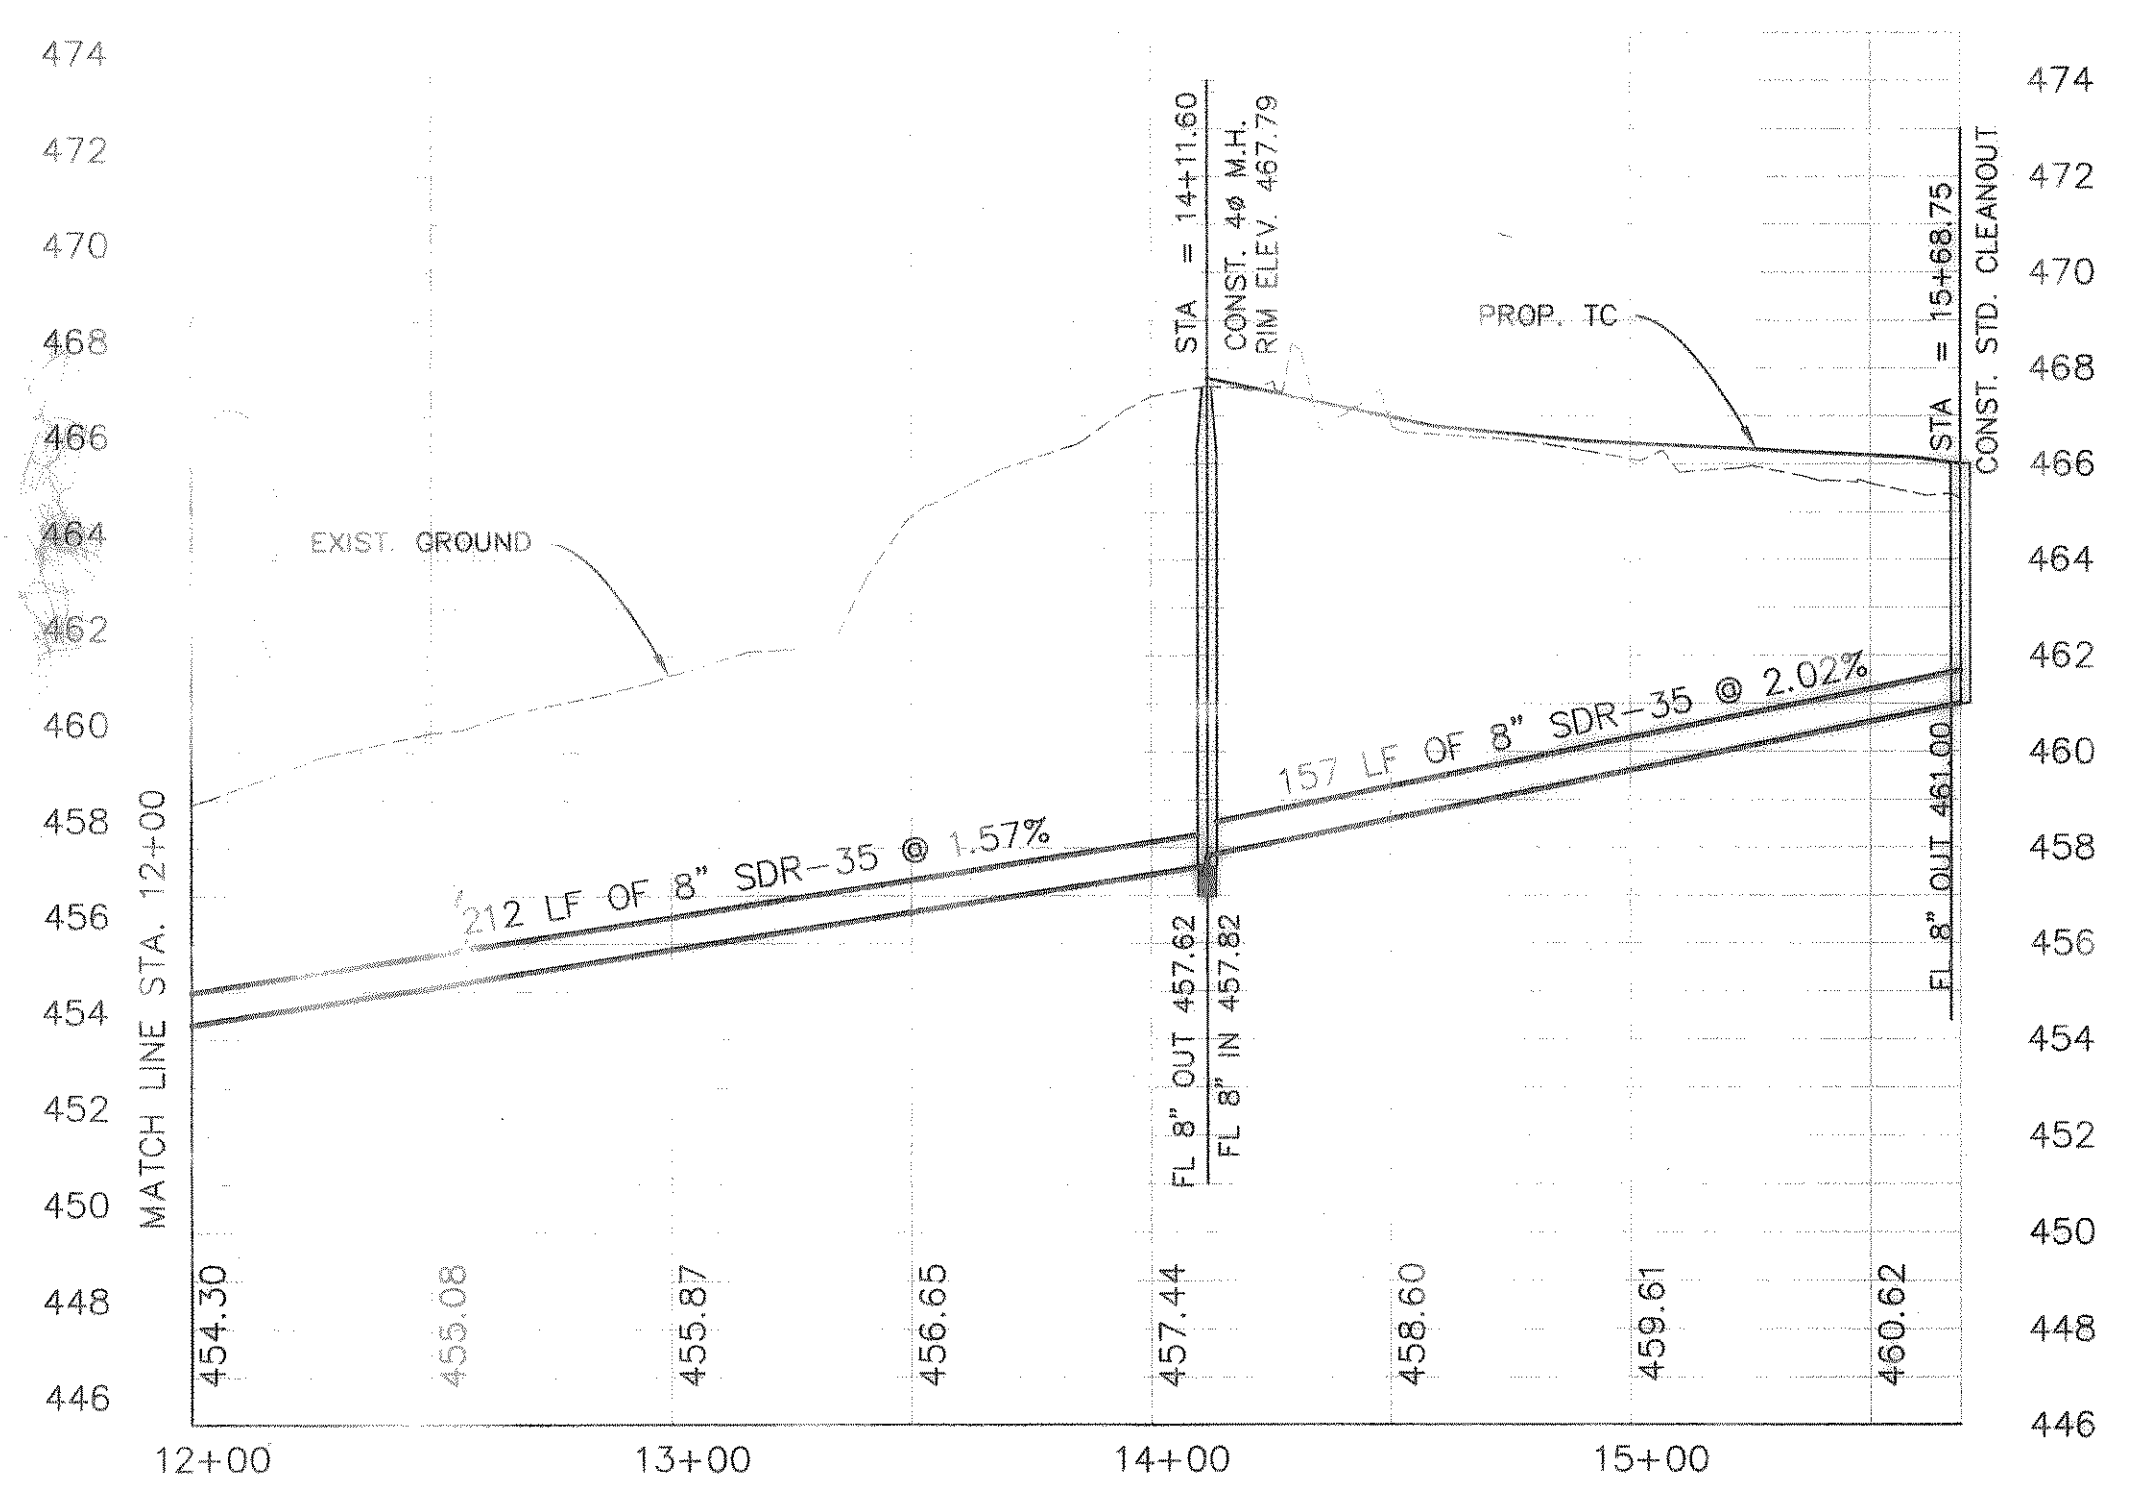



SANITARY SEWER A

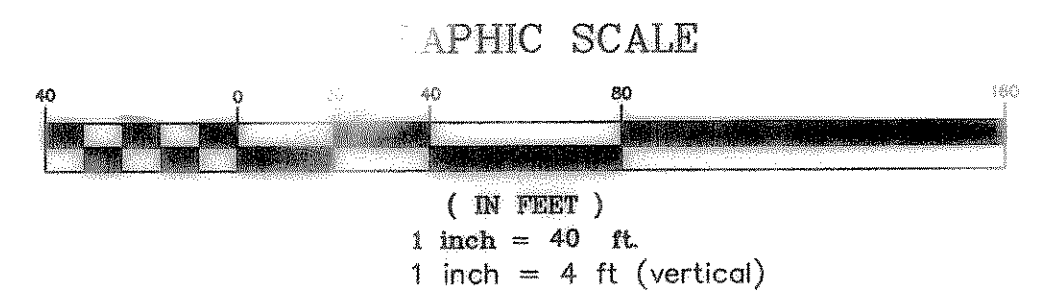

SANITARY SEWER B

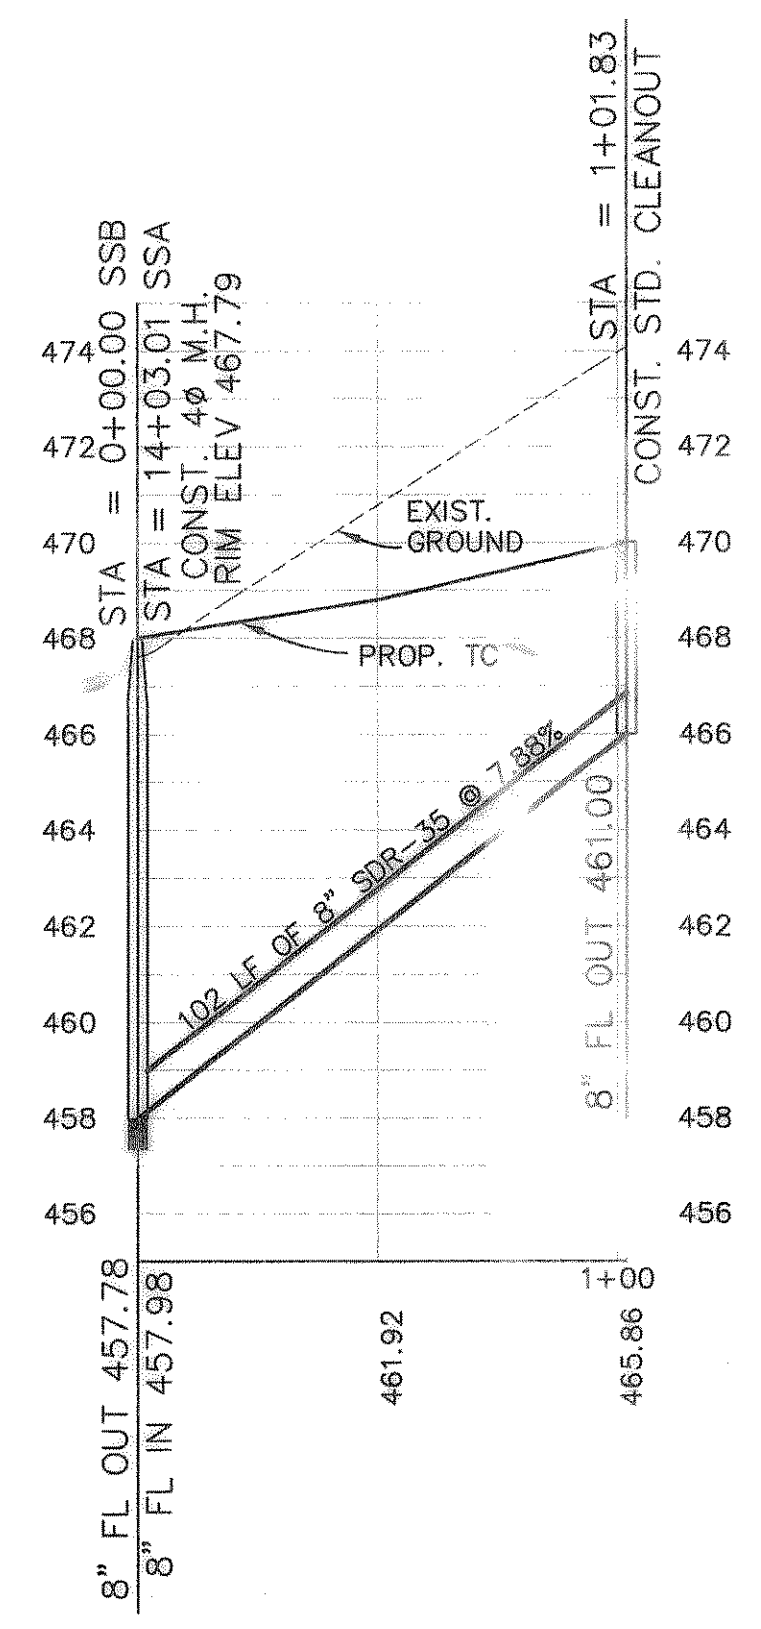

REVISED TO CONFORM TO CONSTRUCTION RECORDS.
 DATE: 11/26/01

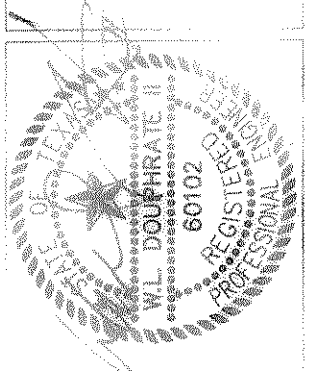

THE SEAL APPEARING ON THIS DOCUMENT WAS AUTHORIZED BY W.L. DOUPHRATE, P.E. NO. 80102 ON 8/14/00

DOUPHRATE & ASSOCIATES, INC.
 ENGINEERING - PROJECT MANAGEMENT - SURVEYING
 22345 RIDGE RD., # 200 ROCKWALL, TEXAS 75087
 PHONE: (972)771-9004 FAX: (972)771-9006

SANITARY SEWER PROFILES
 LINES A & B
 SHORELINE PLAZA
 CITY OF ROCKWALL, ROCKWALL COUNTY, TEXAS

1. REVISED AS PER CITY OF ROCKWALL REVISIONS. 7/24/00

REVISION	W.L.D.
CHECKED	A.J.W.
DRAWN	4/20/2000
DATE	9957SSPI
PROJECT	