


BENCHMARK:  
BRASS DISK IN CONC. MONUMENT, IN MEDIAN  
OF NORTH LAKESHORE DRIVE 150' ± NORTH OF  
ALAMO DRIVE (CITY OF ROCKWALL MONUMENT # 10).  
ELEV. 524.62

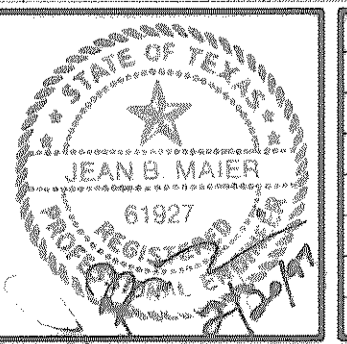

revisions	date
REVISED PER CITY REVIEW - NEW SHEET	1/17/97
REVISED PER CITY REVIEW # 2	2/14/97

**NDM**  
NATHAN D. MAIER  
CONSULTING ENGINEERS, INC.  
Three Northpark / 8800 N. Central Expwy. / Suite 300  
Dallas, Texas 75231 / (214) 738-4741

**RECORD DRAWING**  
DATE: 1/17/97  
THIS RECORD DRAWING HEREIN REFLECTS TO THE BEST OF THE DESIGN ENGINEER'S KNOWLEDGE THE APPROXIMATE LOCATION OF THE CONSTRUCTED WORK USING INFORMATION AS PROVIDED BY THE CONTRACTOR(S).

**PAVING PROFILES**  
CRESTHILL CIRCLE  
CRESTVIEW PH. 1 & HILLSIDE PH. 1  
THE SHORES  
CITY OF ROCKWALL, ROCKWALL COUNTY, TEXAS

design	drawn	scale	date	notes	job number
MM	LJM	1" = 40' H 1" = 5' V	H7-97	E-PAV-3	95-05-036E

E:\9505036E\SHS\VE-PAV3.mxd Feb 19 16:38:51 1997 LJM