


BENCHMARK:
BRASS DISK IN CONC. MONUMENT, IN MEDIAN
OF NORTH LAKESHORE DRIVE 150' ± NORTH OF
ALAMO DRIVE (CITY OF ROCKWALL MONUMENT # 10).
ELEV.: 524.62

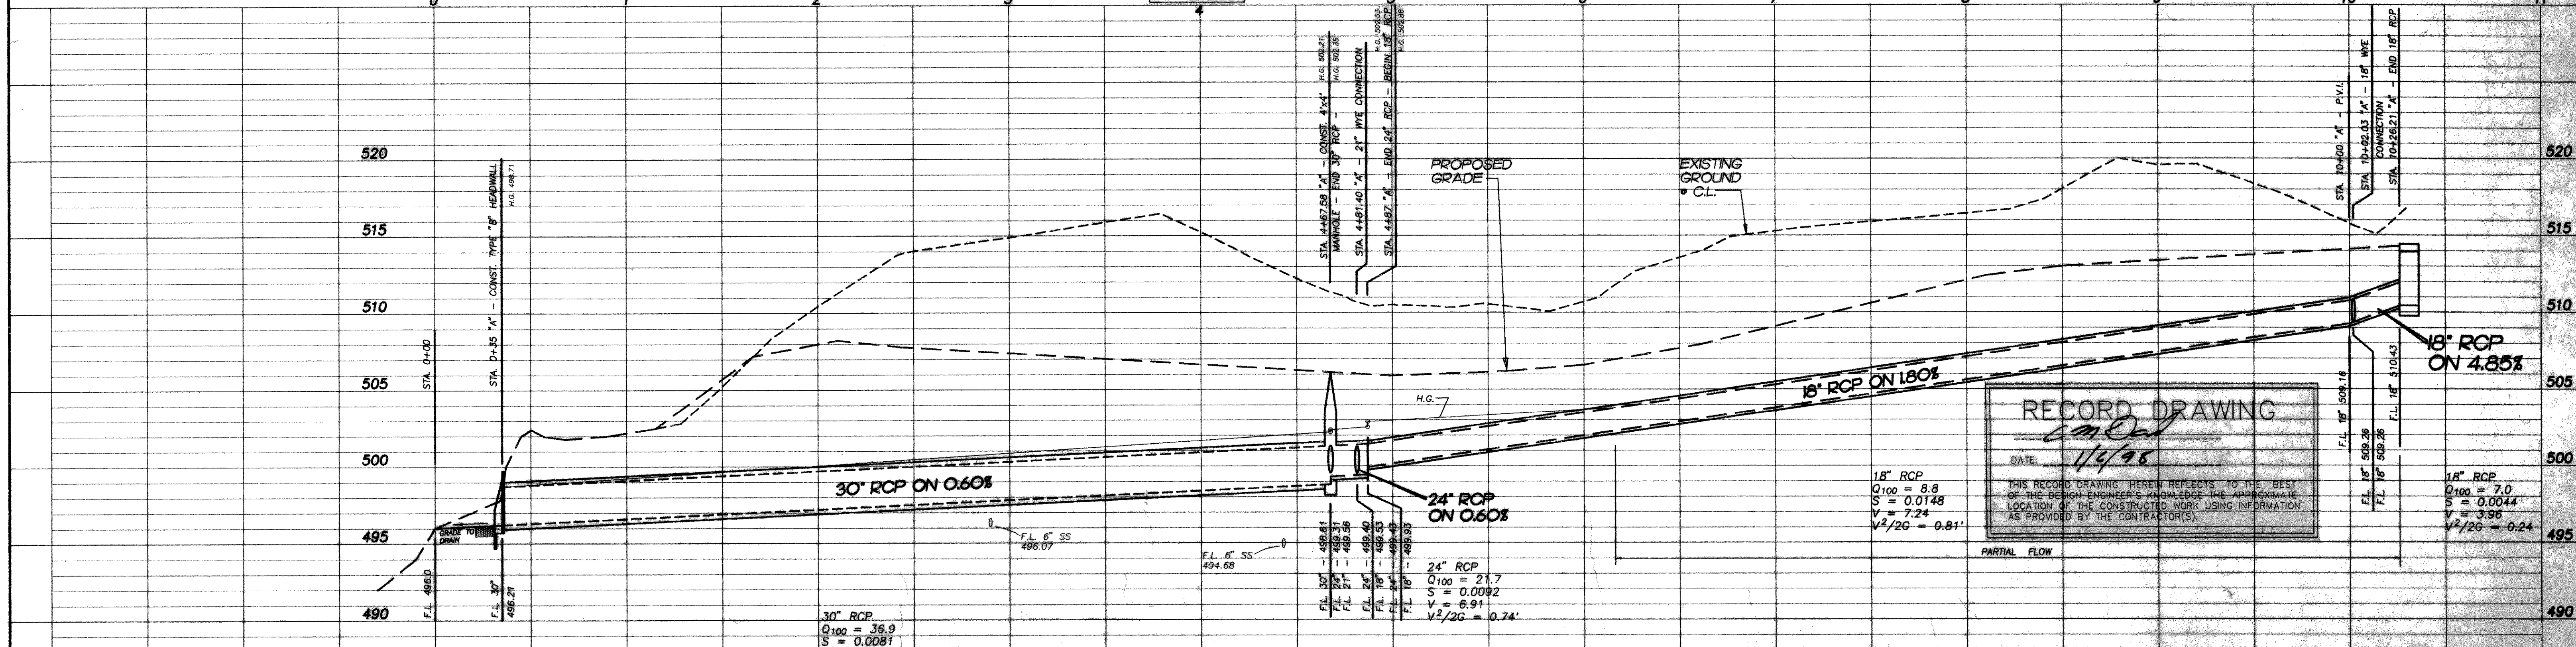

RECORD DRAWING
DATE: 1/4/98
THIS RECORD DRAWING HEREIN REFLECTS TO THE BEST OF THE DESIGN ENGINEER'S KNOWLEDGE THE APPROXIMATE LOCATION OF THE CONSTRUCTED WORK USING INFORMATION AS PROVIDED BY THE CONTRACTOR(S).

	REVISED PER CITY COMMENTS	date JAN. 1997		STORM SEWER PLAN & PROFILE LINE A CRESTVIEW PH. I & HILLSIDE PH. I THE SHORES CITY OF ROCKWALL, ROCKWALL COUNTY, TEXAS		sheet no. 12 19	
	REVISED STREET NAMES	date FEB. 1997		NATHAN D. MAIER CONSULTING ENGINEERS, INC. Three Northpark / 8800 N. Central Expy. / Suite 300 Dallas, Texas 75231 / (214) 739-4741	design MM	scale 1" = 40' H 1" = 5' V	date 11-11-96

D:\A085\9505036E\ESTW-1\STW-1 Thu Feb 27 08:32:43 1997 T44