

$\Delta = 00^{\circ}30'04''$   
 $R = 670.00'$   
 $T = 2.93'$   
 $L = 5.86'$

$\Delta = 44^{\circ}46'20''$   
 $R = 650.00'$   
 $T = 267.73'$   
 $L = 507.93'$


BESSIE ANN CAMPBELL  
VOL. 104, PG. 321

EXISTING TREES		
Tree No.	Tree Description	Remarks
1	9" CEDAR	SEE SHEET 19-A
2	10" ELM	SEE SHEET 19-A
3	9" HACKBERRY	SEE SHEET 19-A
4	9" HACKBERRY	SEE SHEET 19-A
5	9" HACKBERRY	SEE SHEET 19-A
6	9" HACKBERRY	SEE SHEET 19-A
7	10" ELM	SEE SHEET 19-A
8	10" ELM	SEE SHEET 19-A
9	10" HACKBERRY	SEE SHEET 19-A
10	9" ELM	SEE SHEET 19-A
11	11" CEDAR	SEE SHEET 19-A
12	9" MESQUITE	SEE SHEET 19-A

NOTE:  
ALL SIDE YARD SETBACK LINES ARE 5 FEET &  
ALL REAR YARD SETBACK LINES ARE 10 FEET

OWNER/DEVELOPER:  
THE SHORES INVESTORS, LP  
600 N. PEARL STREET #650  
DALLAS, TEXAS 75201  
PH. 214-880-8600

BENCHMARK:  
BRASS DISK IN CONC. MONUMENT, IN MEDIAN  
OF NORTH LAKESHORE DRIVE 150' ± NORTH OF  
ALAMO DRIVE (CITY OF ROCKWALL MONUMENT # 10).  
ELEV.: 524.62

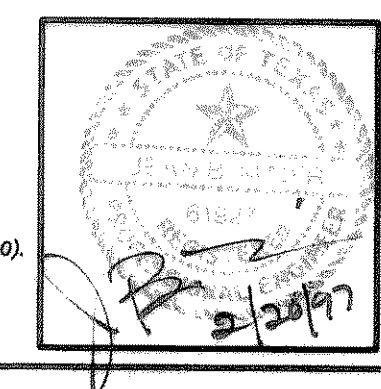

revisions	date
ADDED TREE CHART	12-6-96
REVISED STREET NAMES	2-17-97

**NDM**  
NATHAN D. MAIER  
CONSULTING ENGINEERS, INC.  
Three Northpark / 8800 N. Central Expy. / Suite 300  
Dallas, Texas 75231 / (214) 739-4741

**TREE SURVEY**  
CRESTVIEW PH. I & HILLSIDE PH. I  
THE SHORES  
CITY OF ROCKWALL,  
ROCKWALL COUNTY, TEXAS

sheet no.	19
job number	95-05-036E

L:\9505036E\1-RESUR.LTP Feb 18 16:55:31 1997 LJM