


$\Delta = 30^{\circ} 00' 00''$
 $R = 559.81'$
 $T = 150.00'$
 $L = 293.11'$

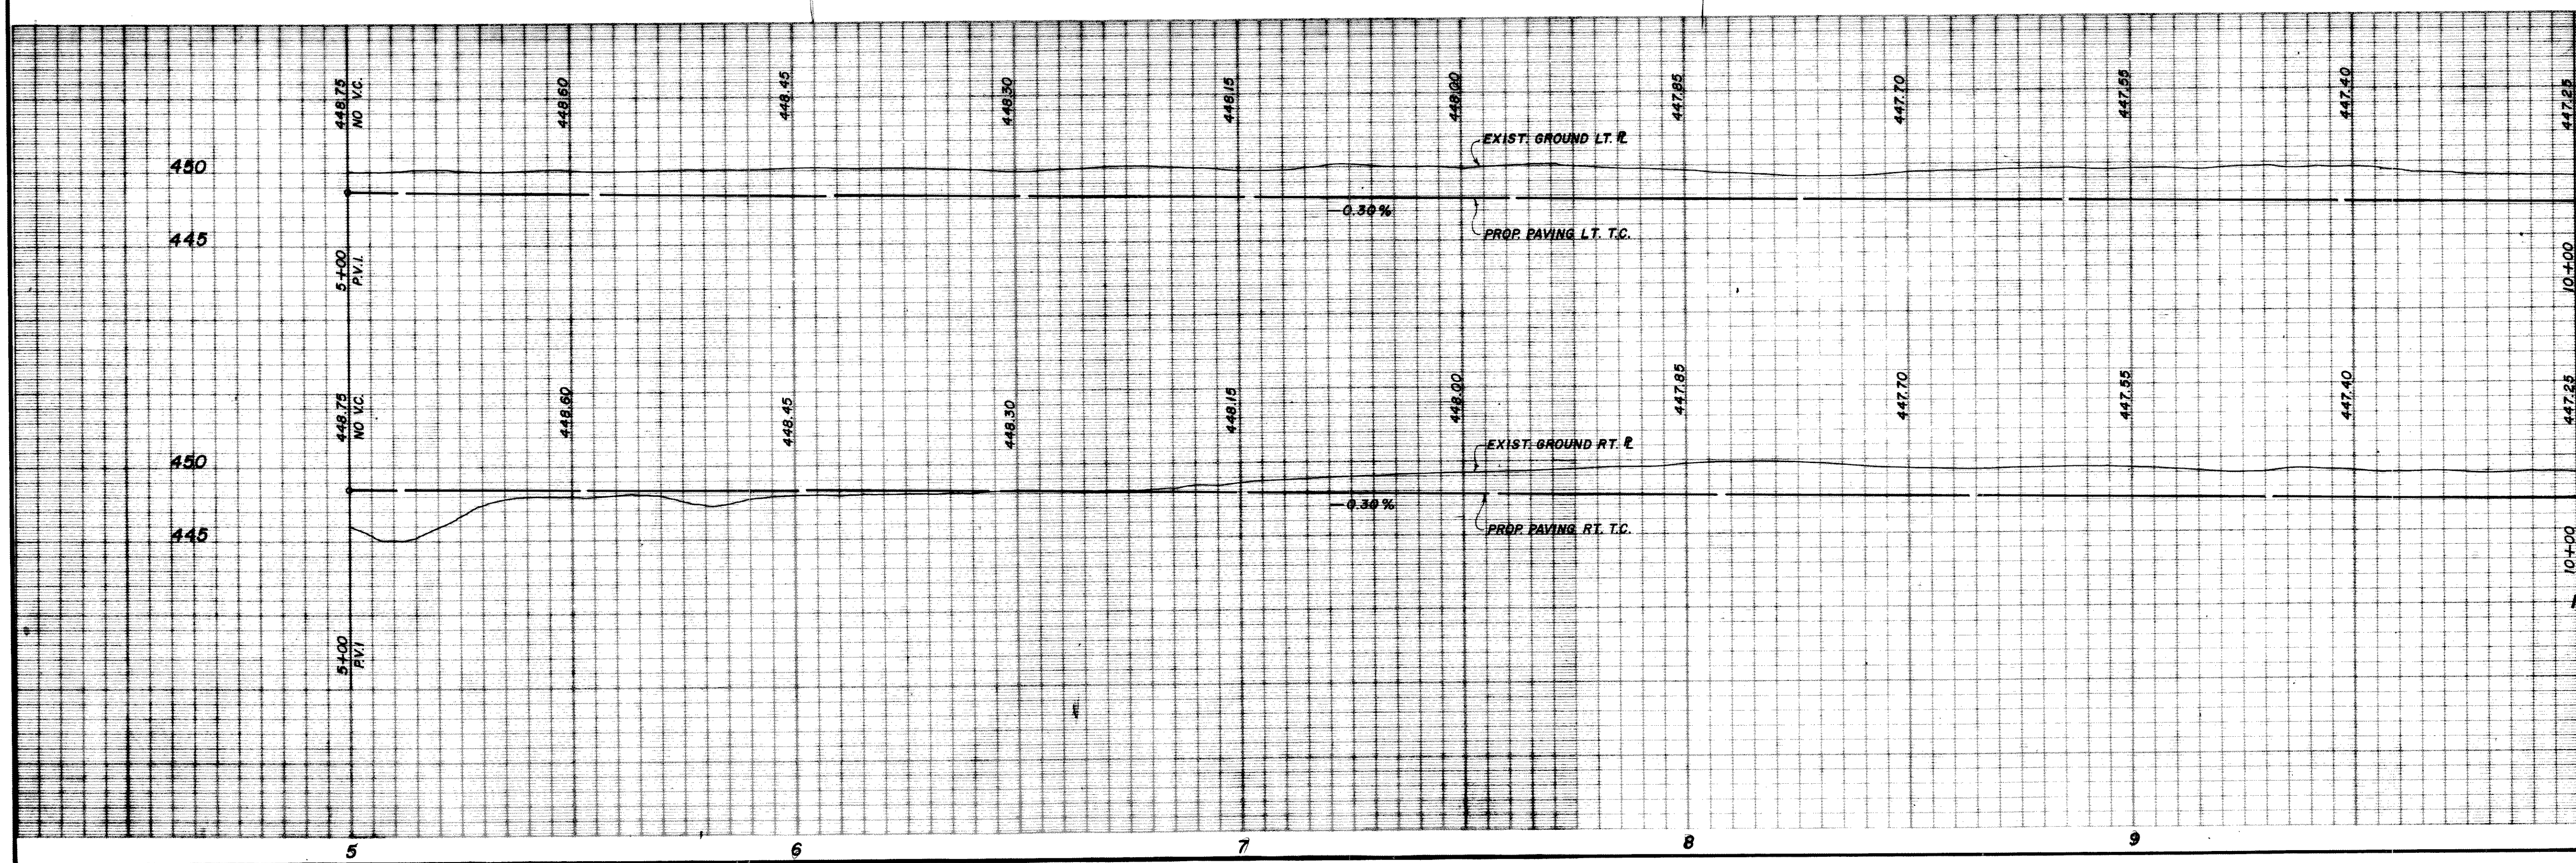

"AS BUILT"

THE SHORES						
PROPOSED PAVING						
CHAMPIONS DRIVE						
HAROLD L. EVANS & CONSULTING ENGINEER						
DESIGN	DRAWN	DATE	SCALE	NOTES	FILE	NO.
H.L.E.		OCT., 1977	1" = 20' H. 1" = 6' V.			