

MATCH STA. 30+40

PC: 30+56.33
 $\Delta = 19^\circ 36' 21''$
 $R = 200.00'$
 $T = 34.56'$
 $L = 68.44'$


CHAMPIONS

DRIVE

$\Delta = 81^\circ 18' 19''$
 $R = 200.00'$
 $T = 171.74'$
 $L = 283.81'$

P.B.C. 31+24.17

P.T. 34+08.58

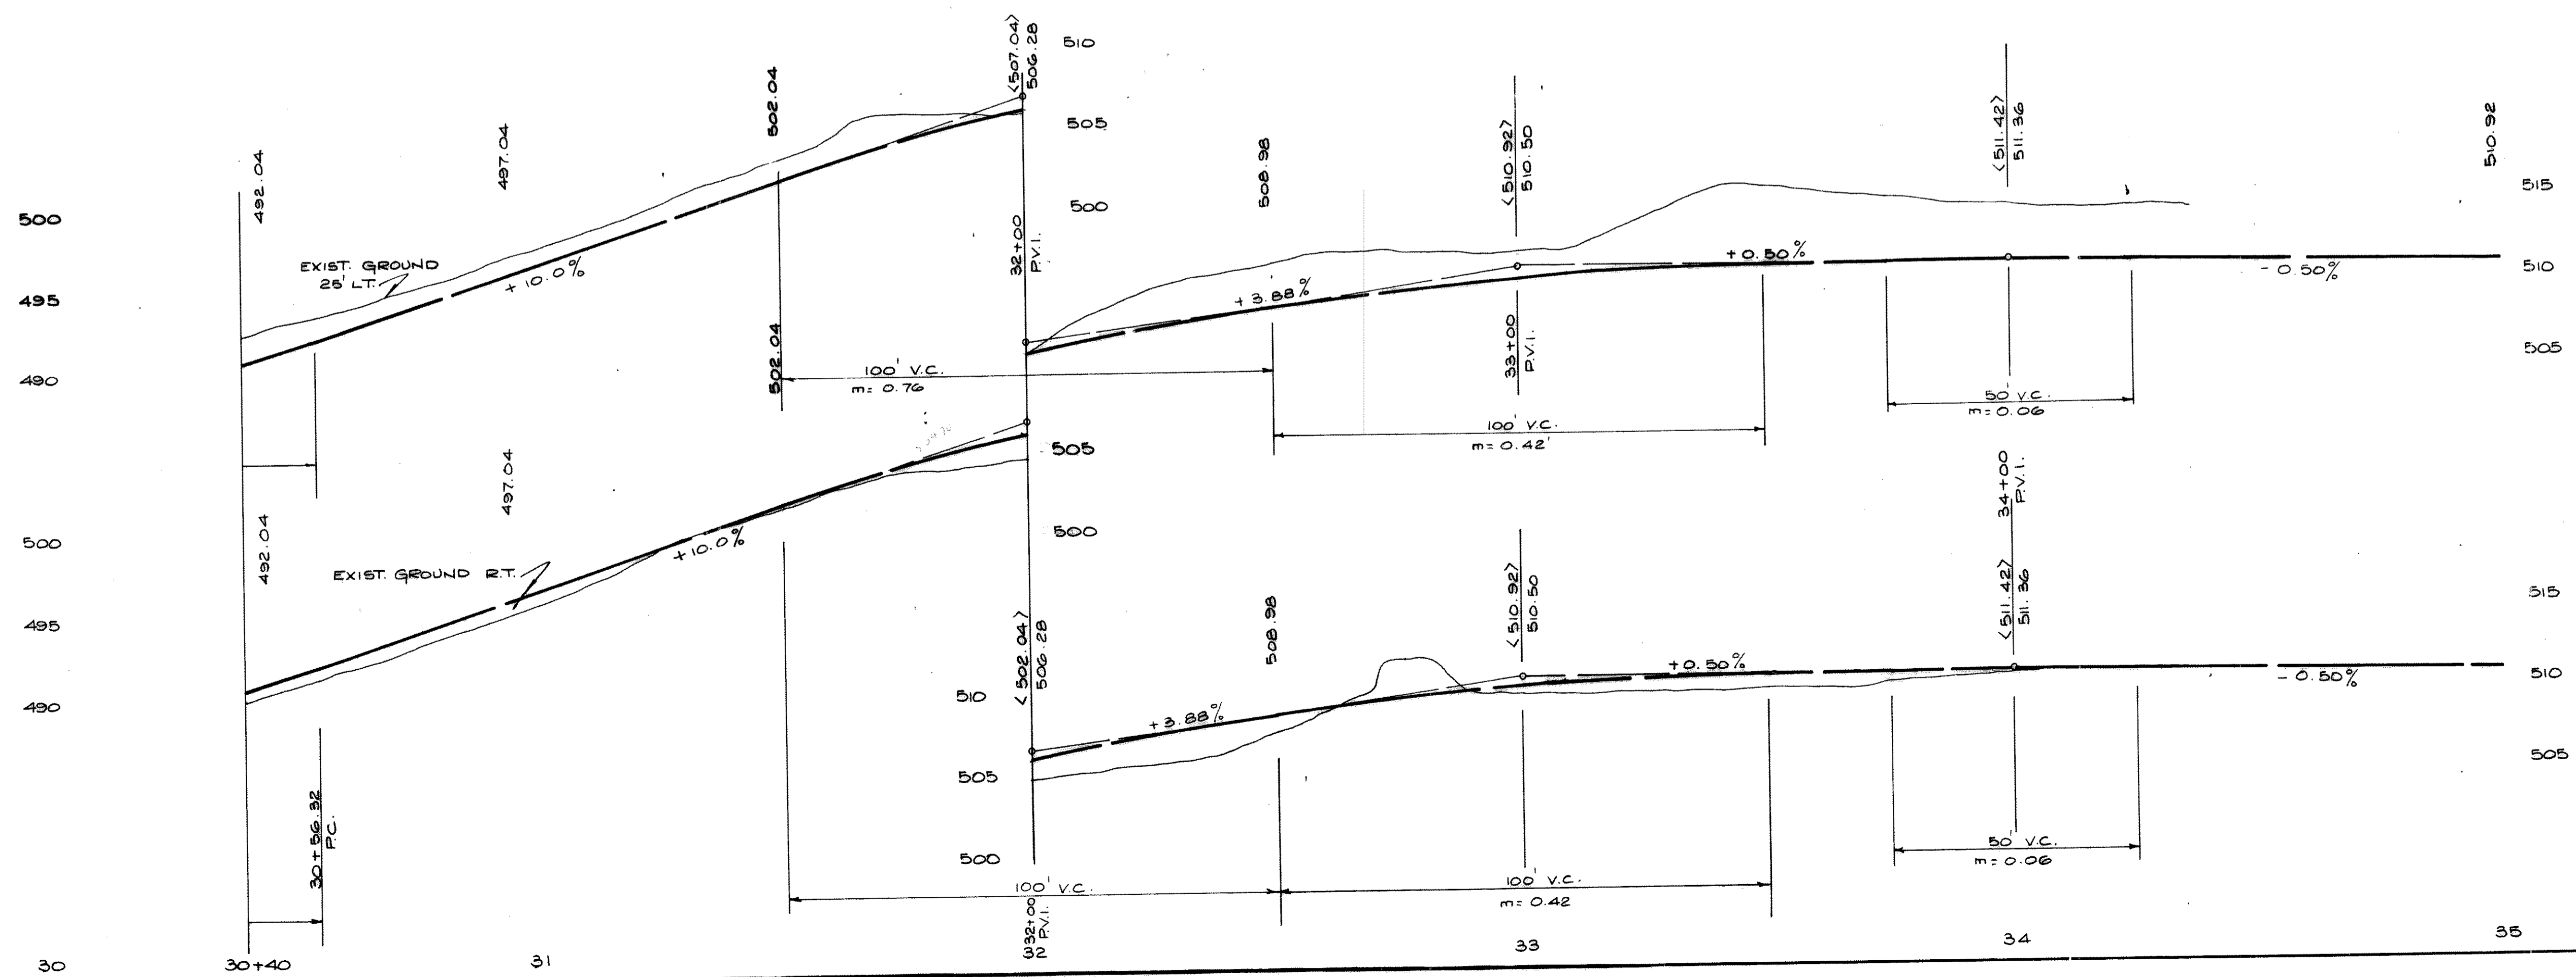

| | | | | | |
|---------------------------------------|----------------|---------|-------------------------|-------|----------|
| THE SHORES | | | | | |
| PROPOSED PAVING | | | | | |
| CHAMPIONS DRIVE | | | | | |
| ROCKWALL TEXAS | | | | | |
| HAROLD L. EVANS & CONSULTING ENGINEER | | | | | |
| DESIGN | DRAWN | DATE | SCALE | NOTES | FILE NO. |
| H.L.E. | H.M. D. MURPHY | 6-24-78 | 1" = 20' H 1" = 6' V | | 72205 |