


2' x 2' Footer
 35" Retaining wall
 Stone double
 sided

Driving Range
 Tee

Putting Green


OK
 5-15-14
 directed by Robert C
 John A

Concrete 3000 PSI
 #3 Rebar @ 18" O.C.
 Expansion joint placed @ 50'
 4" THICK CONCRETE

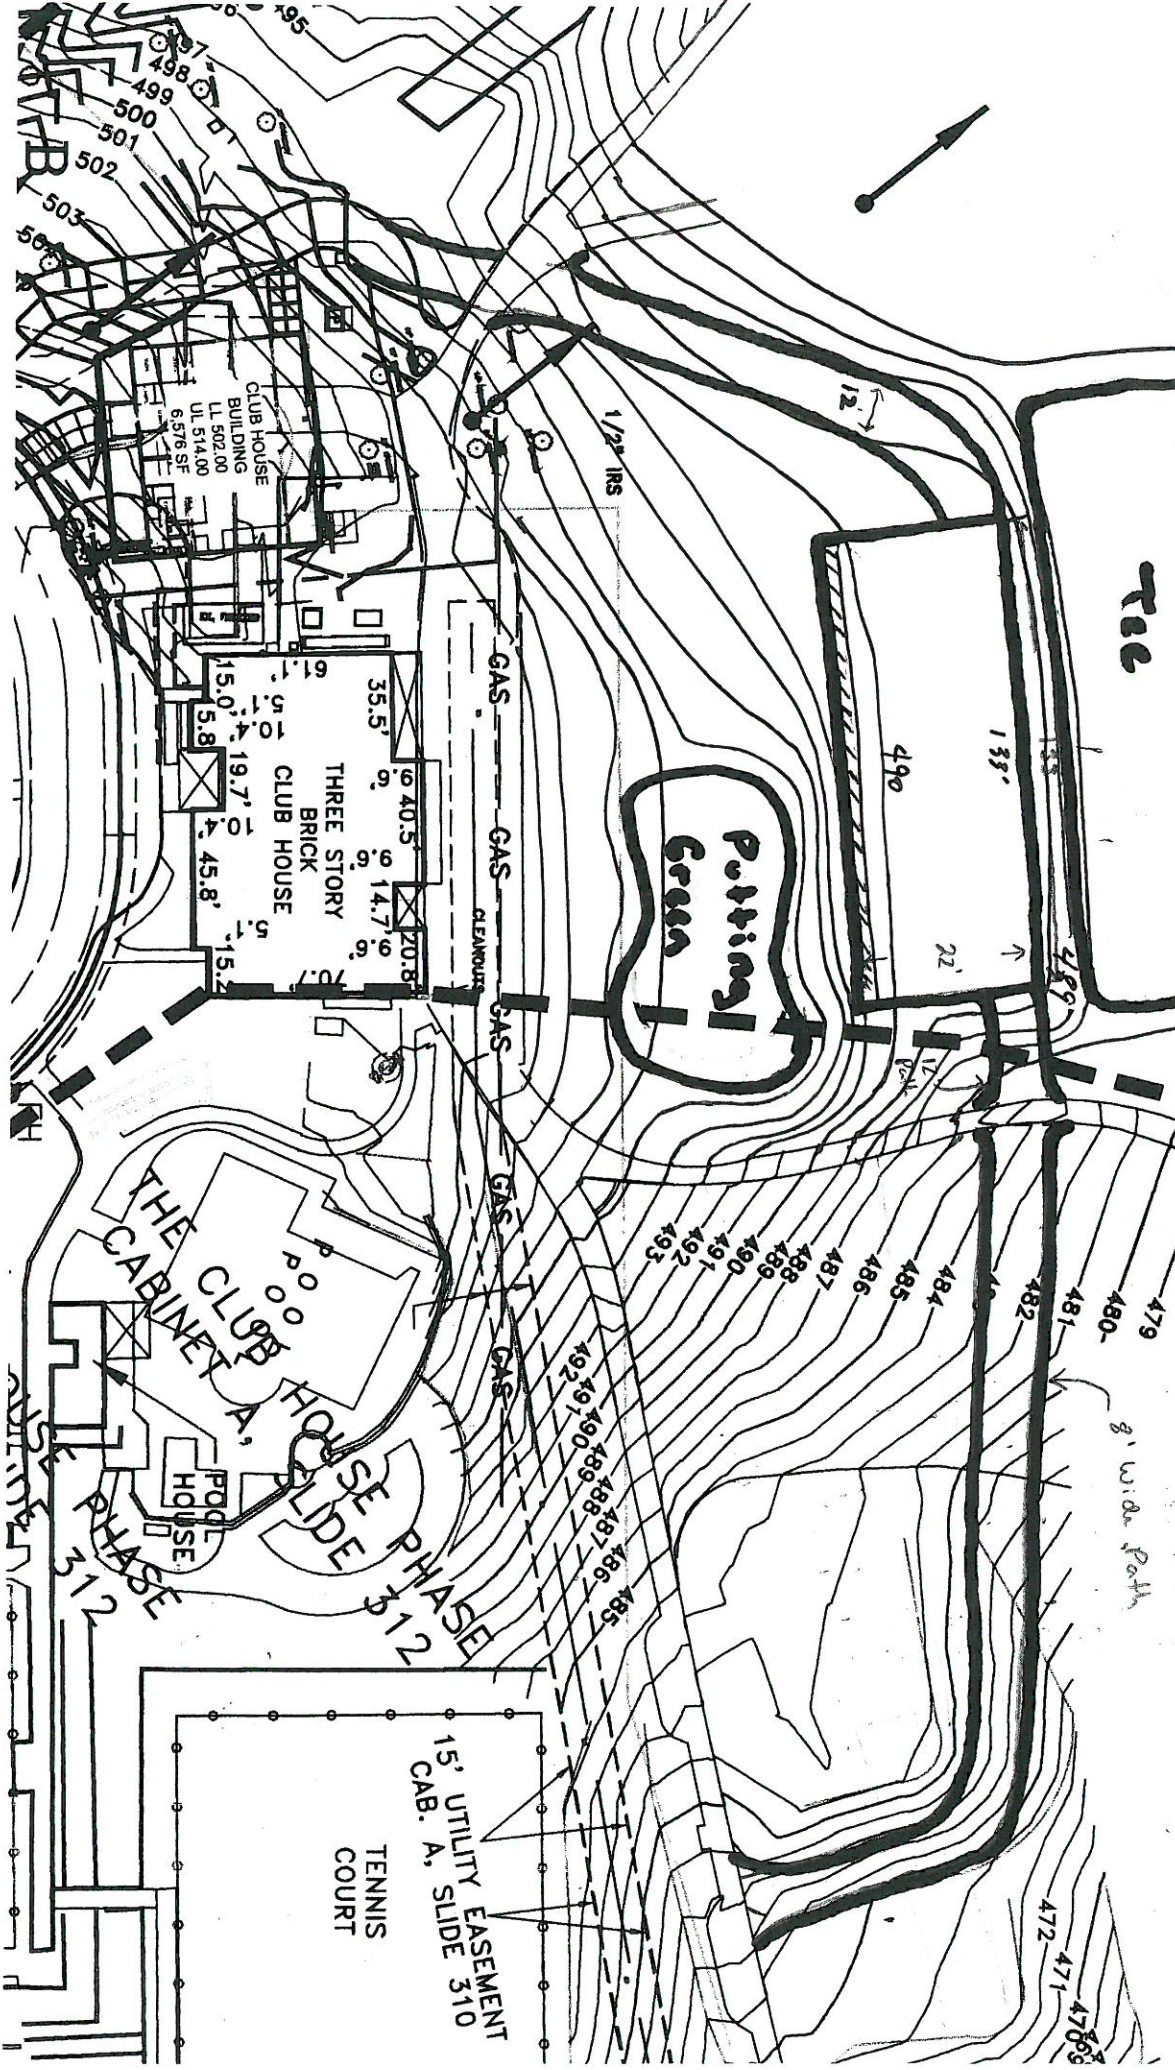


Shores Country Club
 CART PATH CONSTRUCTION
 2600 Champions D
 Rockwall TX 75087

SECTION

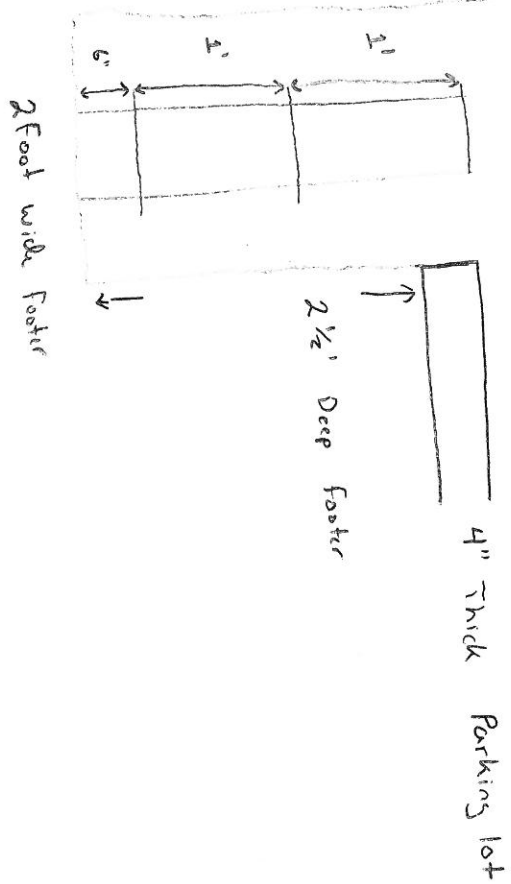

$\frac{1}{2}$ " Rebar used in Footer
3000 PSI Concrete

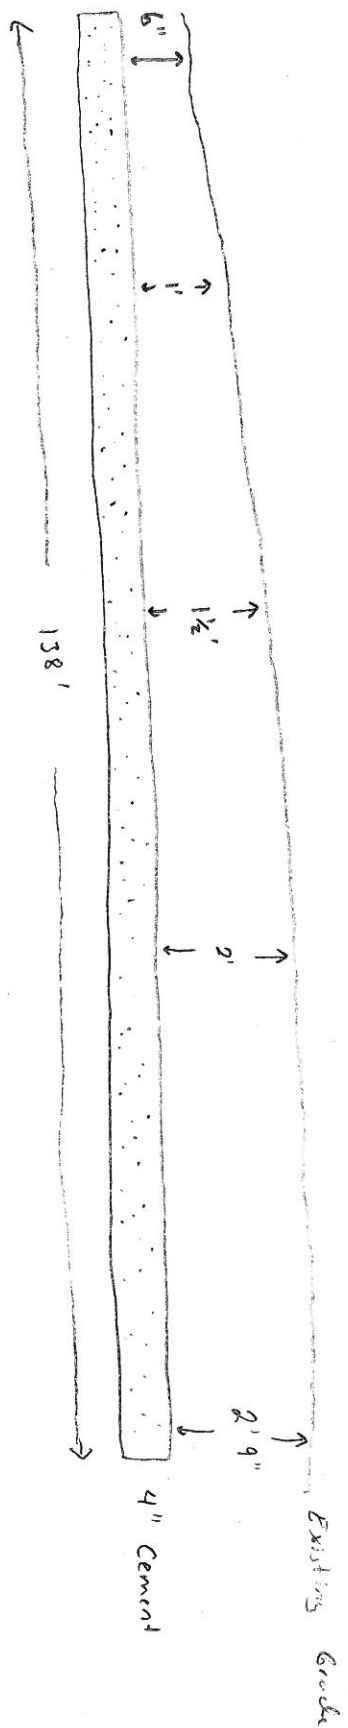

NOTE: THE CITY OF ROCKWALL CONSTRUCTION STANDARDS APPLY, WHETHER INDICATED ON THESE PLANS OR NOT

THE SUBMISSION OF BID WILL BE CONSIDERED ACKNOWLEDGMENT THAT THE CONTRACTOR HAS VISITED THE SITE AND HAS VERIFIED ALL EXISTING JOB CONDITIONS AND INCLUDED ANY NECESSARY MODIFICATION TO EXISTING AND NEW WORK REQUIRED FOR INSTALLATION OF A COMPLETE AND WORKING SYSTEM.



PHONE 877/5511
100 DICKER COURT, SUITE 710
IRVING, TEXAS 75039

<u>DATE</u>	04/24/14
<u>PROJECT</u>	011112

©COPYRIGHT 2011. ALL RIGHTS RESERVED
*ALL ELEMENTS OF THIS DRAWING ARE THE INTELLECTUAL
PROPERTY OF JOHNSTON-RAMSAY



2235 RIDGE RD. STE. 200 ROCKWALL, TEXAS 75087



LOT 2 - BLOCK H - THE SHORES CLUB HOUSE, PHASE 2