


DRAINAGE DATA							
AREA NO.	ACRES	$t_c$	$I_s$	C	$Q_s$	Accum. $Q_s$	REMARKS
1	3.5	15	5.7	0.8	15.96	~	~
2	0.9	15	5.7	0.8	4.10	20.06	~
3	1.0	15	5.7	0.8	4.56	24.62	2-14' Inlet 20 pickup
4	2.2	15	5.7	0.8	10.03	34.65	by Pass 14.65
5	0.4	15	5.7	0.8	1.82	36.47	by Pass 16.47

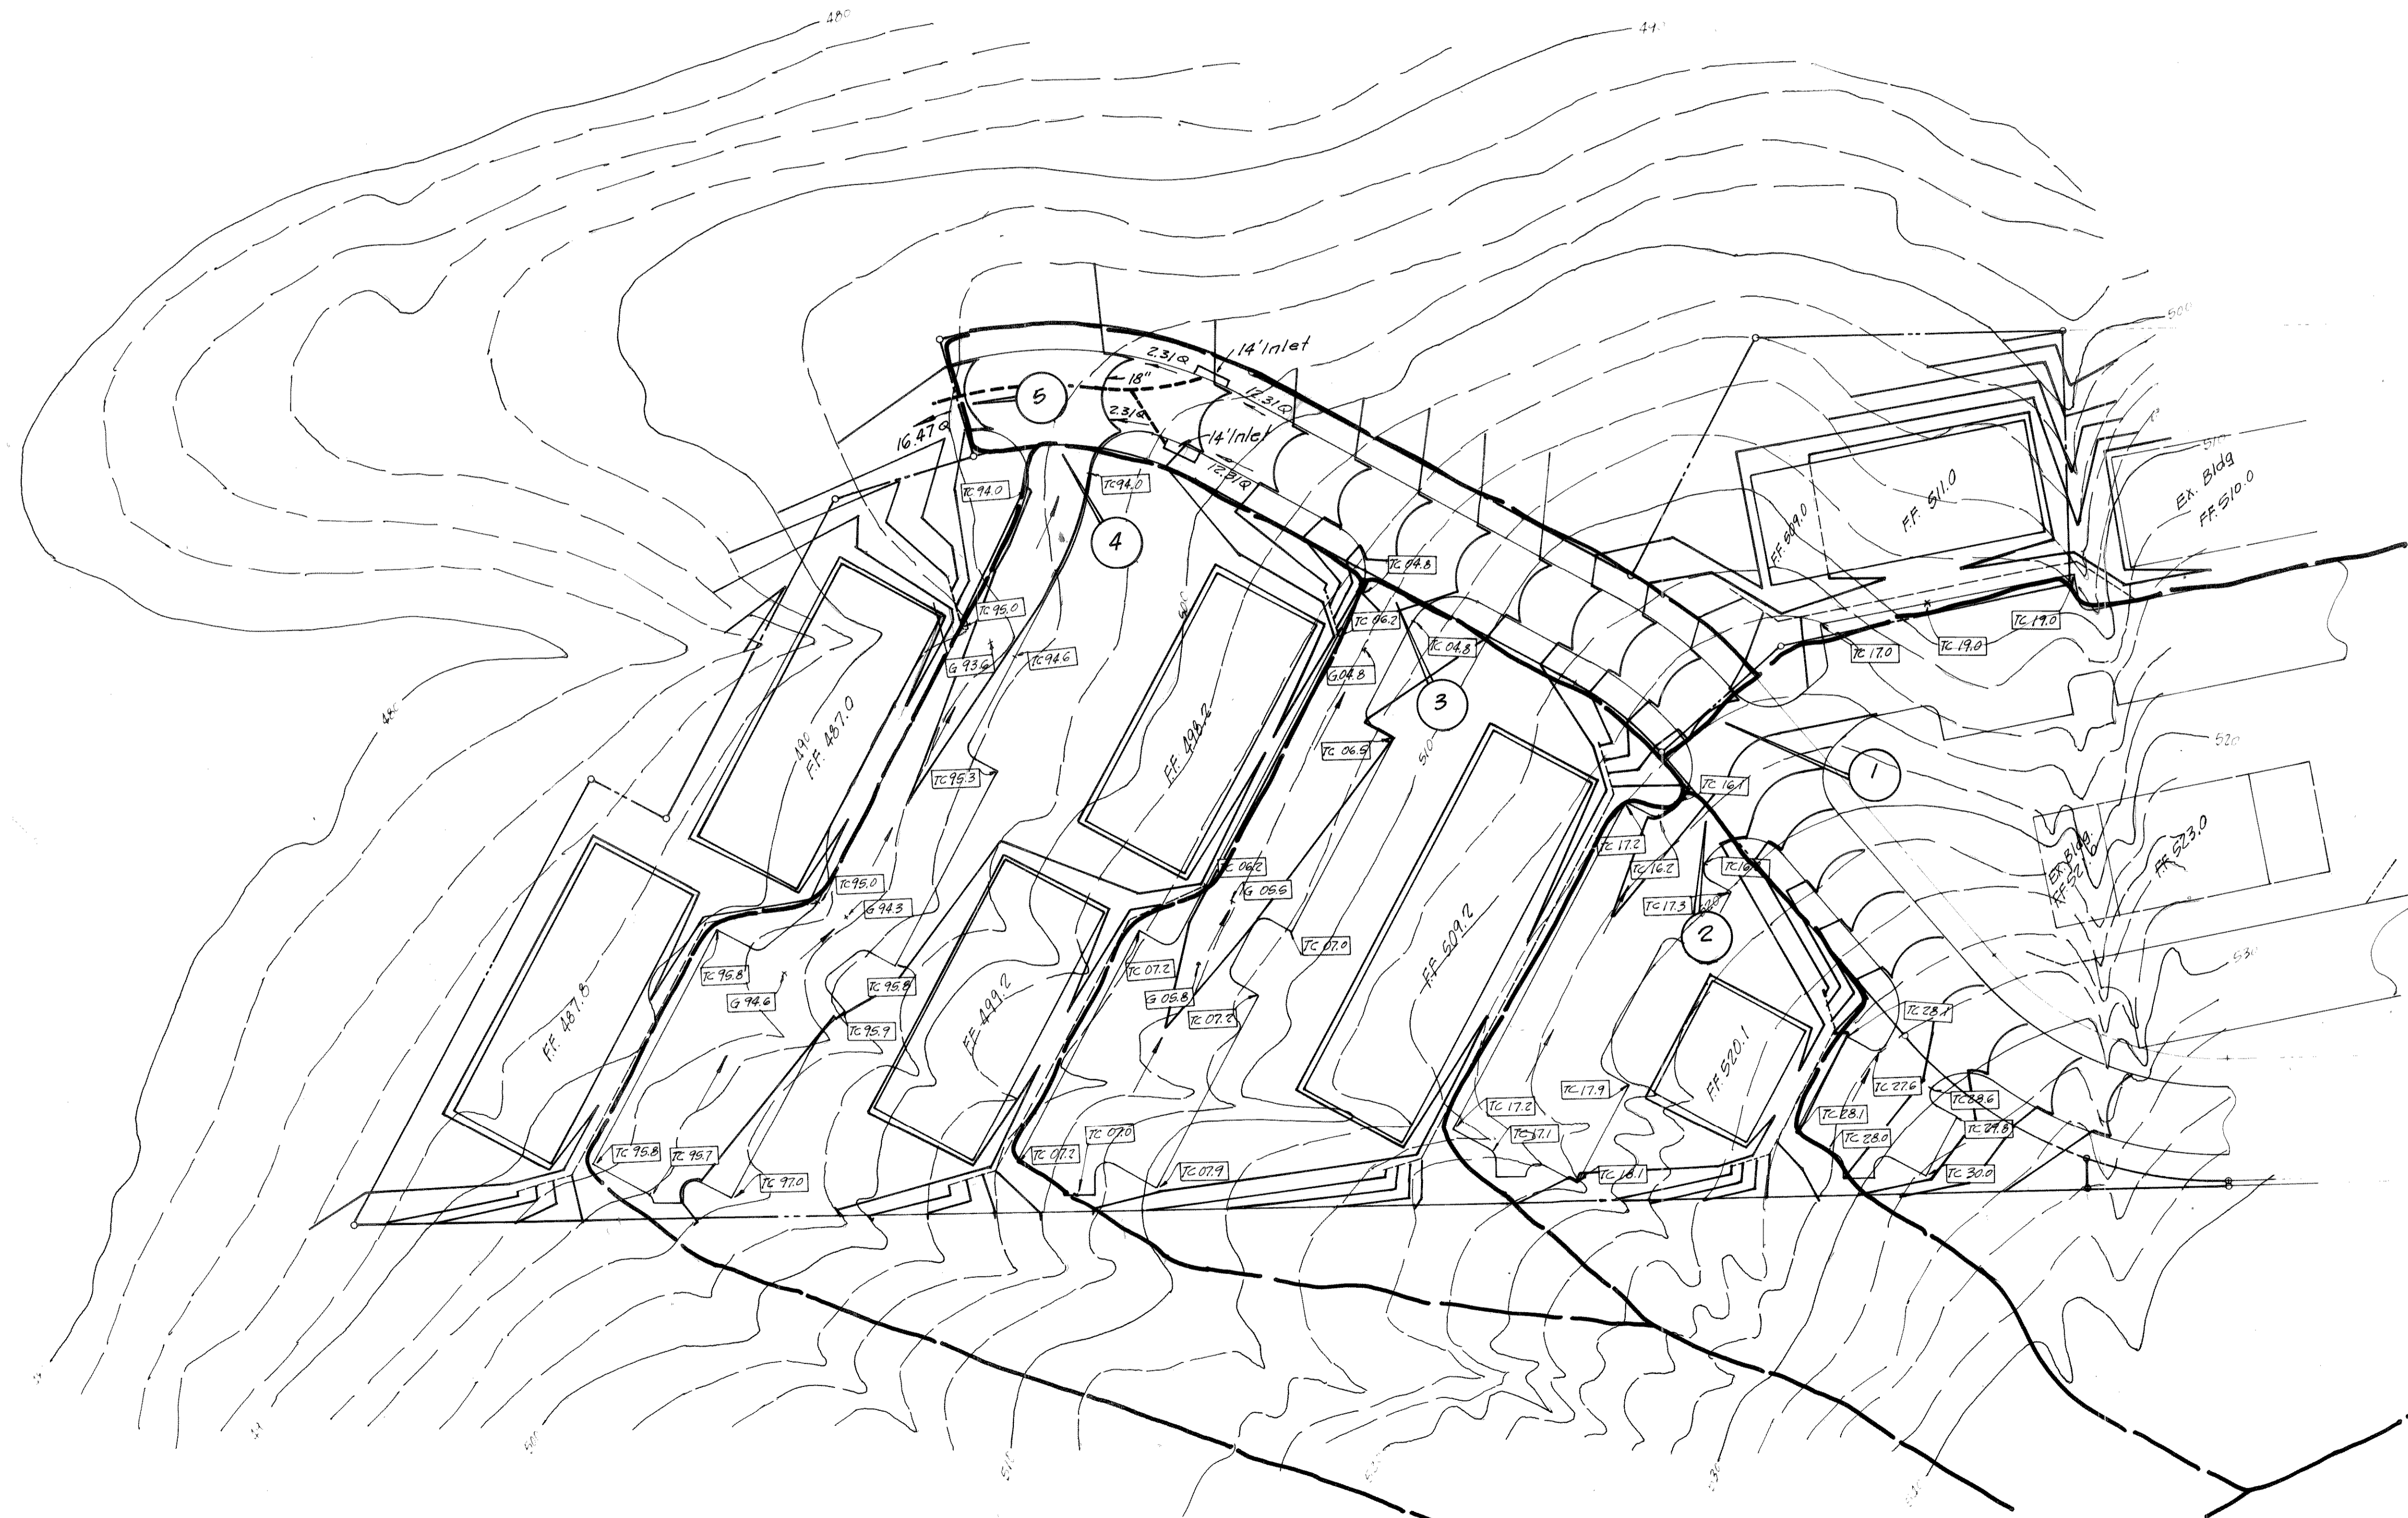

**AS BUILT**

6 OF 7

DRAINAGE MAP				ROCKWALL COUNTY			
SIGNAL RIDGE NO. 2							
P.N.	P.N.	1" = 40'	4-5-83	328-8133 HAROLD L. EVANS & CONSULTING ENGINEER, DALLAS			