



455
450
445
440
435
430

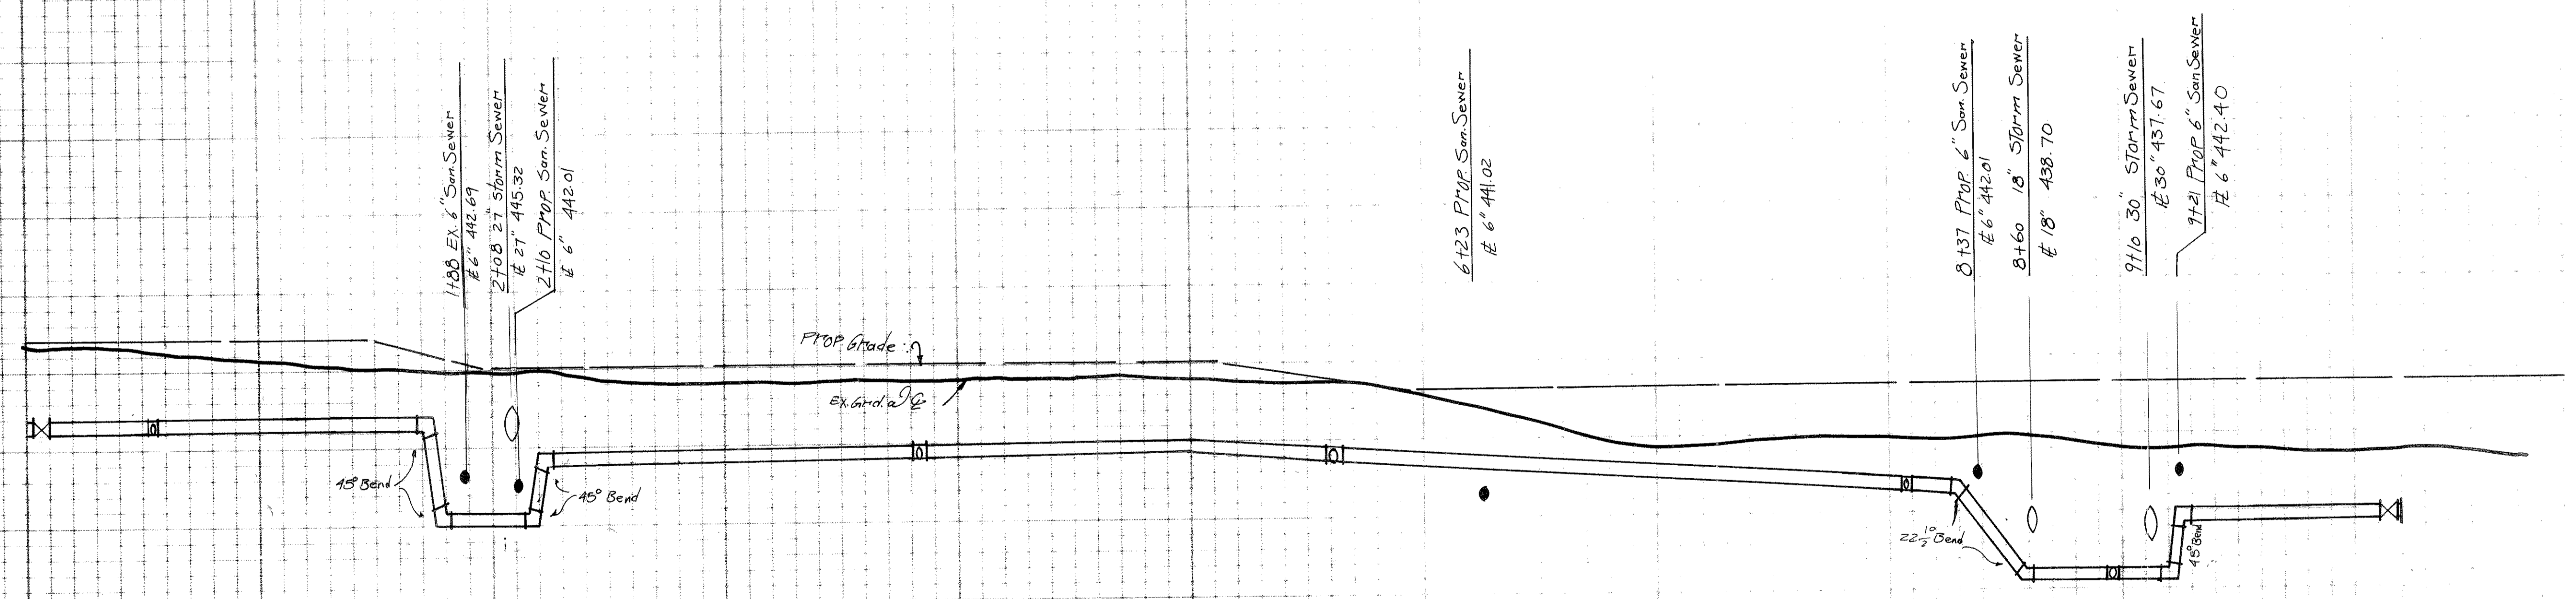

AS BUILT

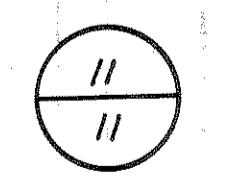

12" WATER PROFILES						
SIGNAL RIDGE NO. 3 & 4						
CITY OF ROCKWALL						
ROCKWALL COUNTY, TEXAS						
22P 5'33 HAROLD L. EVANS CONSULTING ENGINEER 24-45						
DESIGN	DRAWN	DATE	SCALE	NOTES	FILE	JOB NO.
D.H.	D.H.	OCT 1983	H 1"=40' V 1"=6'			8137