


Q = CIA
 Q = (0.75)(9.8)(1.92)
 Q = 14.11 cfs

Q = CIA
 Q = (0.75)(9.8)(1.71)
 Q = 12.57 cfs

NOTE: 1. PROPOSED & EXISTING CONTOURS ARE ON TWO FOOT INTERVALS.
 2. FF Elevations & Grading shown are from Preliminary Design - For Final Elevations & Grading - See Sheet 3/B.

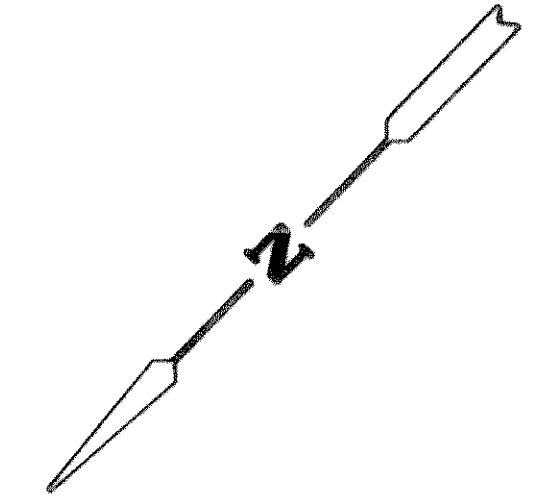

4
 8

Revised 4-09-98
 Revised 3-17-98
 6-25-86
 Revised 1-5-86

HAROLD L. EVANS
 CONSULTING ENGINEER
 2331 GUS THOMASSON RD., SUITE 102
 DALLAS, TEXAS 75228
 PHONE (214) 328-8133

SCALE	DATE	JOB NO.
1" = 40'	9/83	8137

DRAINAGE AREA MAP
SIGNAL RIDGE No. 3 & 4
 CITY OF ROCKWALL
 ROCKWALL COUNTY, TEXAS

Rev. 2-21-84 I.L. No. 9595