




FORCE MAIN

AS BUILT  
9  
10

SEWER PROFILE						
SIGNAL RIDGE						
ROCKWALL COUNTY TEXAS						
328-8155 HAROLD EVANS - CONSULTING ENGINEER DALLAS						
DESIGN	DRAWN	DATE	SCALE	NOTES	FILE	NO.
G.C.W.	T.L.B.	10-22-81	1"=100'H 1"=6'V	R.O. P.W. J.A.		6137

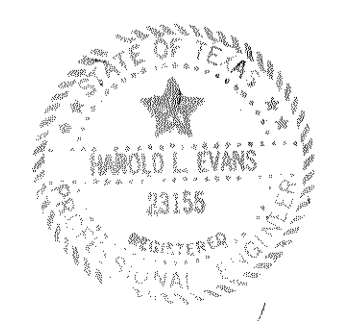

Rev. 6-7-83 Revised 3-7-83 Revised 6-24-83