

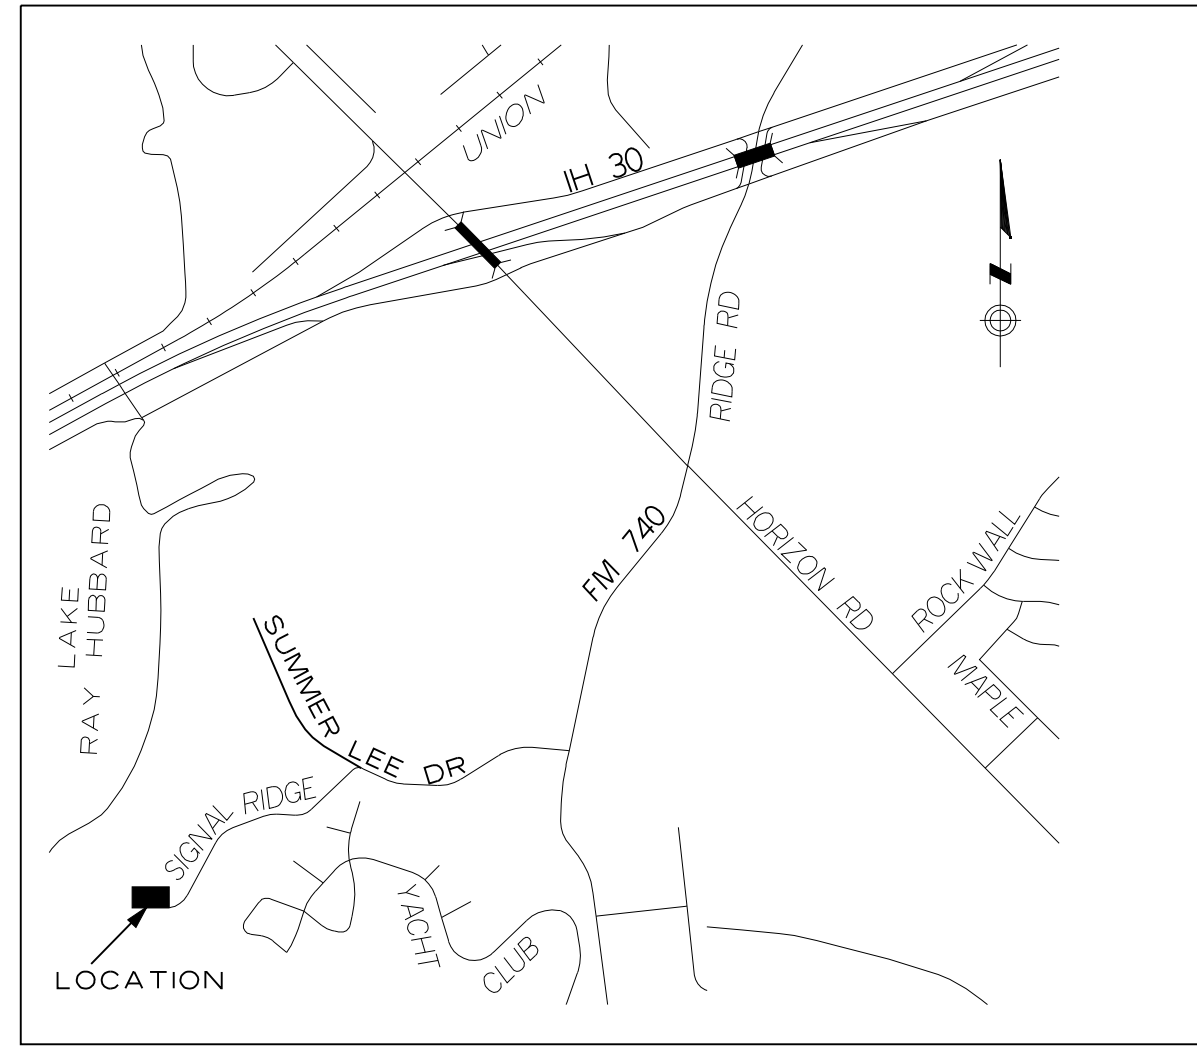


Signal_Ridge_Place_03_Landscape_PlanAB.dgn
 PLOTTED By: David
 6/2/2008 3:00:03 PM

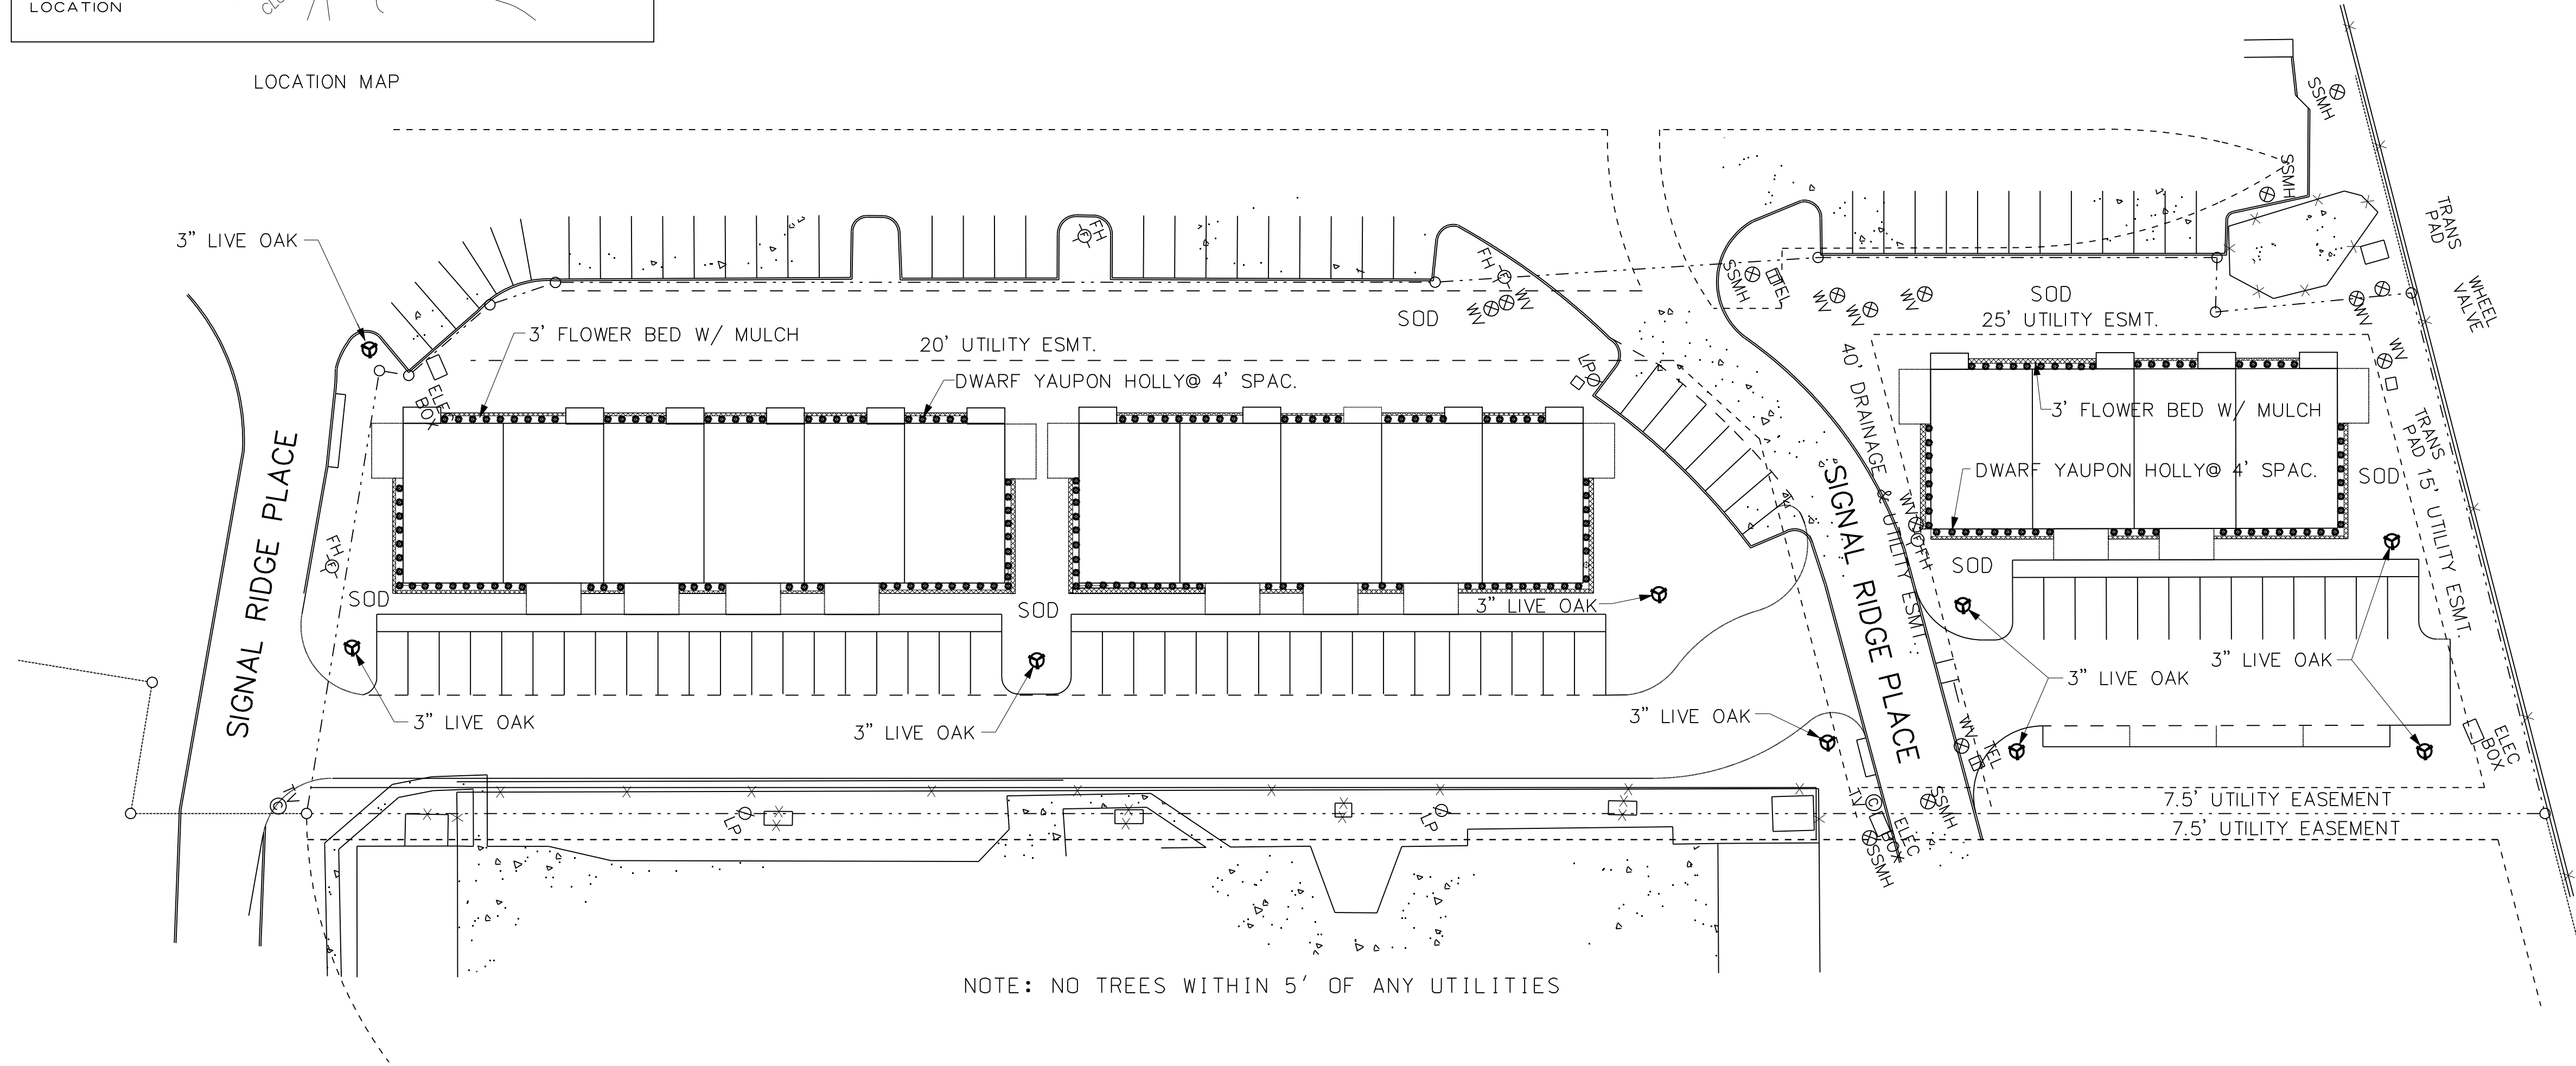


LOCATION MAP

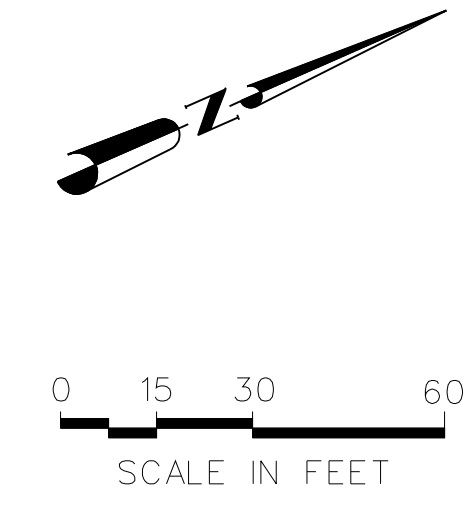

NOTE: NO TREES WITHIN 5' OF ANY UTILITIES

IMPERVIOUS AREA = 55,000 SF
 LANDSCAPE AREA = 40,000 SF

DATE: BY: REV: REVISION

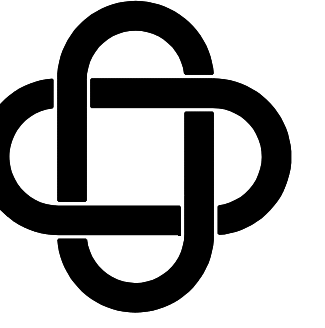

ERIC L. DAVIS
 ENGINEERING, INC.

425 Pinson Road Ste. C
 Forney, Texas 75126
 972/564-0592 Fax 972/564-6523
 E-Mail ericdavis@eidengineering.com

LANDSCAPE PLAN

SIGNAL RIDGE PLACE
 CITY OF ROCKWALL, ROCKWALL CO, TX

DEVELOPER:

JOB NO.:
 DRAWN BY:
 CHECKED BY:
 DATE:

SCALE: 1" = 30'

SHEET 3 OF 12

SHEET 3