


SignalRidge\_Place\_04\_Existing\_Drainage\_Area\_MapAB.dgn  
 PLOTTED BY: David  
 6/2/2008 3:00:07 PM

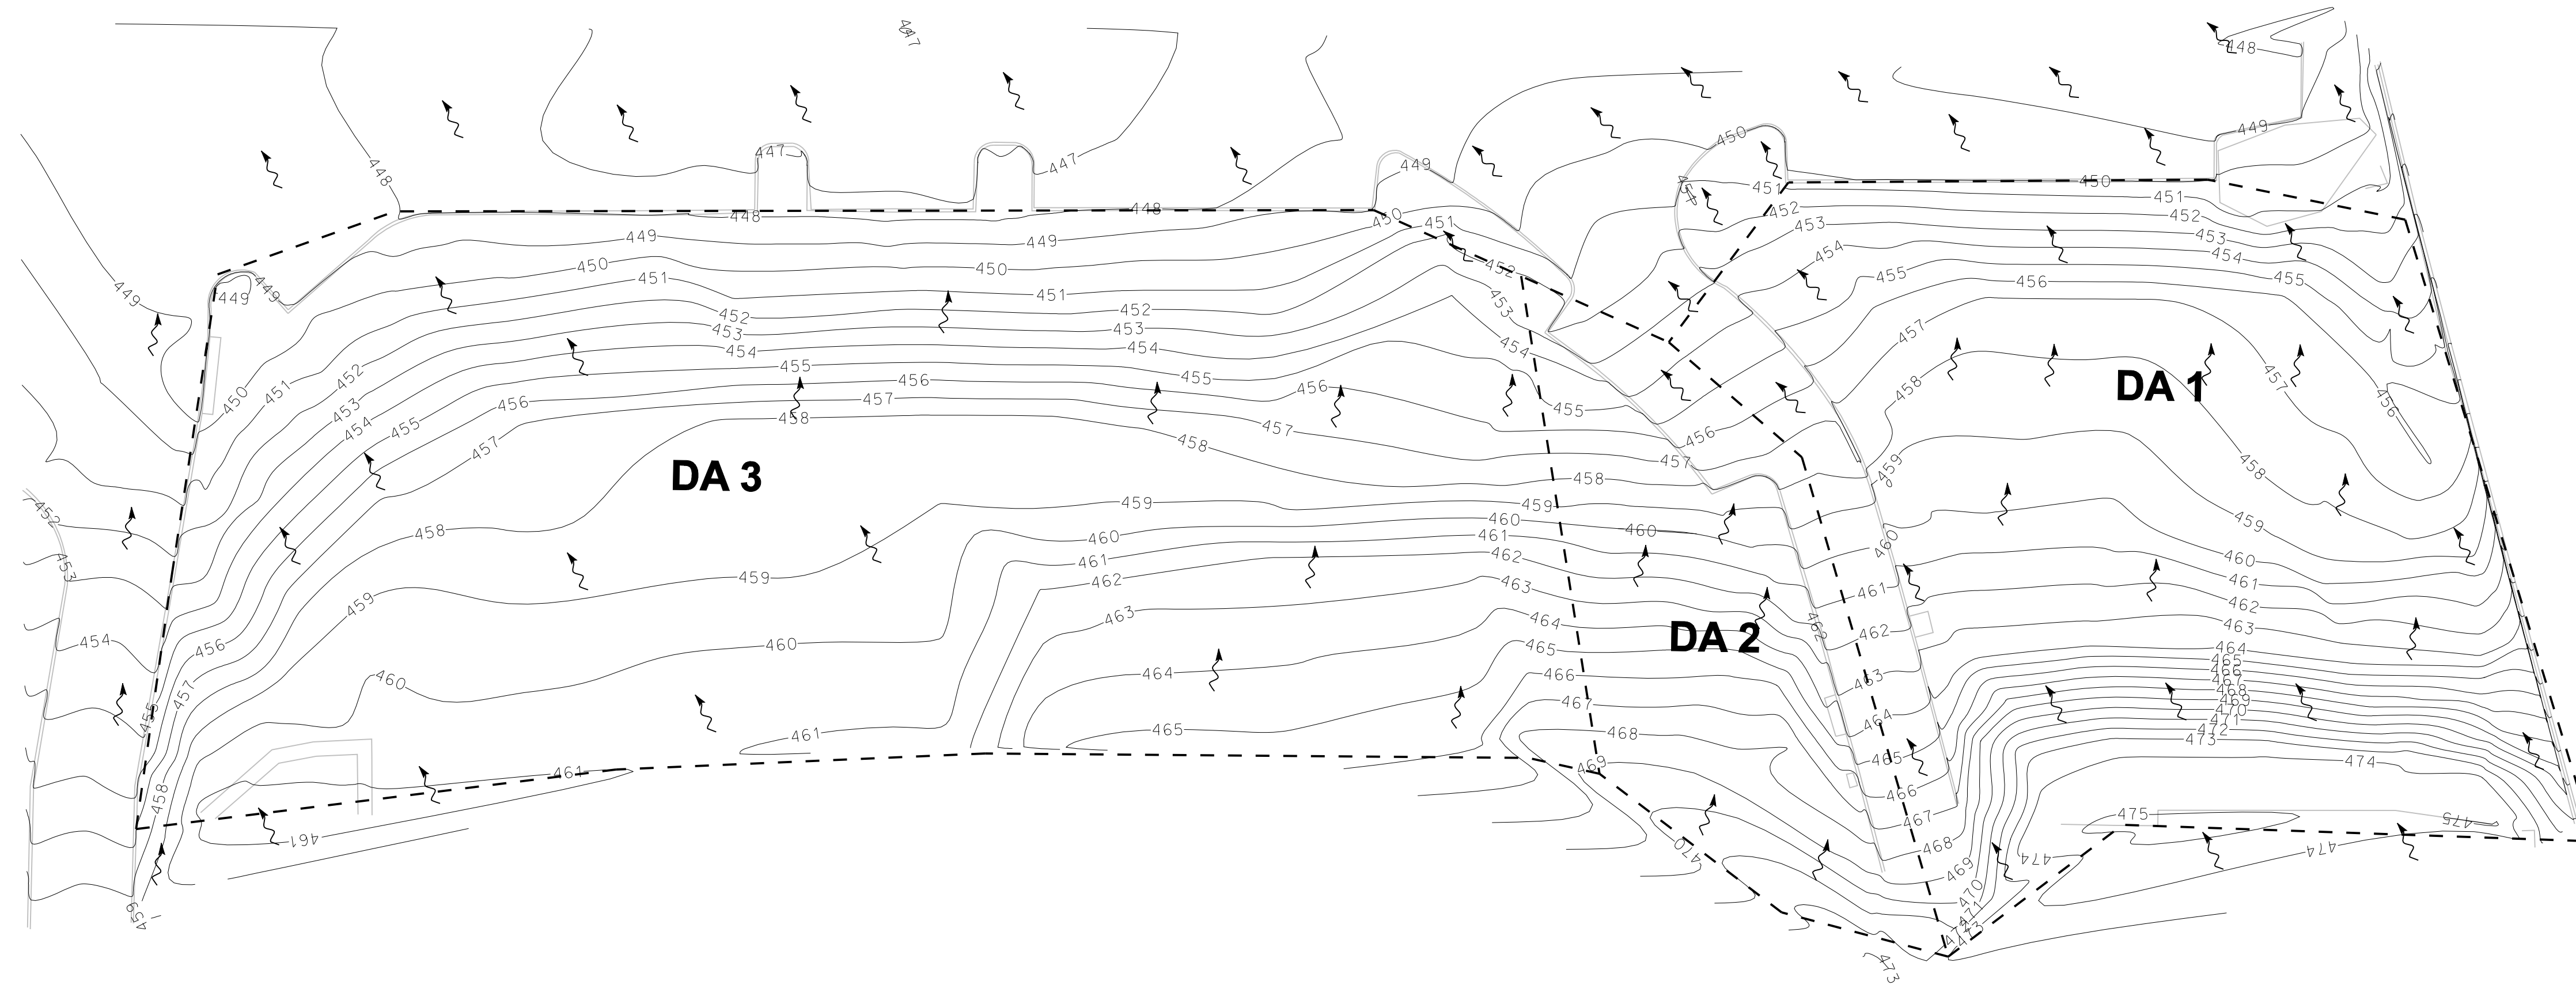


DRAINAGE COMPUTATIONS

DA	A ac	C comp	T <sub>c</sub> min	I <sub>100</sub> in/hr	Q <sub>100</sub> cfs
1	0.77	0.4	10.00	11.48	3.5
2	0.25	0.4	10.00	11.48	1.1
3	1.28	0.4	10.00	11.48	5.9

NOTE:  
 TO THE BEST OF OUR KNOWLEDGE ERIC L. DAVIS ENGINEERING, INC., HEREBY STATES  
 THAT THIS PLAN IS AS-BUILT. THE INFORMATION PROVIDED IS BASED ON SURVEYING  
 CONDUCTED AT THE SITE AND INFORMATION PROVIDED BY THE CONTRACTOR.


DATE	BY	REV	REVISION

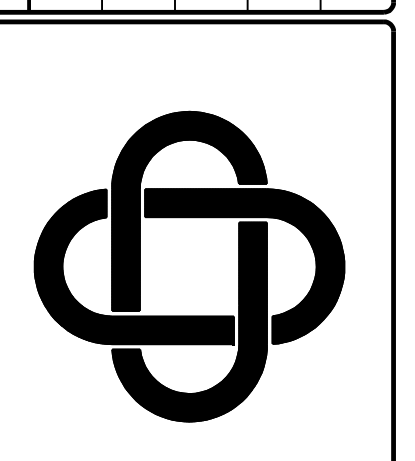

ERIC L. DAVIS  
 ENGINEERING, INC.  
 425 Pinson Road Ste. C  
 Forney, Texas 75126  
 972/564-0592 Fax 972/564-6523  
 E-Mail ericdavis@eidengineering.com

**EXISTING DA MAP**  
 SIGNAL RIDGE PLACE  
 CITY OF ROCKWALL, ROCKWALL CO, TX

DEVELOPER:	
JOB NO.:	
DRAWN BY:	
CHECKED BY:	
DATE:	

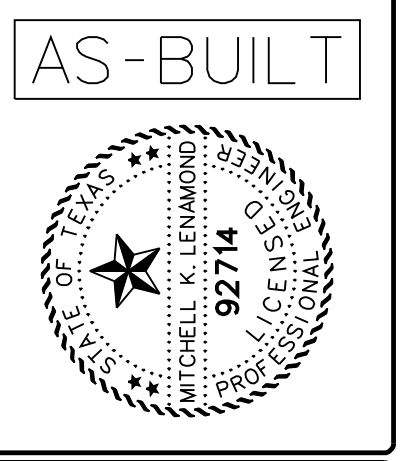

SCALE: 1"=30'

SHEET 4 OF 12

SHEET **4**