


Signal_Ridge_Place_05_Proposed_Drainage_Area_MapAB.dgn
 PLOTTED BY: David
 6/2/2008 3:00:10 PM

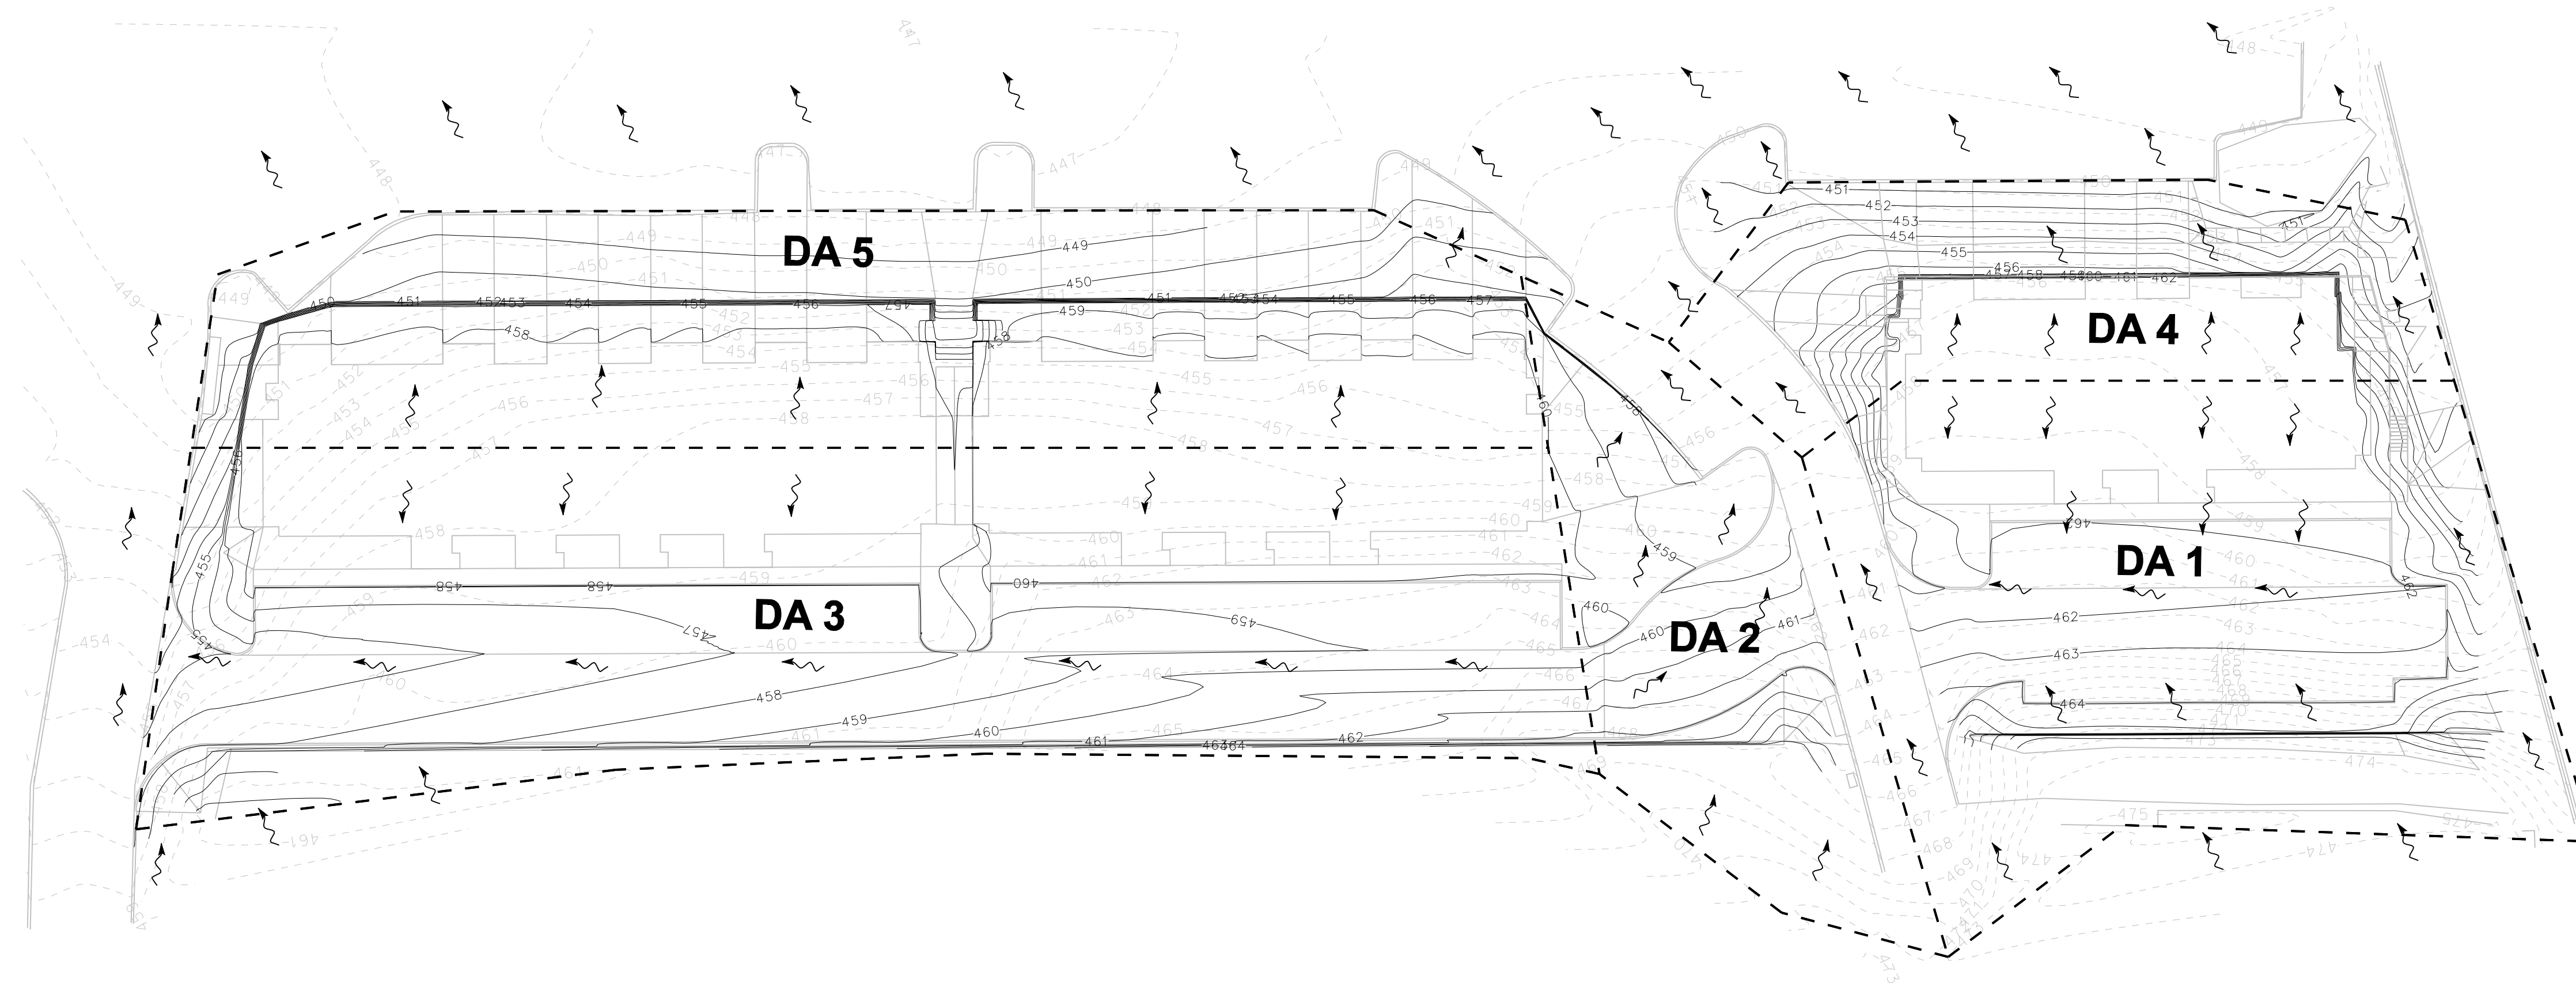


DRAINAGE COMPUTATIONS

DA	A ac	C comp	T _c min	I ₁₀₀ in/hr	Q ₁₀₀ cfs
1	0.53	0.8	10.00	11.48	4.8
2	0.25	0.8	10.00	11.48	2.3
3	0.77	0.8	10.00	11.48	7.1
4	0.24	0.8	10.00	11.48	2.2
5	0.51	0.8	10.00	11.48	4.7

NOTE:
 TO THE BEST OF OUR KNOWLEDGE ERIC L. DAVIS ENGINEERING, INC., HEREBY STATES
 THAT THIS PLAN IS AS-BUILT. THE INFORMATION PROVIDED IS BASED ON SURVEYING
 CONDUCTED AT THE SITE AND INFORMATION PROVIDED BY THE CONTRACTOR.


DATE	BY	REV	REVISION

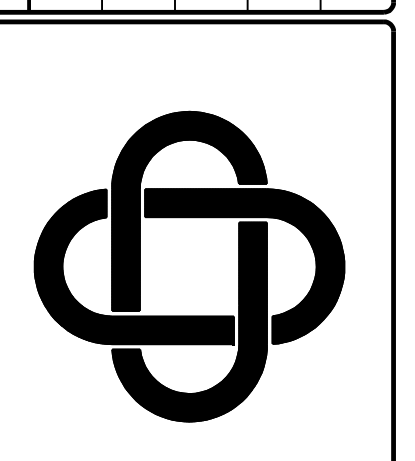

ERIC L. DAVIS
 ENGINEERING, INC.
 425 Pinson Road Ste. C
 Forney, Texas 75126
 972/564-0592 Fax 972/564-6523
 E-Mail ericdavis@eidengineering.com

PROPOSED DA MAP
 SIGNAL RIDGE PLACE
 CITY OF ROCKWALL, ROCKWALL CO, TX

DEVELOPER:	
JOB NO.:	
DRAWN BY:	
CHECKED BY:	
DATE:	

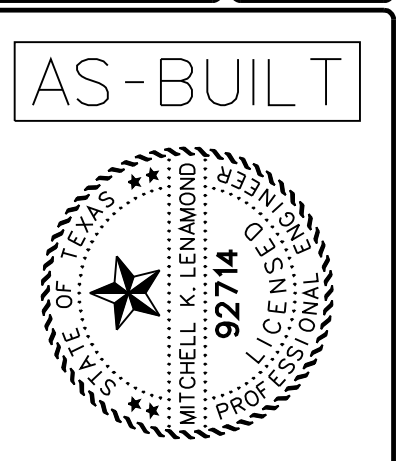

SCALE: 1"=30'

SHEET 5 OF 12

SHEET **5**