


PLAN

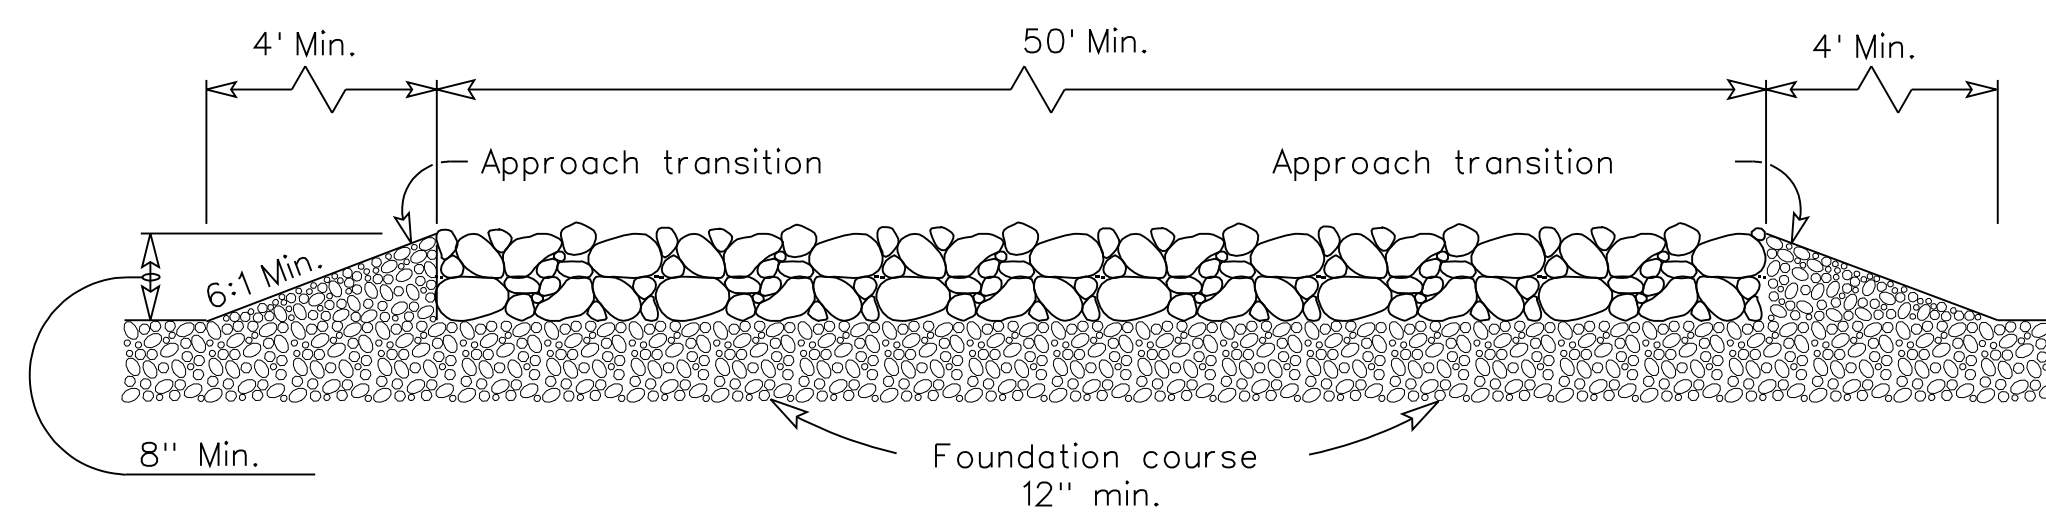

PROFILE

CONSTRUCTION EXIT (TYPE 1)

I GENERAL:

Each Contractor shall have a designated area in which to stage his construction for this project. This site will be designated by the Contractor and shall be approved by the Owner. It will be the Contractor's responsibility to construct berms around its site so as to minimize the possibility of run-off water being exposed to pollutants and to detritus in any water that might potentially be exposed to pollutants. It shall also be the responsibility of each Contractor to install dikes around any diesel, gasoline or oil tanks, as well as any other hazardous chemicals stored on site, in order to contain any possible contamination to the smallest area should a leak or spill occur. If a leak or spill should occur, the Contractor responsible for such an accident is required to report it to the Owner immediately.

This shall also be the designated area for equipment maintenance and repair. All maintenance will take place inside this area and any repairs to equipment should be performed here, if possible. Should the equipment not be able to be moved to this location, special care will be taken to prevent pollutants (oil, diesel, hydraulic fluid, etc.) from entering, either directly or indirectly, into the storm sewer, runoff of waterways.

Solid waste receptacles for trash and other debris such as soft drink cans or bottles, wrapping paper, metal or plastic banding strips and all other waste products shall be provided by the Contractor and shall be maintained during its tenure and removed at the end of his portion of the work. Contractor shall police the Project and maintain the cleanest site possible. An adequate number and properly maintained sanitary facilities (such as Chem-Cans) shall be supplied by Contractor for, and is to be used by, its employees.

A. Storage of Material on Site

Materials shall be stored in the designated staging area whenever feasible to do so. When materials are to be stored outside this area, it should be done in such a way as to prevent as much exposure as possible. Sand and rock should be stored in a location that will prevent the flow of run-off storm water from coming into contact with it. Any time diesel, gasoline, oil or other hazardous materials are stored outside the staging area (even if overnight), a retention dike is to be immediately constructed.

GENERAL NOTES

1. The length of the type 1 construction exit shall be as indicated on the plans, but not less than 50'.
2. The coarse aggregate should be open graded with a size of 4" to 8". No crushed concrete allowed.
3. The approach transitions should be no steeper than 6:1 and constructed as directed by the Engineer.
4. The construction exit foundation course shall be flexible base, bituminous concrete, portland cement concrete or other material as approved by the Engineer.
5. The construction exit shall be graded to allow drainage to a sediment trapping device.
6. The guidelines shown hereon are suggestions only and may be modified by the Engineer.

B. Entering and Exiting Project

It is the responsibility of Contractor to make sure that all vehicles either owned or employed by him are free of soils which could be tracked onto any adjacent roadways. In the event that soils are tracked onto a roadway, clean up of this soils to be performed immediately, and in such a manner as not to contaminate offsite storm drainage facilities.

1. Equipment Wash Down Areas:

Equipment Wash Down areas are not a mandatory part of the Plan unless a Contractor wishes to wash his equipment or other vehicles on site. If a Contractor wishes to do so, he may elect to use the stabilized construction entrance as a Wash Down area, or he may build a similar structure inside the Project which will retain all water produced by the washing of equipment. It will not be acceptable to wash any equipment on adjacent roadways or property.

C. Paving:

Paving should be done in a manner as to ensure that the sediment controls are in place above and below where the construction is taking place and not to leave a waterway open so that the sediment laden water is allowed to leave the site without being filtered.

D. Dust Control:

During construction, water trucks will be used by each contractor to reduce dust as needed. After construction, the site will be re-vegetated to reduce dust.

II MAINTENANCE AND REPORTING PROCEDURES

A. Maintenance and Repair:

Inspections are to be performed by a qualified person provided by discharger, and are to be performed a minimum of once every fourteen (14) calendar days and within twenty-four hours of any storm event of greater than 0.5 inches. Please note that an inspection required after a "storm event" does not replace the required bi-monthly inspection and is to be in addition to monthly scheduled inspections. Written reports shall be given to owner and appropriate inspector.

When damage repair to the erosion or sediment controls are needed, the work shall be performed within five (5) days of written notice from the Owner. If requested repairs are not performed within such five day period, the Owner shall employ a contractor to make the required repairs and will deduct such amount from the Contractor that damaged the controls.

Maintenance of controls shall be performed within five (5) days of written notice from the Owner to the Contractor responsible for the maintenance of such control.




III RE-VEGETATION

A. At the completion of the paving and final grading the entire disturbed area shall be re-vegetated with seeds and rates approved by the Owner.

B. All silt fence shall remain in place until re-vegetation has been completed.

C. Prior to final paving, each Contractor shall be responsible for removing any mud or silt that collects on the existing pavement as a result of their operations. After the installation of the new paving and prior to acceptance by the appropriate authority, the paving Contractor shall be responsible for removing any mud or silt that collects on the existing and new pavement. After acceptance by the appropriate authority, the Owner shall be responsible for removal of the mud or silt that collects on the pavement.

D. 75%-80% of disturbed areas shall have 1" tall grass prior to City acceptance.

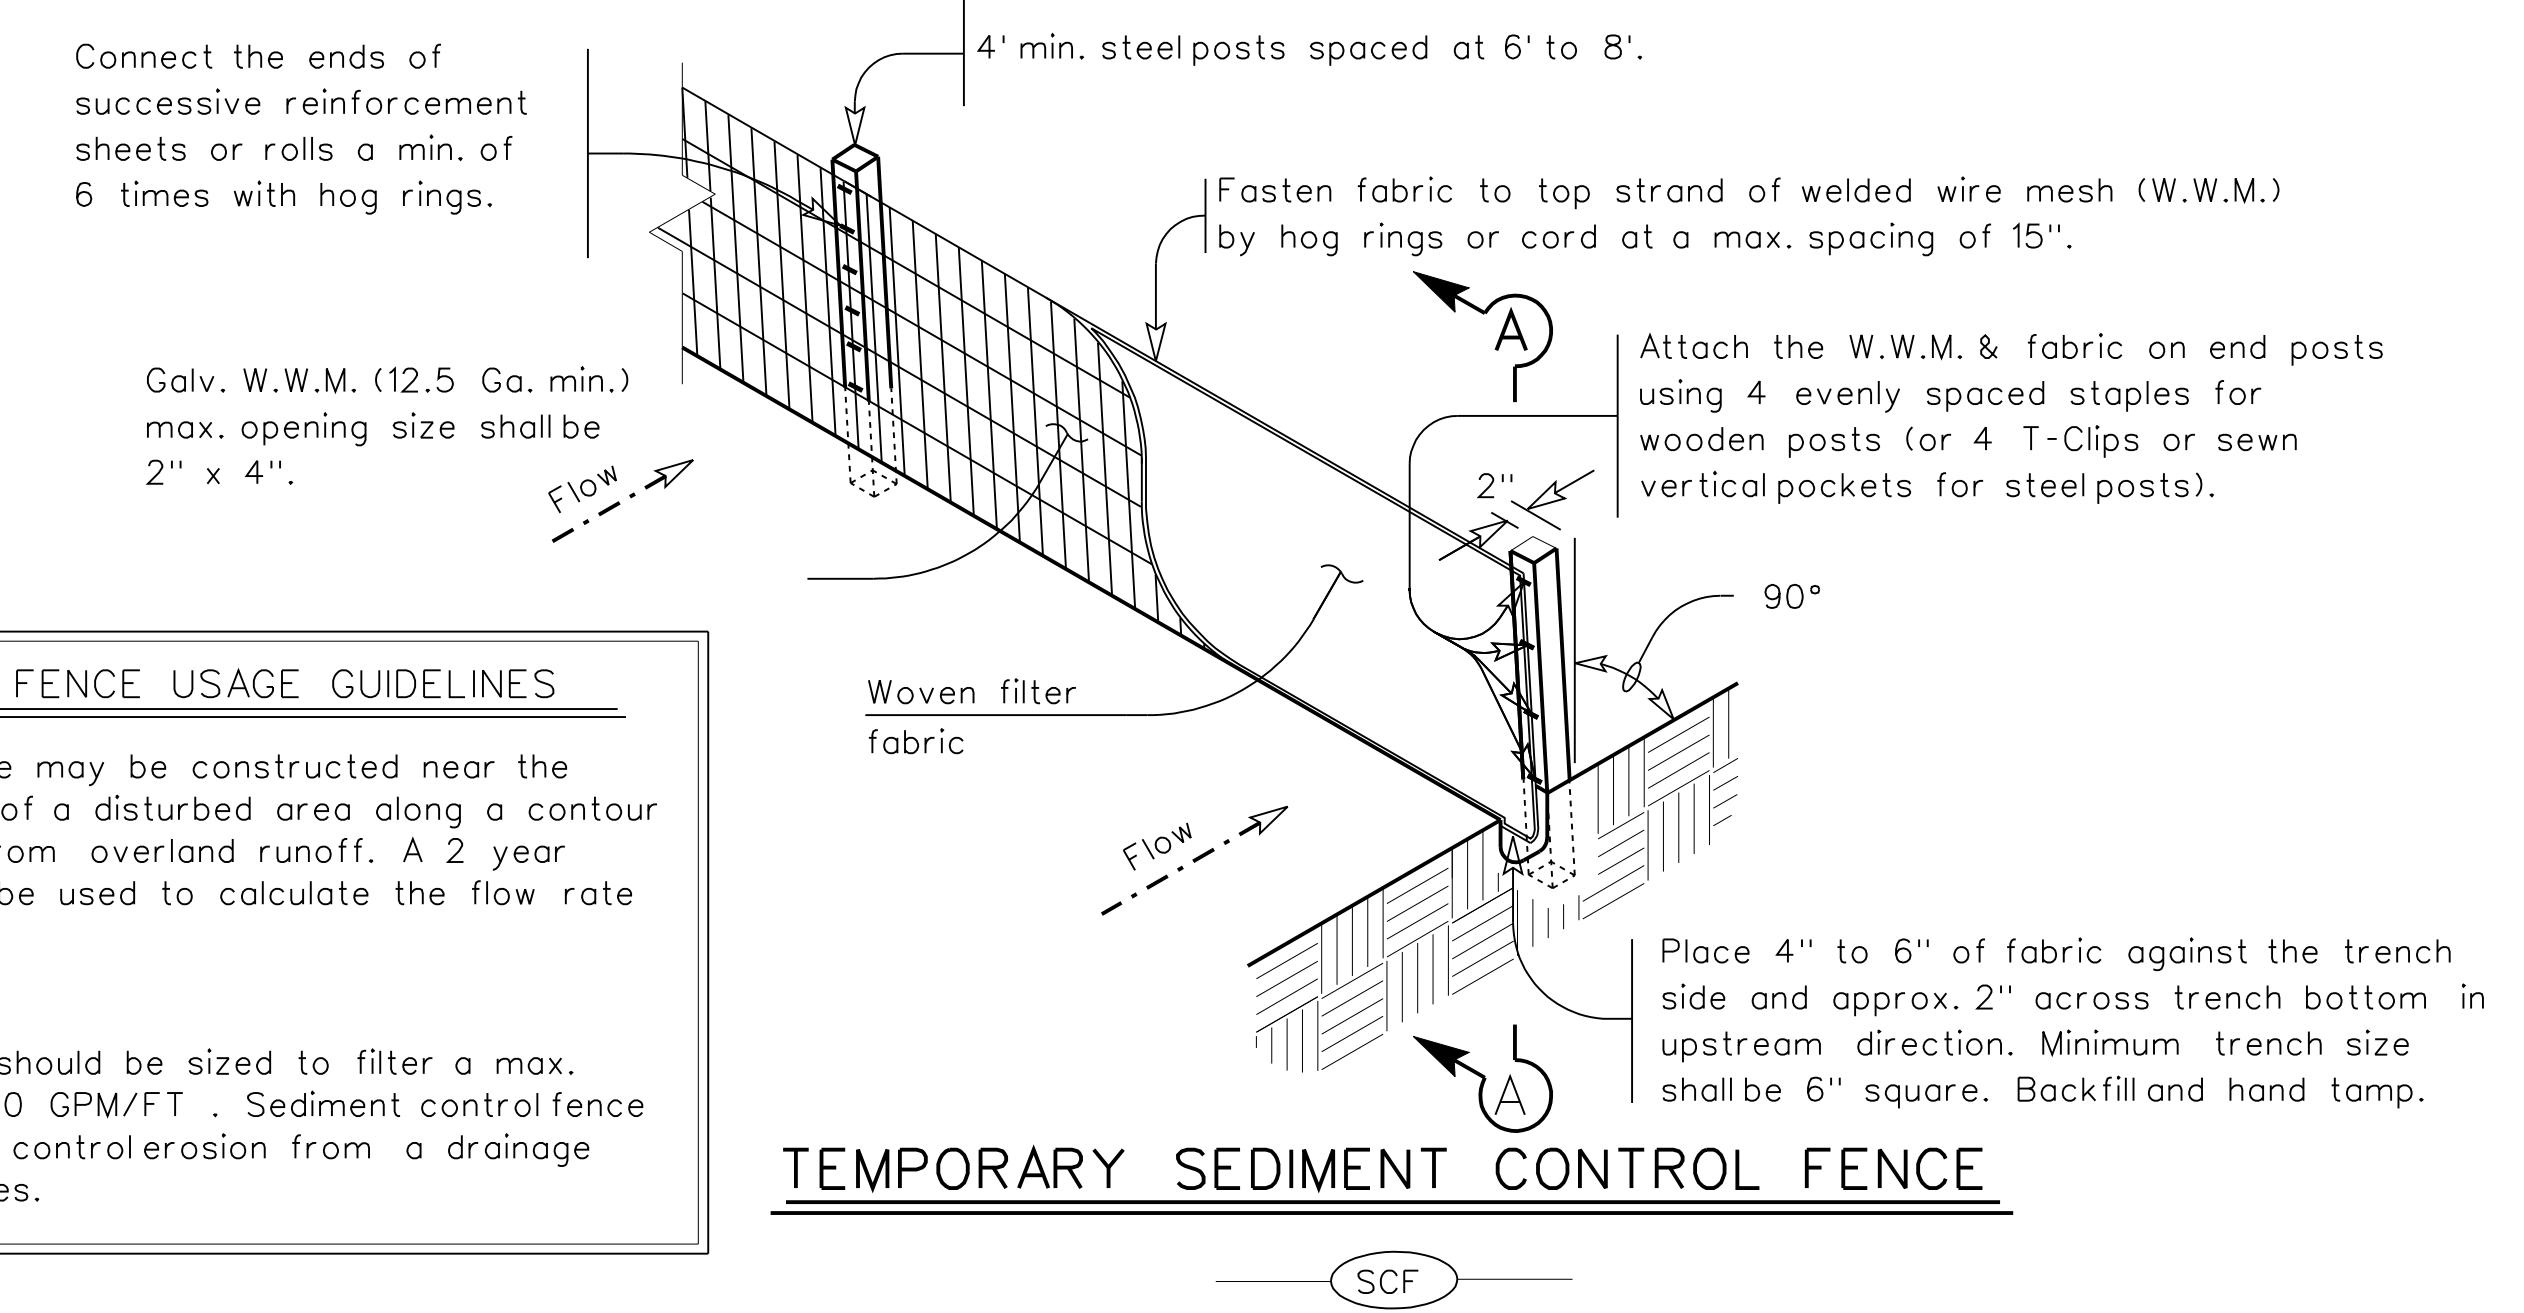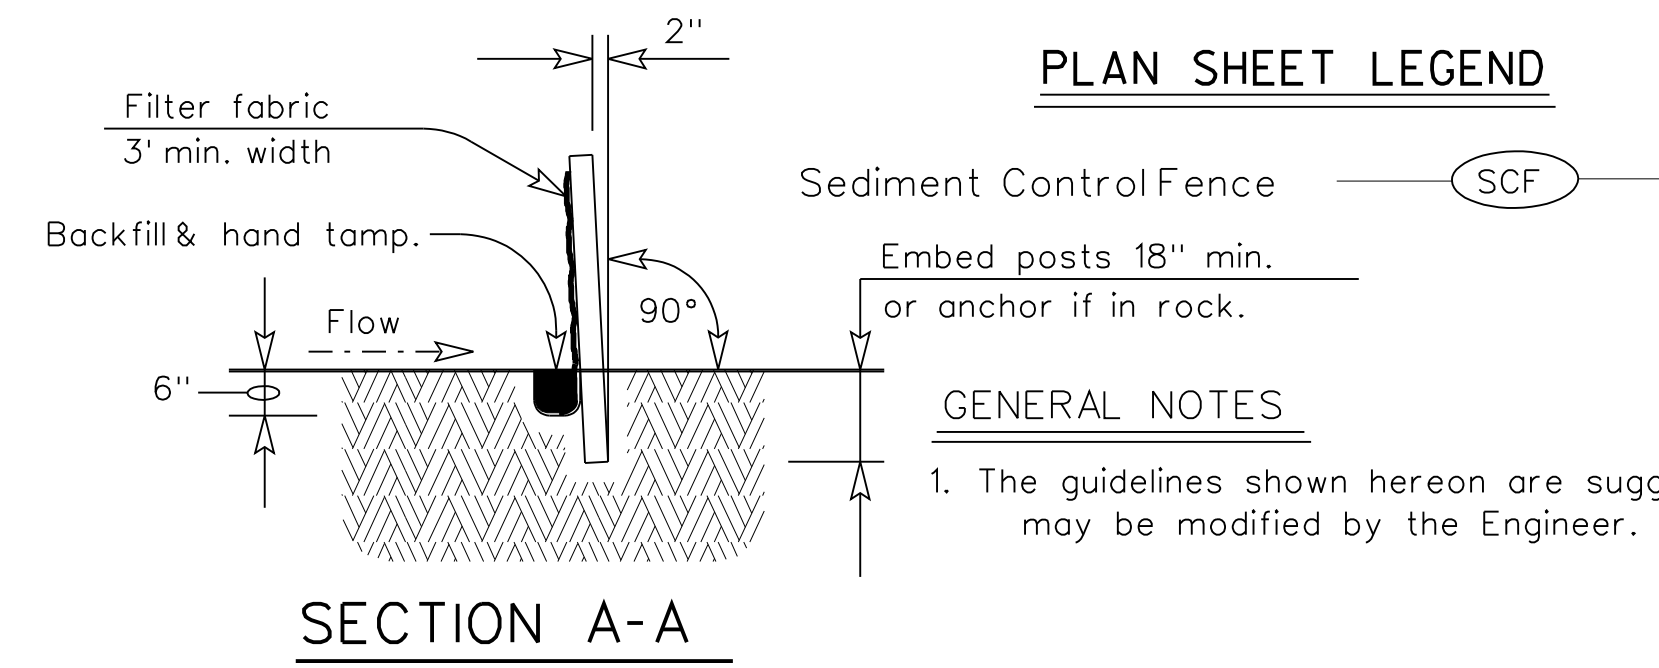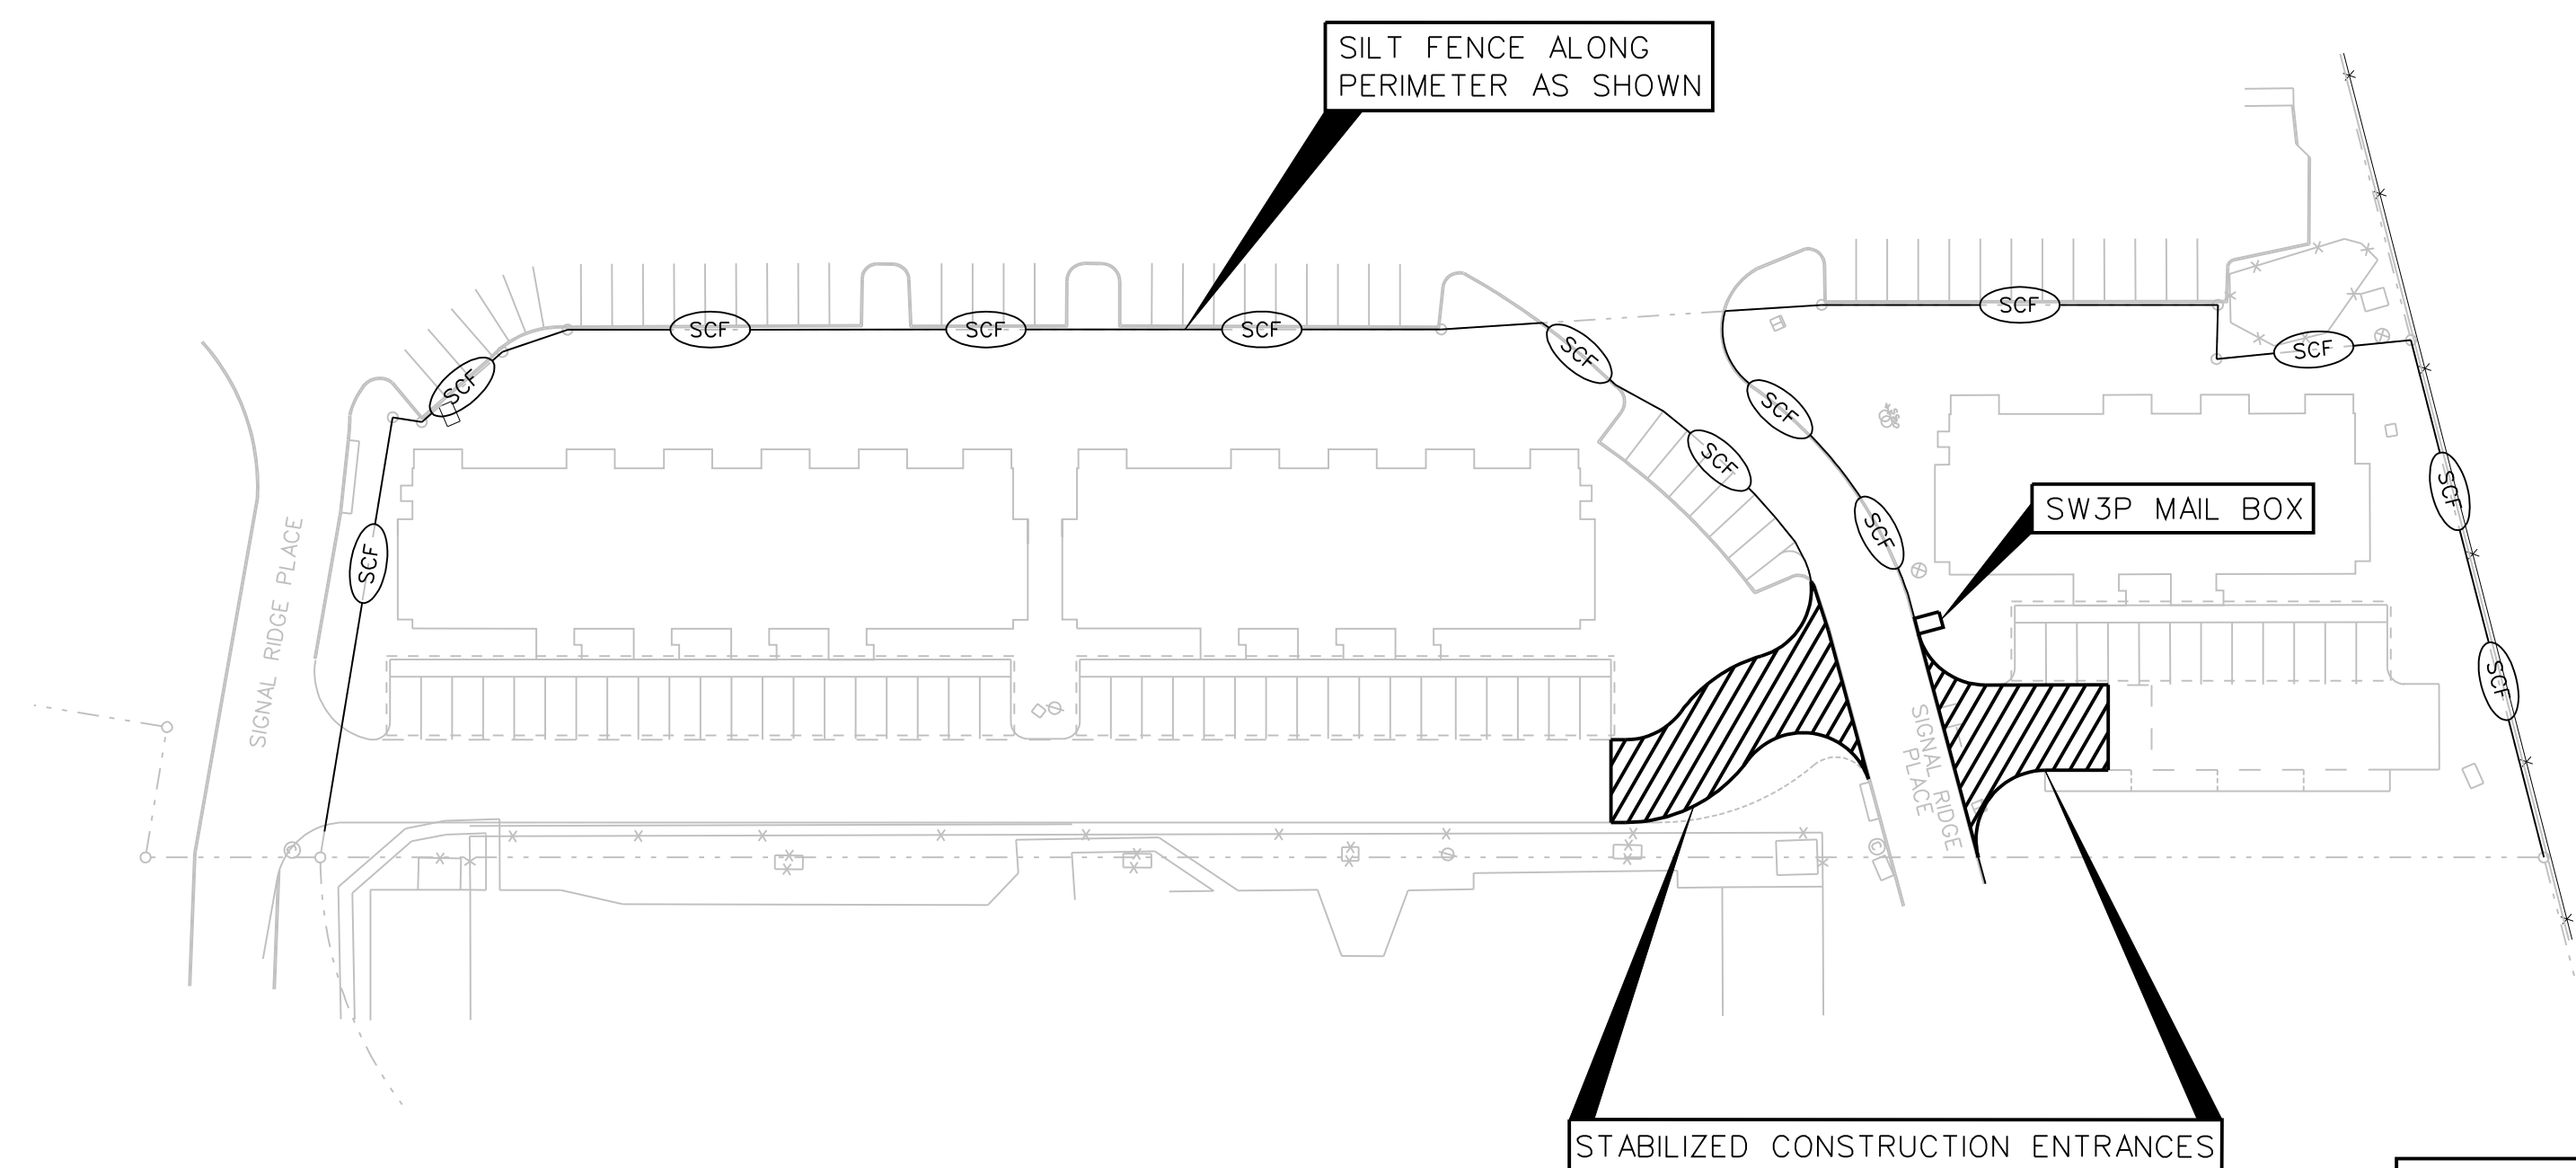


SEDIMENT CONTROL FENCE USAGE GUIDELINES

A sediment control fence may be constructed near the downstream perimeter of a disturbed area along a contour to intercept sediment from overland runoff. A 2 year storm frequency may be used to calculate the flow rate to be filtered.


Sediment control fence should be sized to filter a max. flow through rate of 100 GPM/FT. Sediment control fence is not recommended to control erosion from a drainage area larger than 2 acres.

NOTE:
TO THE BEST OF OUR KNOWLEDGE ERIC L. DAVIS ENGINEERING, INC., HEREBY STATES THAT THIS PLAN IS AS-BUILT. THE INFORMATION PROVIDED IS BASED ON SURVEYING CONDUCTED AT THE SITE AND INFORMATION PROVIDED BY THE CONTRACTOR.

Signal Ridge Place_10_sw3p_PlanAB.dgn
PLOTTED BY: David
6/2/2008 3:00:53 PM

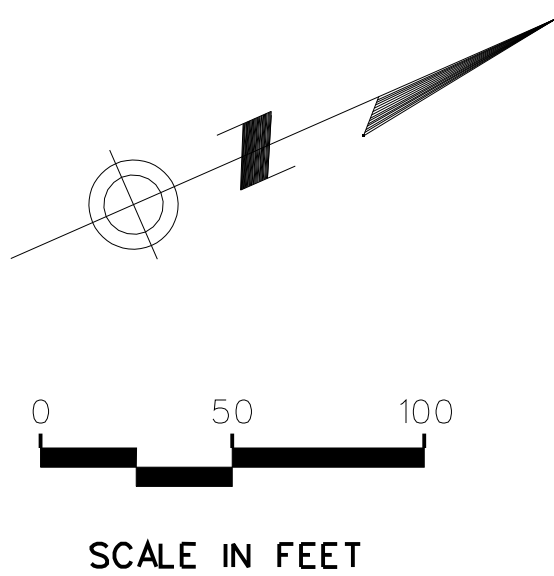

DATE	BY	REV	REVISION

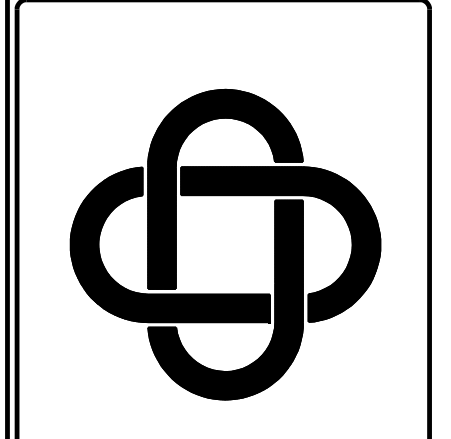

ERIC L. DAVIS
ENGINEERING, INC.
425 Pinson Road Ste. C
Forney, Texas 75126
972/564-0592 Fax 972/564-6523
E-Mail eric.davis@eldengineering.com

TEMPORARY EROSION
CONTROL PLAN/STANDARDS
SIGNAL RIDGE PLACE
CITY OF ROCKWALL, ROCKWALL CO, TX

DEVELOPER:	
JOB NO.:	
DRAWN BY:	
CHECKED BY:	
DATE:	

AS-BUILT

SCALE: N/A
SHEET 10 OF 12
SHEET 10