


DRAINAGE AREA MAP
SMITTY'S ROADHOUSE GRILLE
CITY OF ROCKWALL, TEXAS

RECORD DRAWING

No.	Date	Revision
1	6/07/06	REVISED PARKING LOT

Scale: 1"=20'
File Name: bbqsite
Date: FEB. 2006
Project No.: 28108

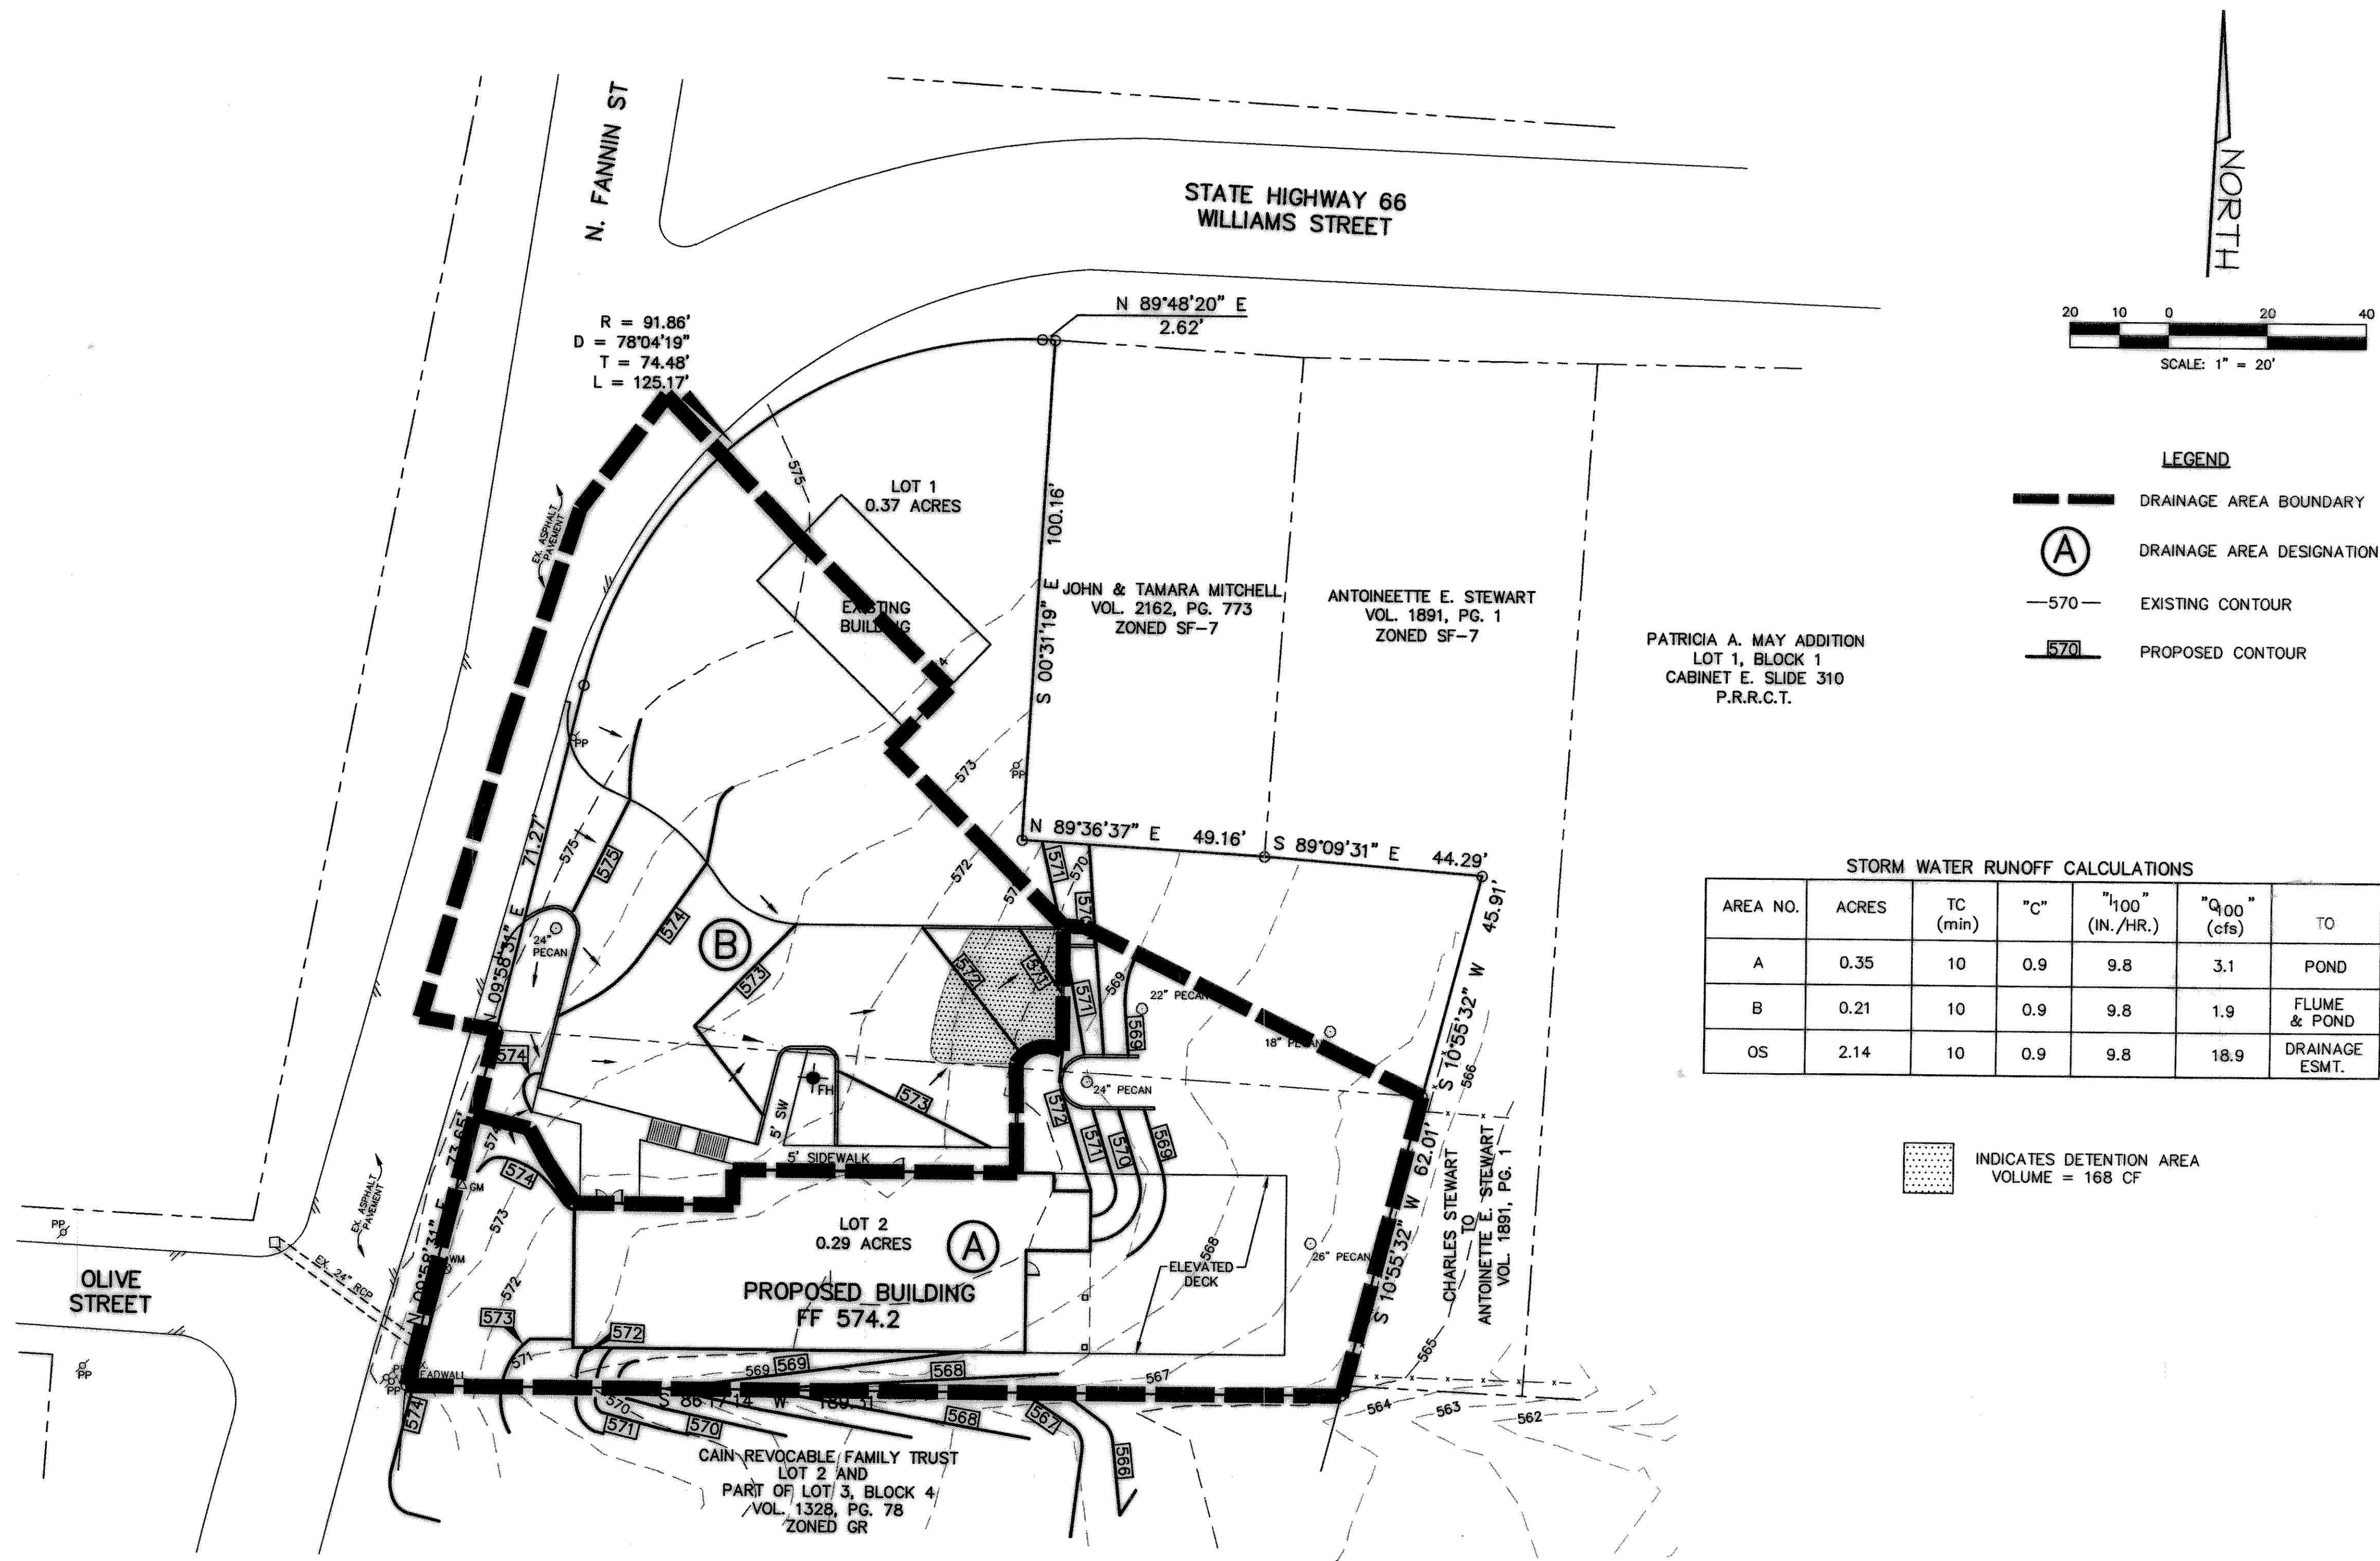

OFFSITE DRAINAGE AREA MAP
SCALE: 1"=60'

BENCHMARK: TOP OF EX. SANITARY SEWER MANHOLE RIM LOCATED 7± WEST OF THE SOUTHWEST PROPERTY CORNER.
ELEV. 575.05

RECORD DRAWING

IMPROVEMENTS INDICATED ON THIS PLAN WHERE MADE IN ACCORDANCE WITH THE PROJECT PLANS & SPECIFICATIONS. THE DESIGN ENGINEER IS NOT AWARE OF ANY CHANGES TO THESE PLANS OTHER THAN THOSE INDICATED.

DATE: MARCH 20, 2007