


City of Rockwall, Texas


PROPOSED IMPROVEMENTS TO SERVE

LOT 1, BLOCK A, SONG ADDITION

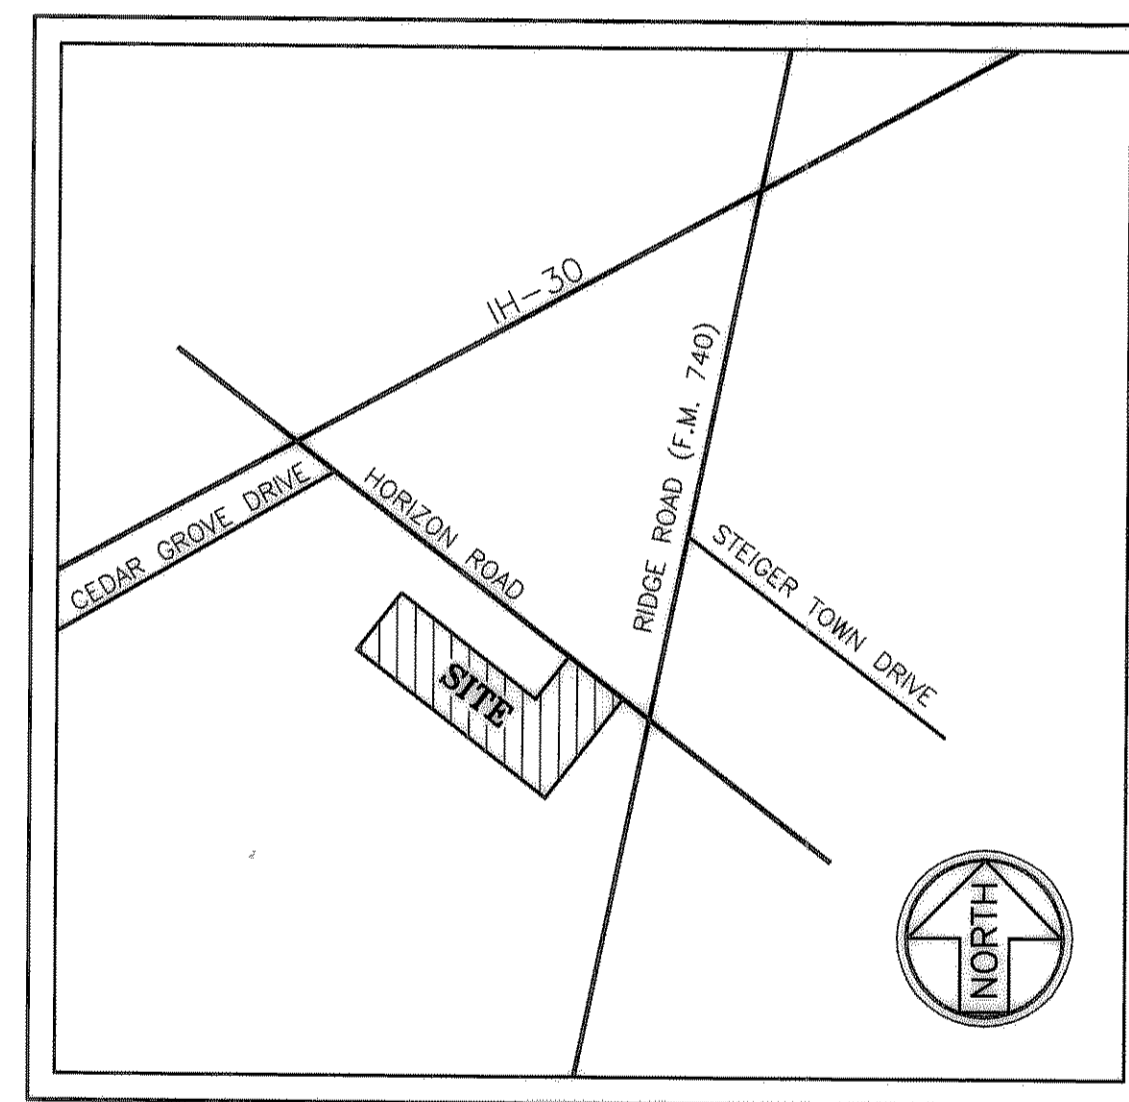

VICINITY MAP
(N.T.S.)

OWNER/DEVELOPER
WHO-IKE SONG
7513 WELLESLEY AVENUE
GARLAND, TX 75044
TEL : (972) 530-8894
FAX : (214) 328-7817

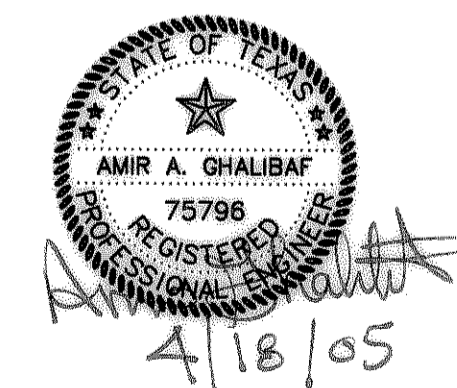

INDEX

**LOT 1, BLOCK A, SONG ADDITION
PAVING, DRAINAGE, WATER
AND SANITARY SEWER
IMPROVEMENTS
DMG FILE 02-144**

SHEET NO.	DESCRIPTION
1	COVER SHEET
2	FINAL PLAT
3	SITE PLAN AND DIMENSION CONTROL PLAN
4	PAVING AND GRADING PLAN
5	DRAINAGE AREA MAP AND CALCULATIONS
6	DETENTION POND
7	WATER AND SEWER SERVICE PLAN
8	WATER AND SEWER DETAILS
9	EROSION CONTROL PLAN
10	EROSION CONTROL DETAILS
11	LANDSCAPE PLAN

DMG ASSOCIATES, INC.
CIVIL ENGINEERING * PLANNING * CONSTRUCTION MANAGEMENT
2908 COTTONWOOD LANE
COLLEYVILLE, TEXAS 76034
TEL (817) 457-9704
FAX (817) 571-3979

RECORD DRAWINGS

DMG FILE NO.: 02-144