


DMG ASSOCIATES, INC.
CIVIL ENGINEERING * PLANNING * CONSTRUCTION MANAGEMENT
2908 COTTONWOOD LANE
COLLEYSVILLE, TEXAS 76034
TEL (817) 457-9704
FAX (817) 571-3979

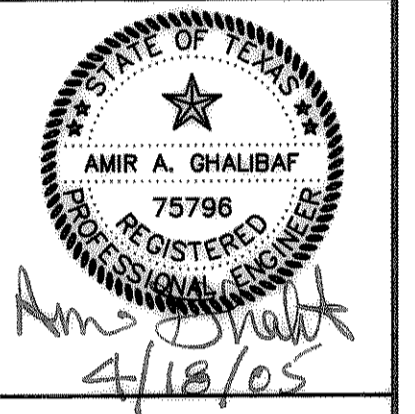

PAVING AND GRADING PLAN
LOT 1, BLOCK A, SONG ADDITION
CITY OF ROCKWALL,
ROCKWALL COUNTY, TEXAS

DESIGN	AAG	CAD	AAG	DATE	JULY, 2004	PROJECT	02-144
SHEET	4	OF	11				

RECORD DRAWINGS