

TO THE BEST OF OUR KNOWLEDGE AND ENGINEERING, WE HEREBY STATE THAT THIS PLAN IS AS-BUILT. THIS INFORMATION PROVIDED IS BASED ON SURVEYING AT THE SITE AND INFORMATION PROVIDED BY THE CONTRACTOR.

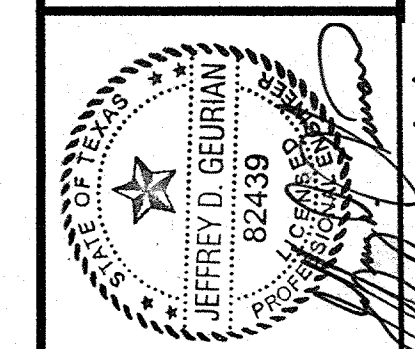
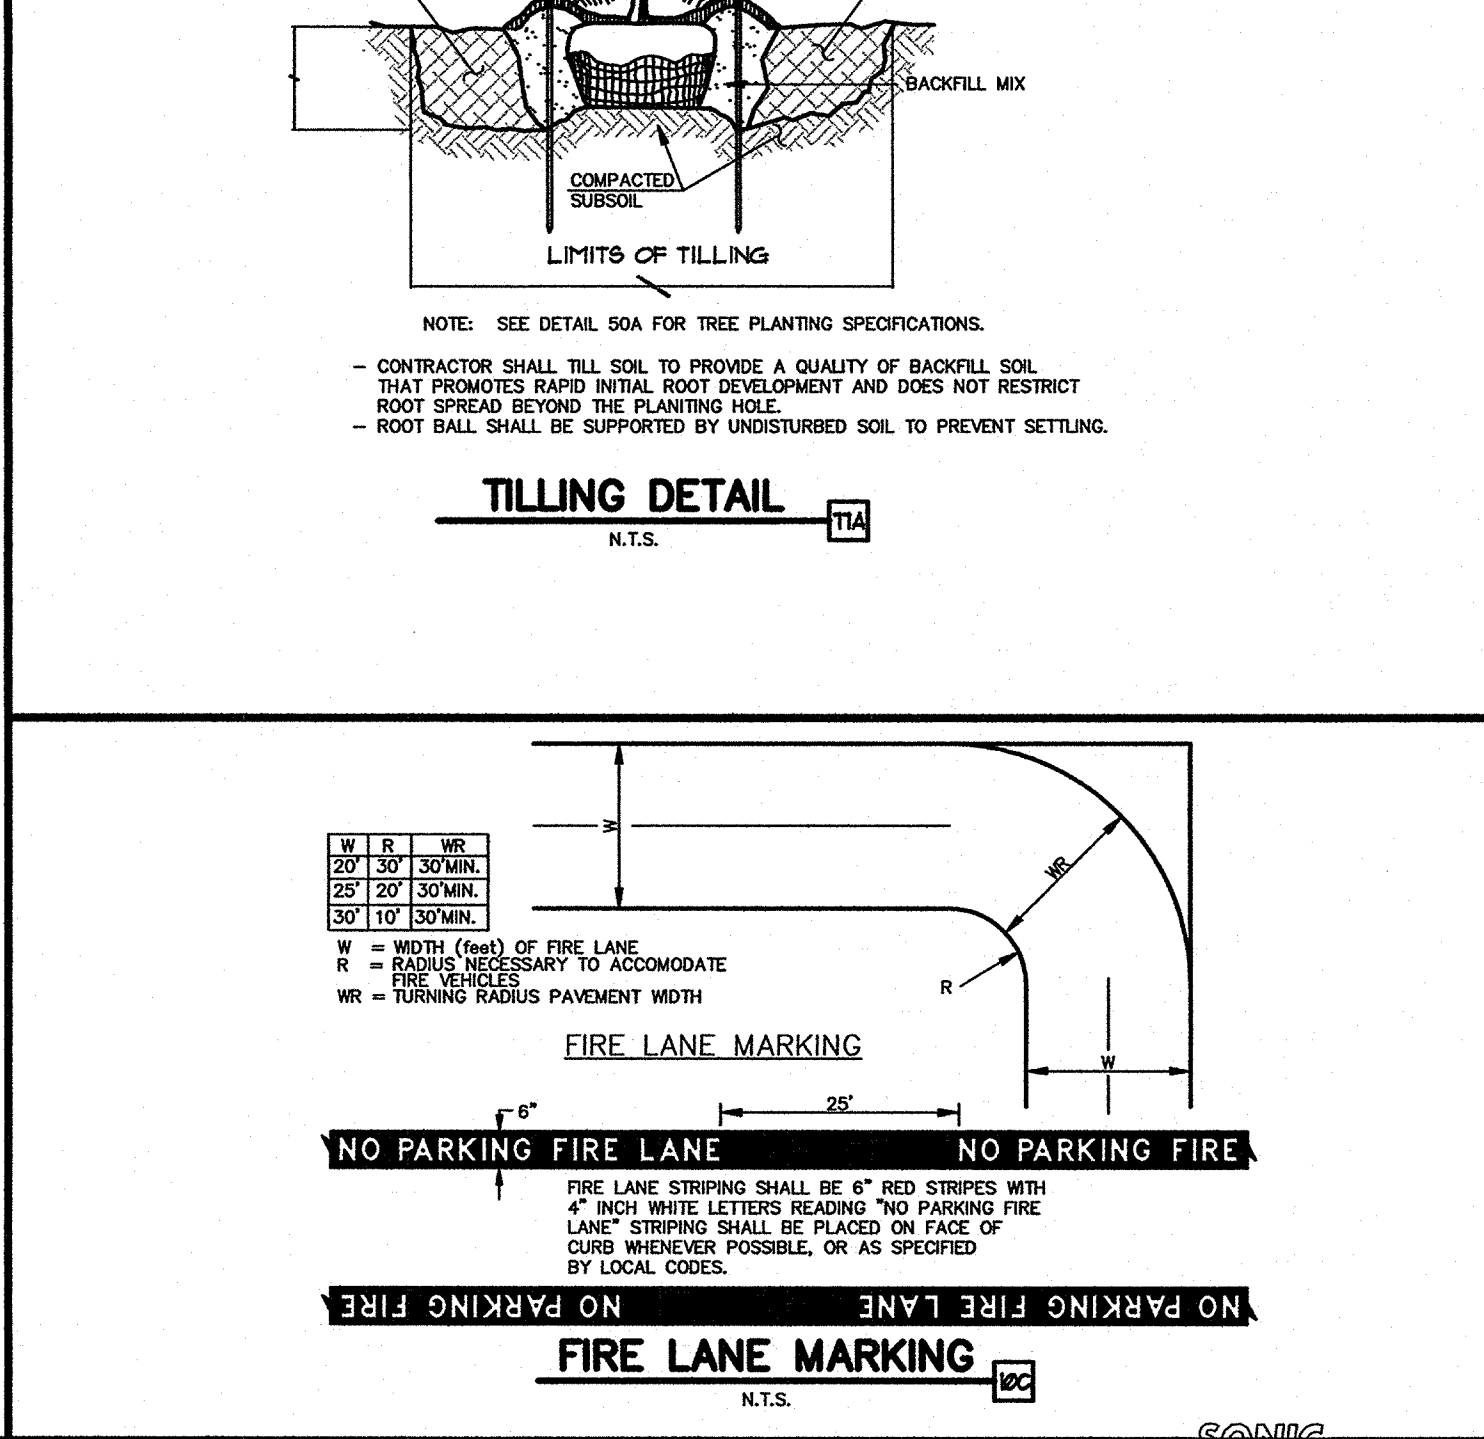
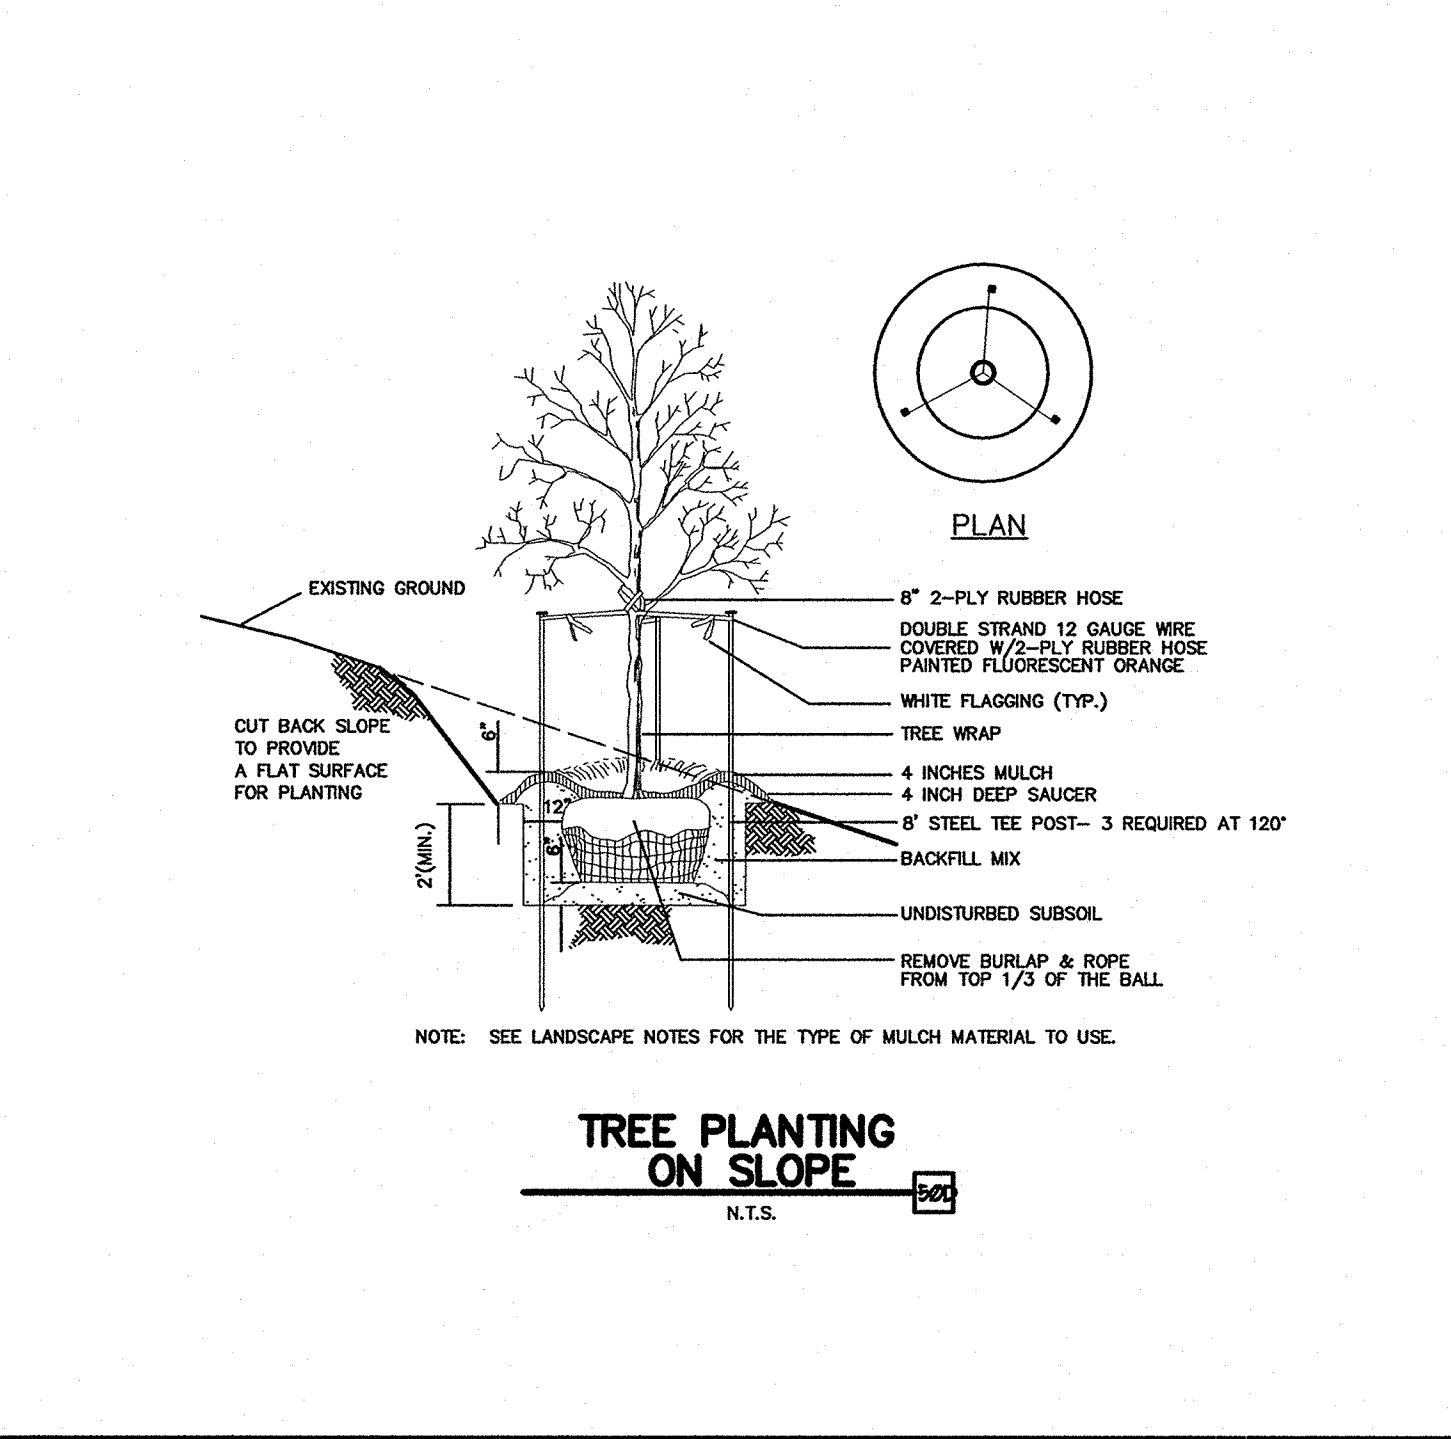
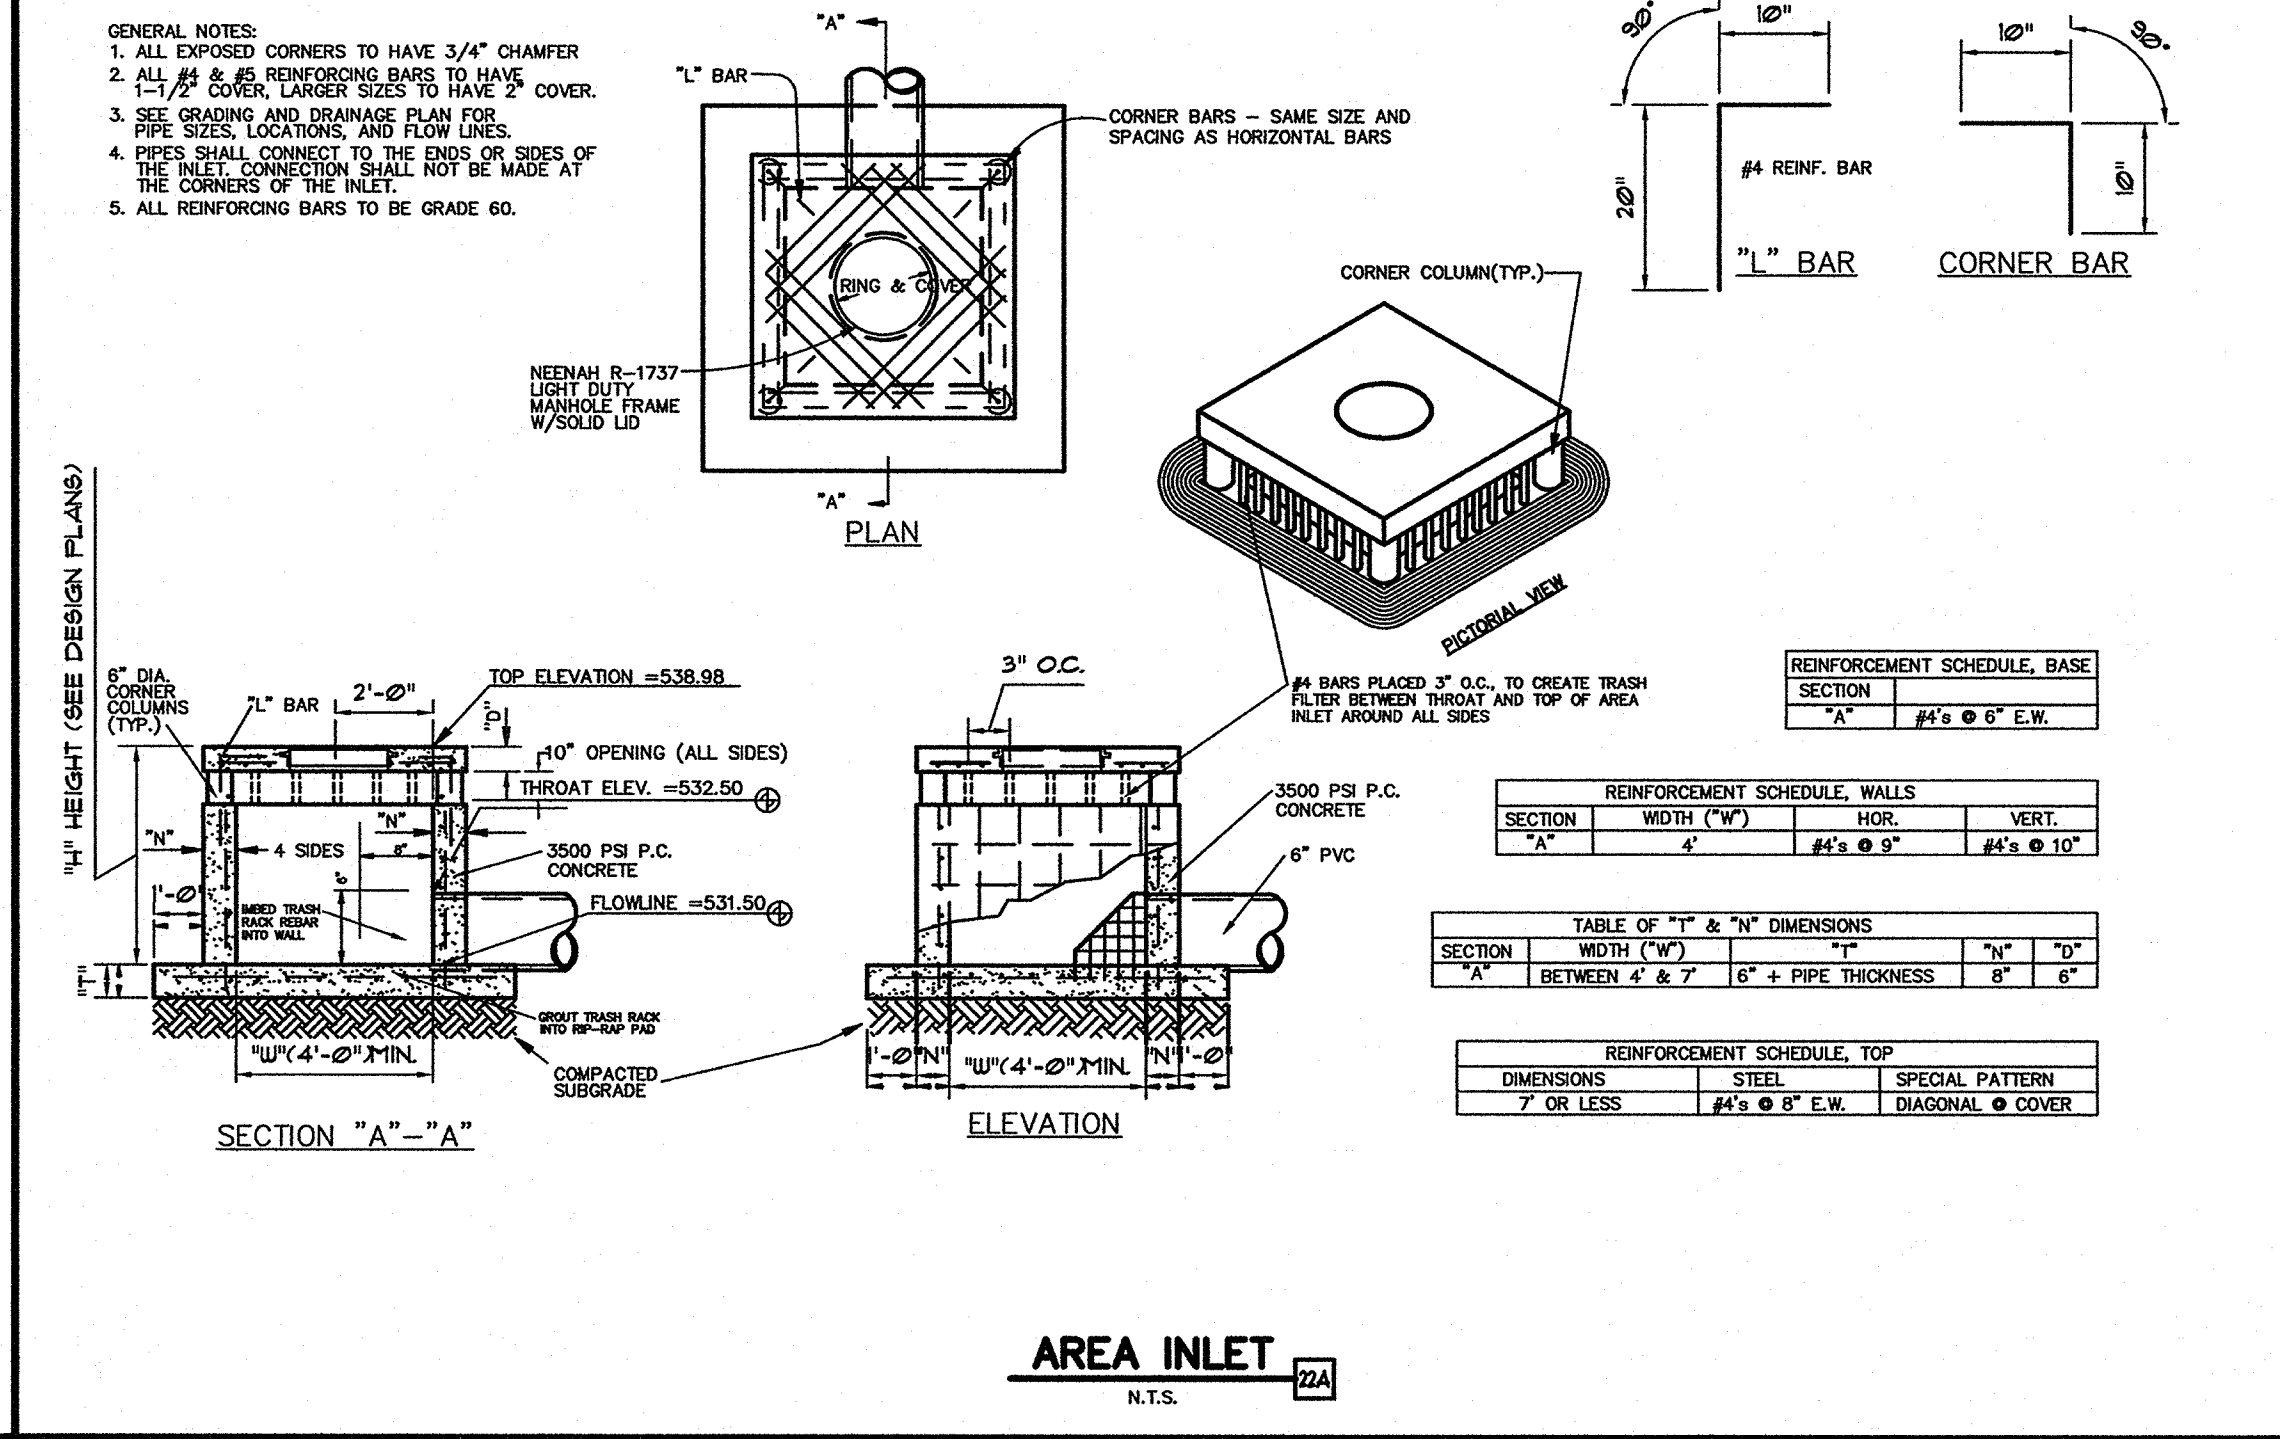
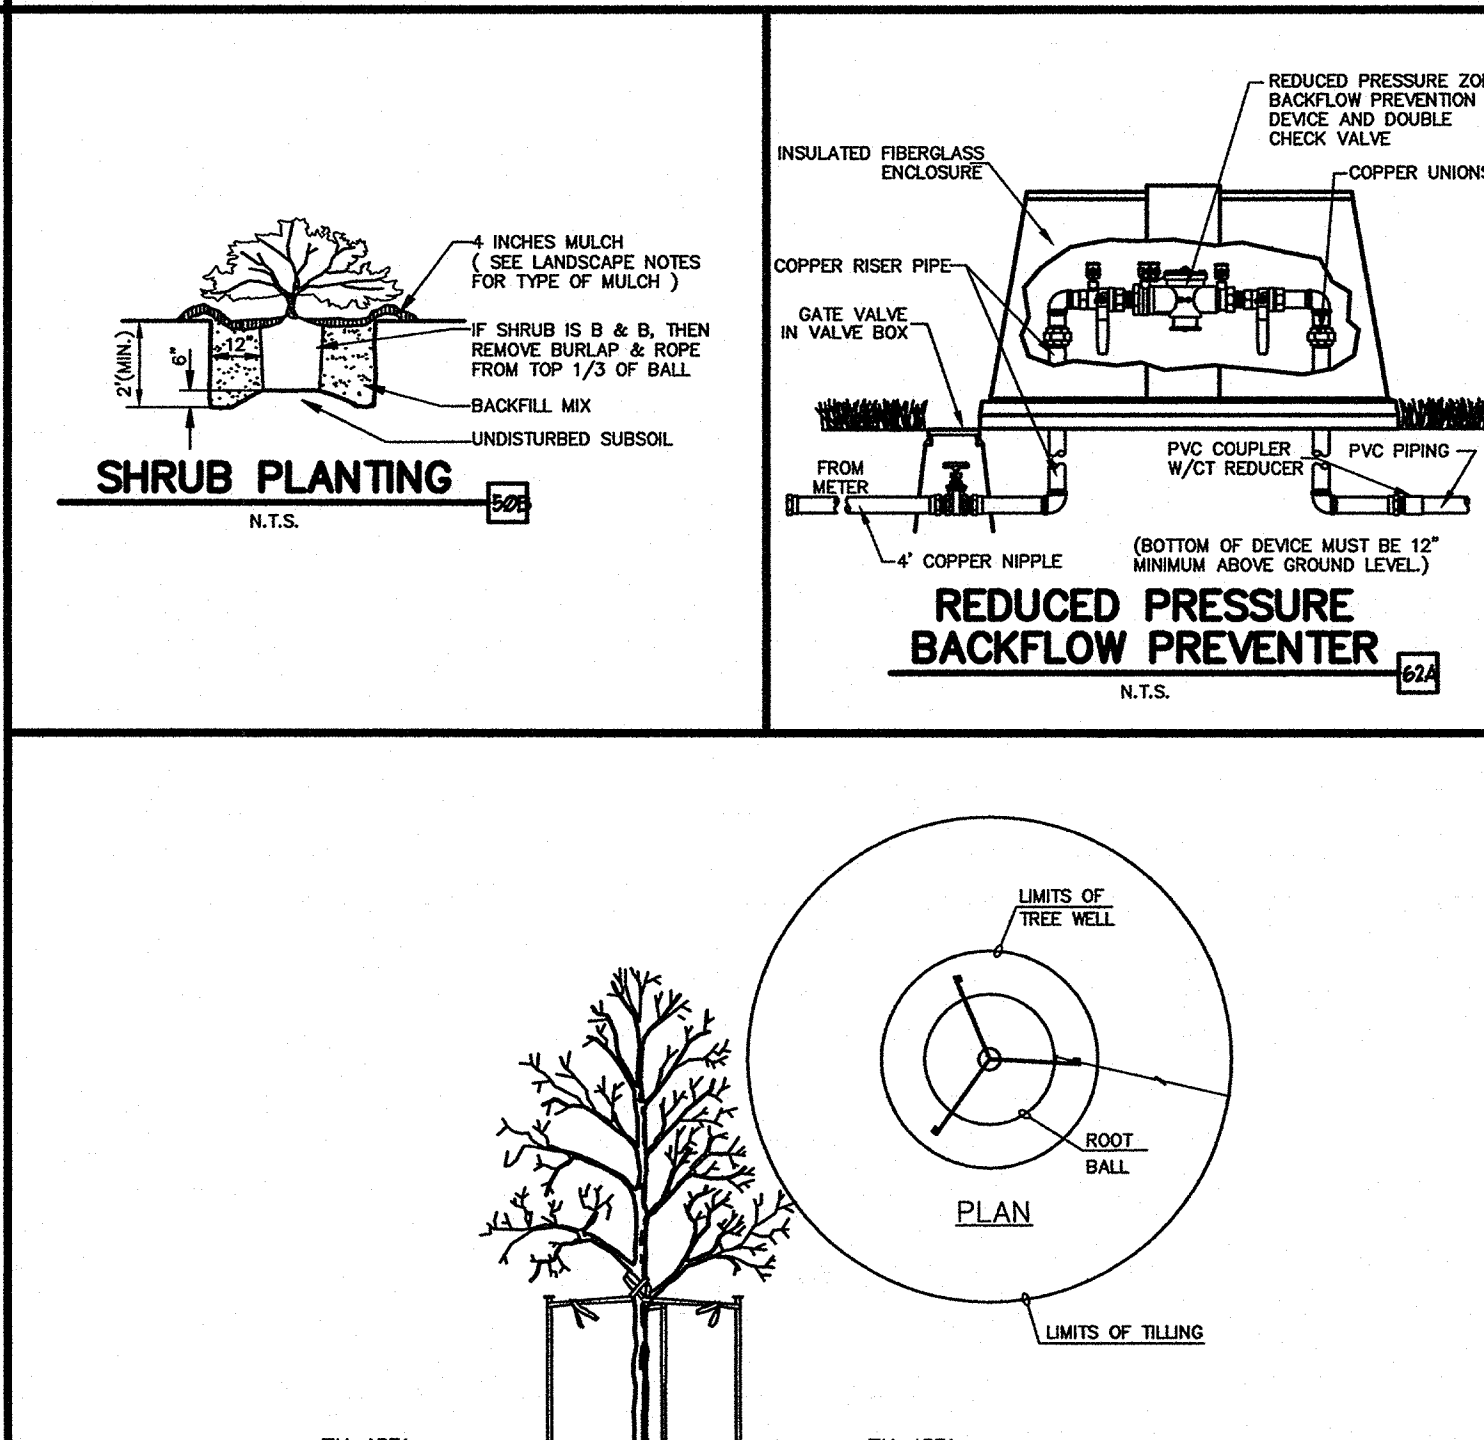
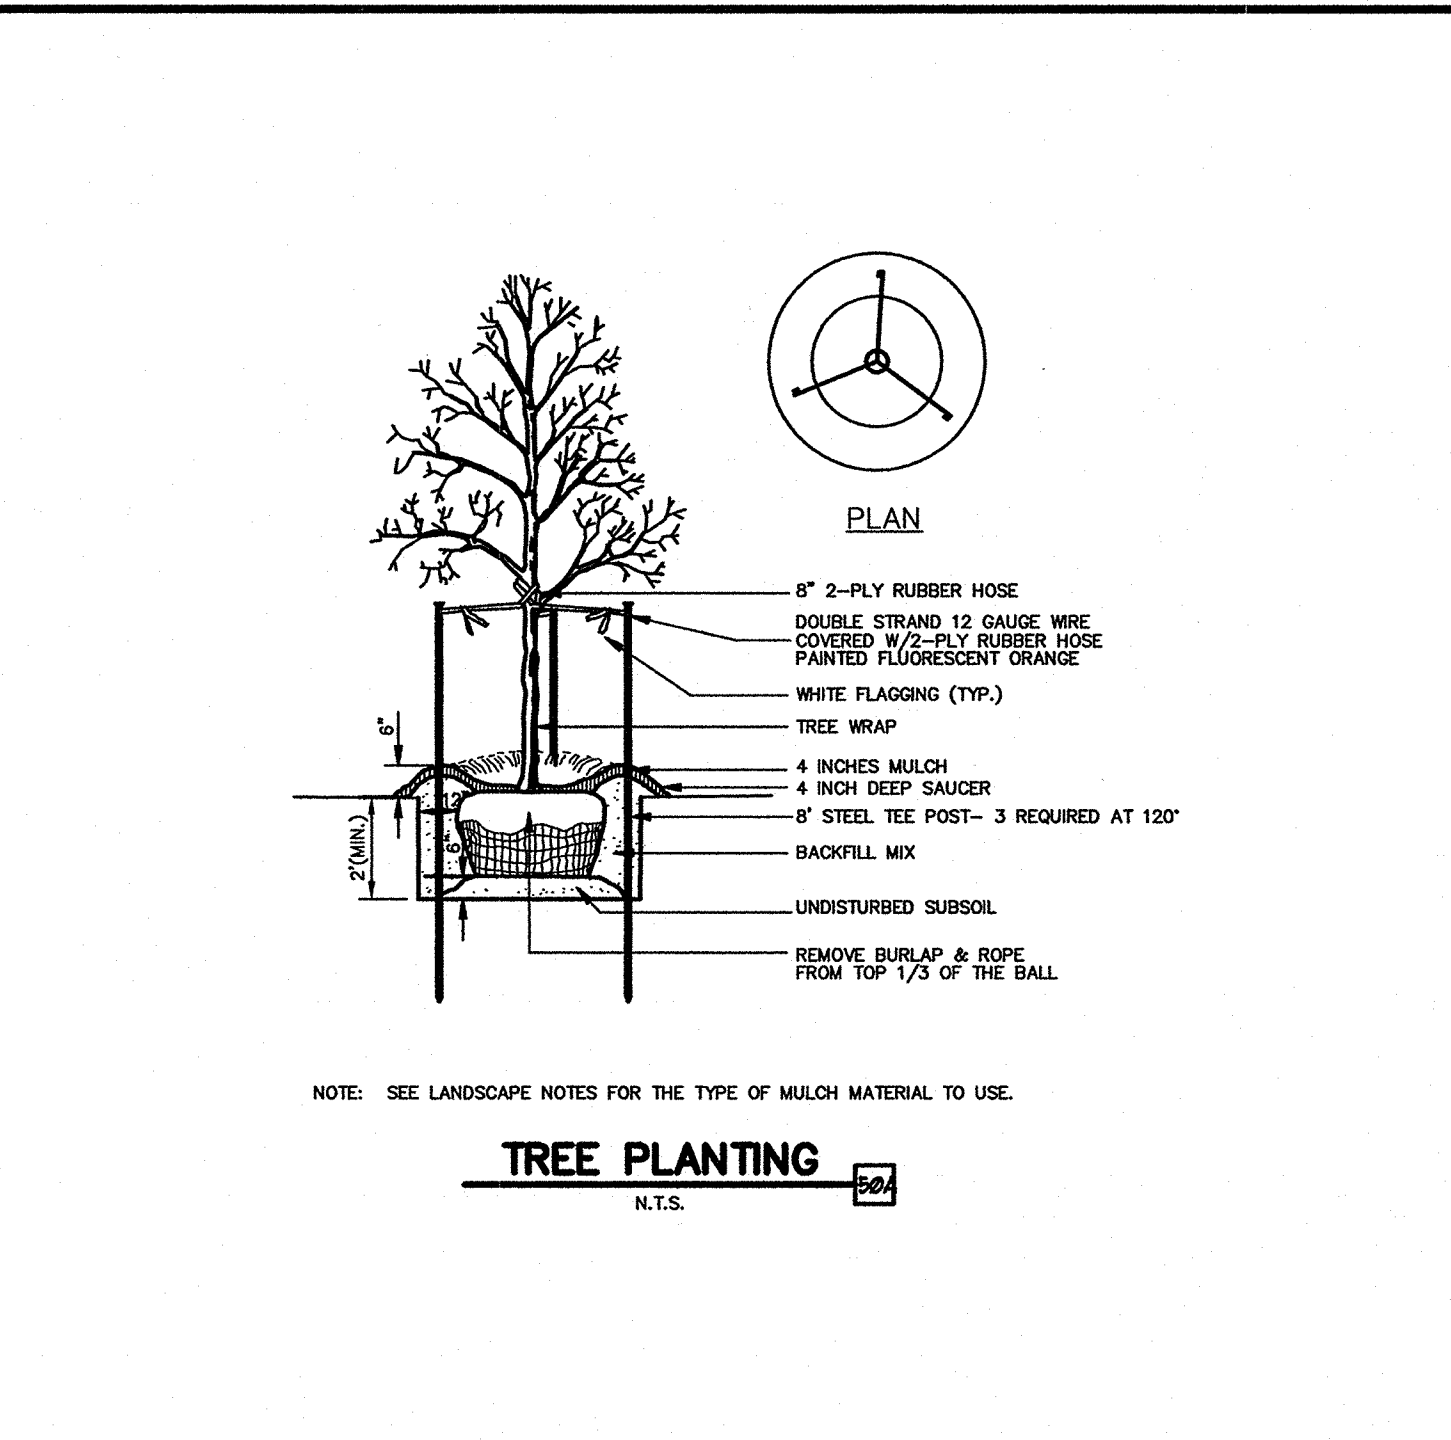
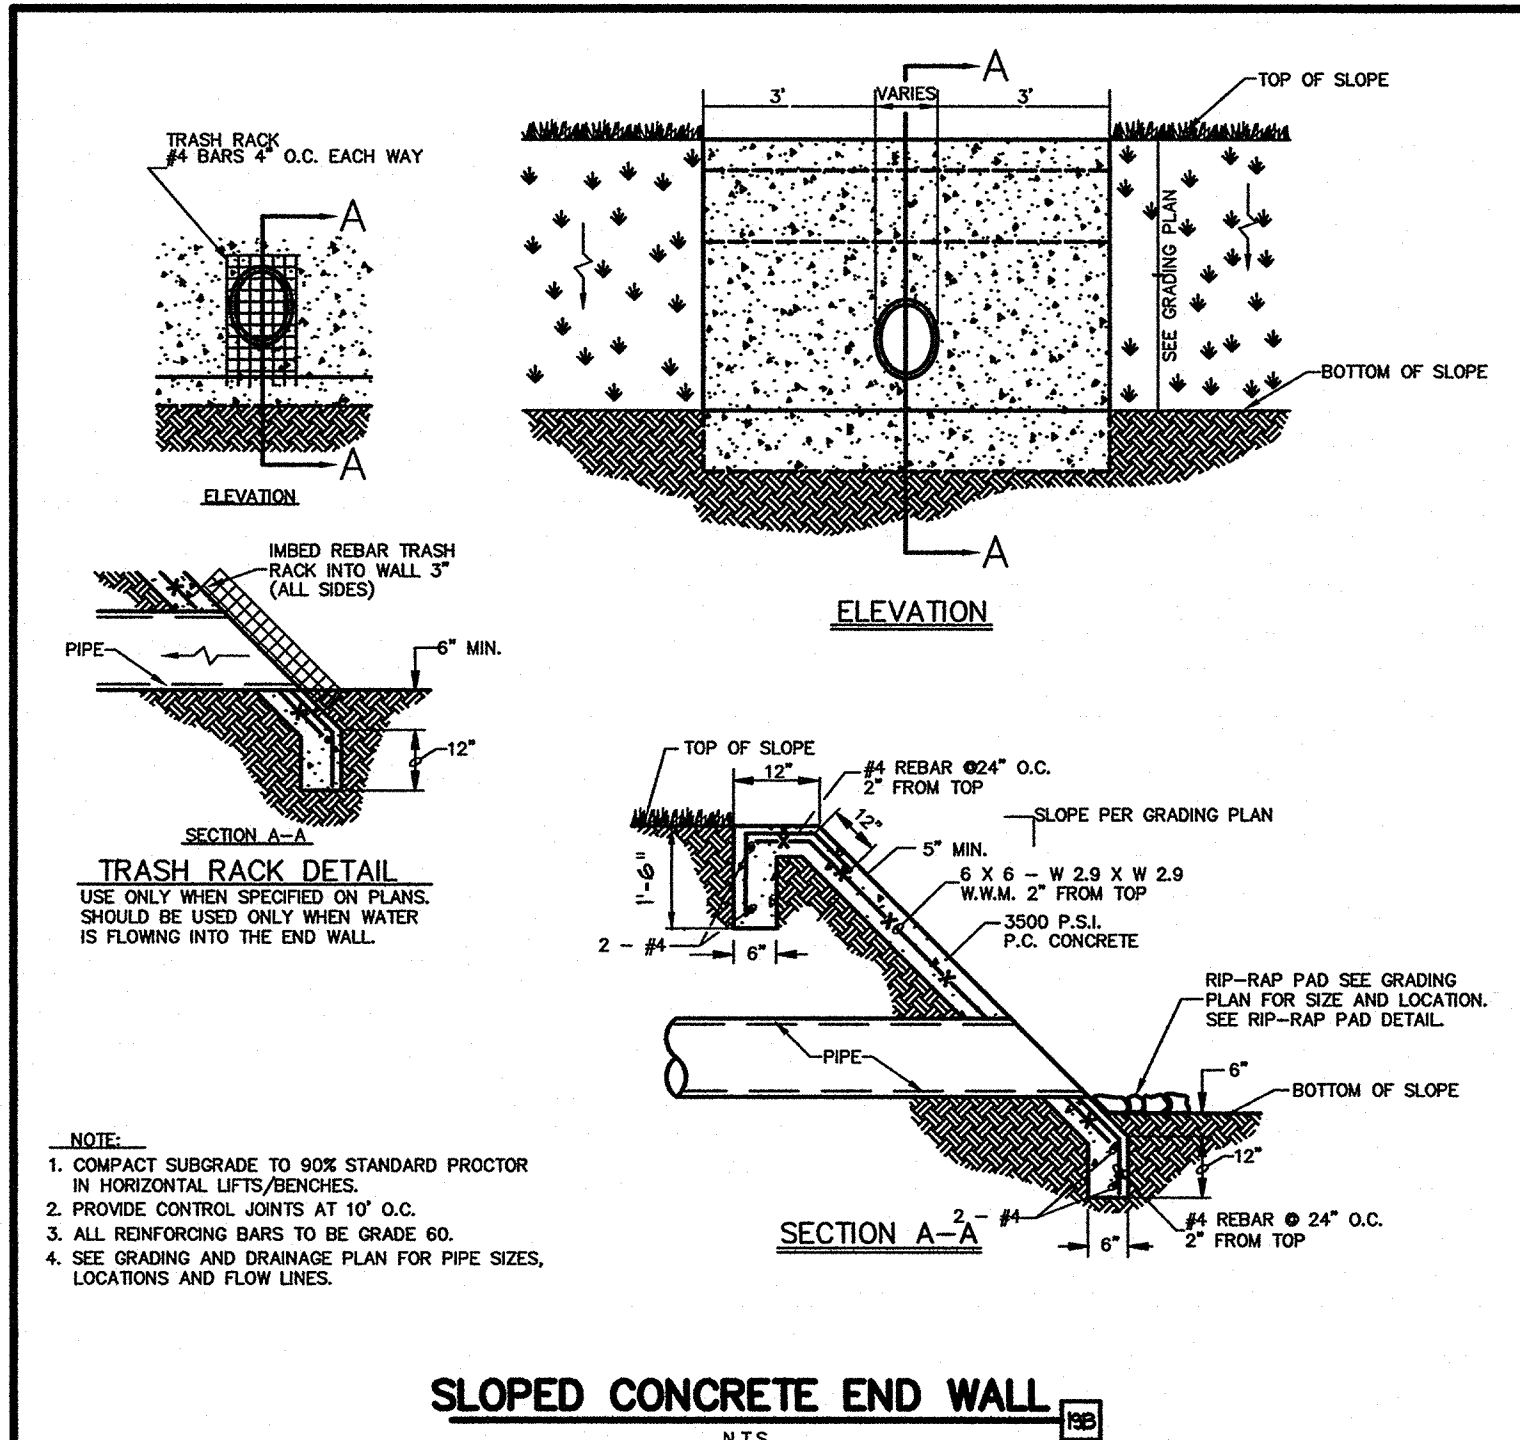
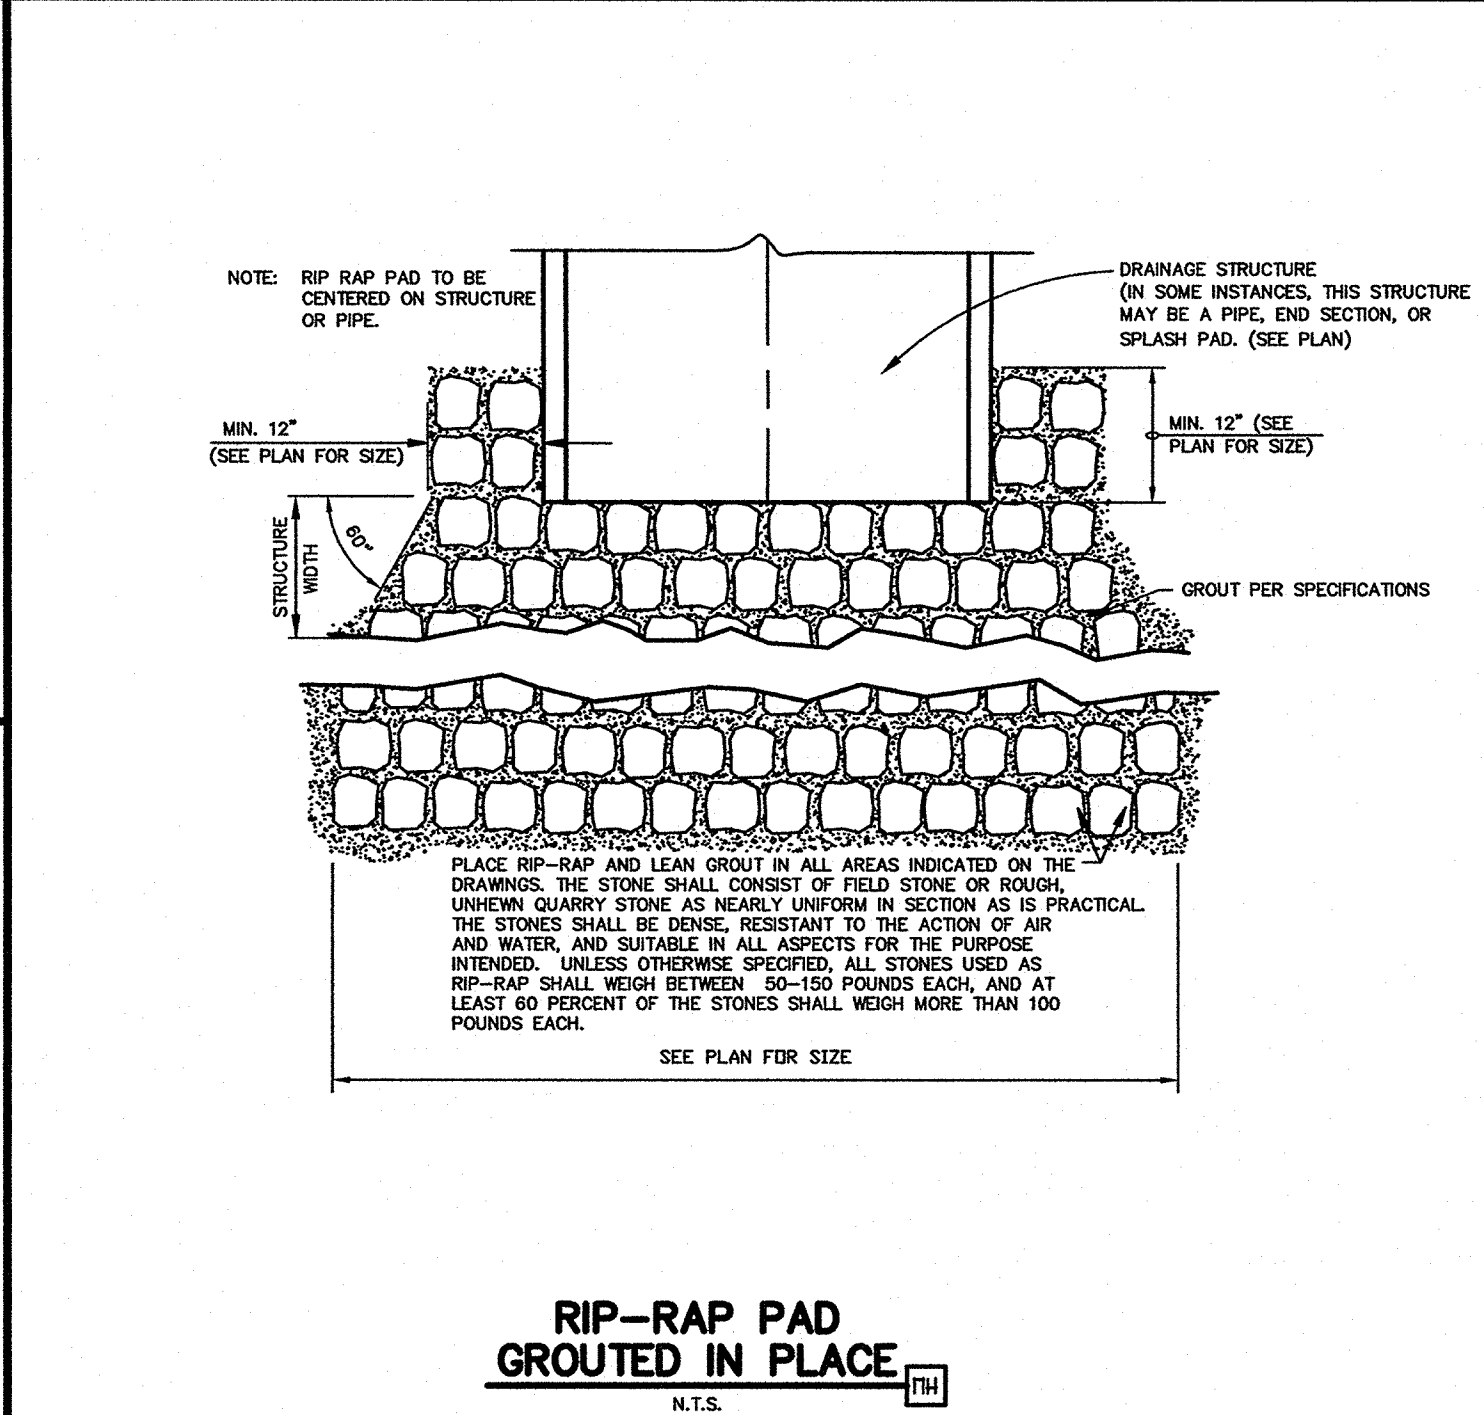
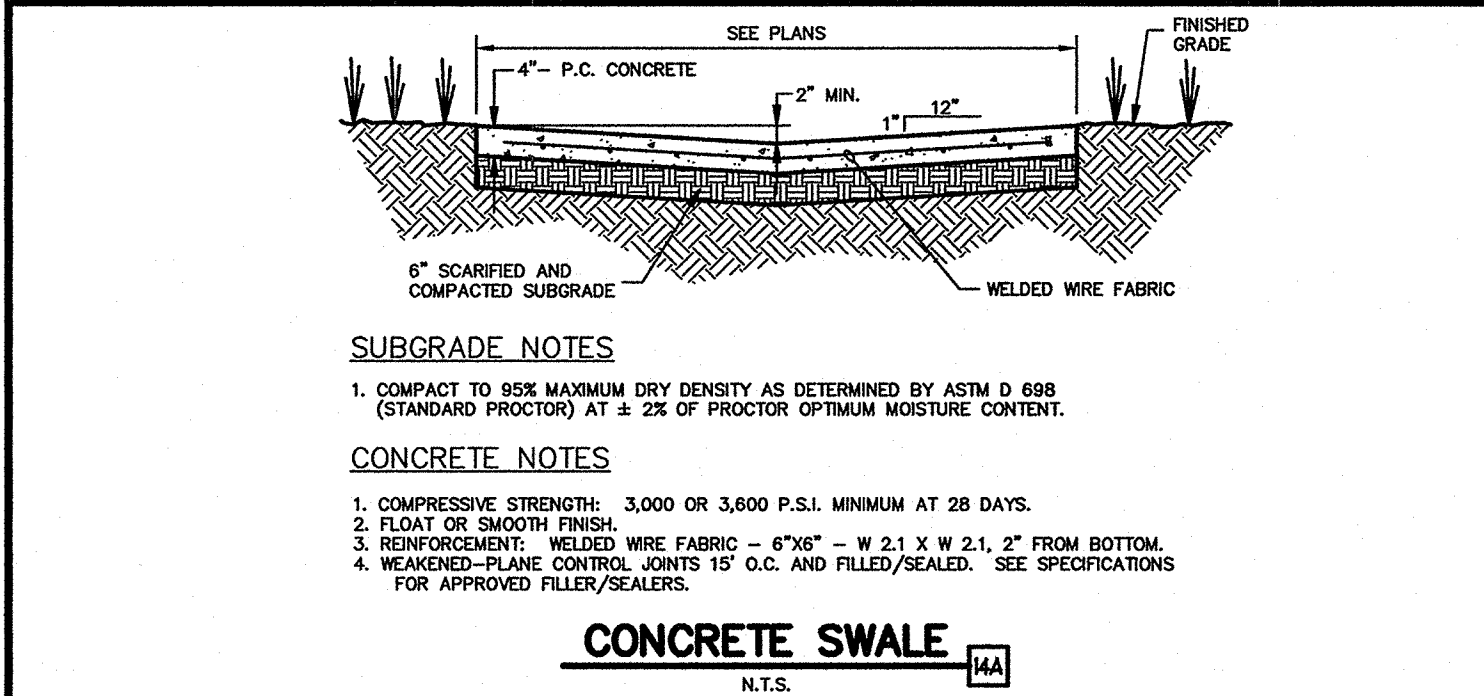
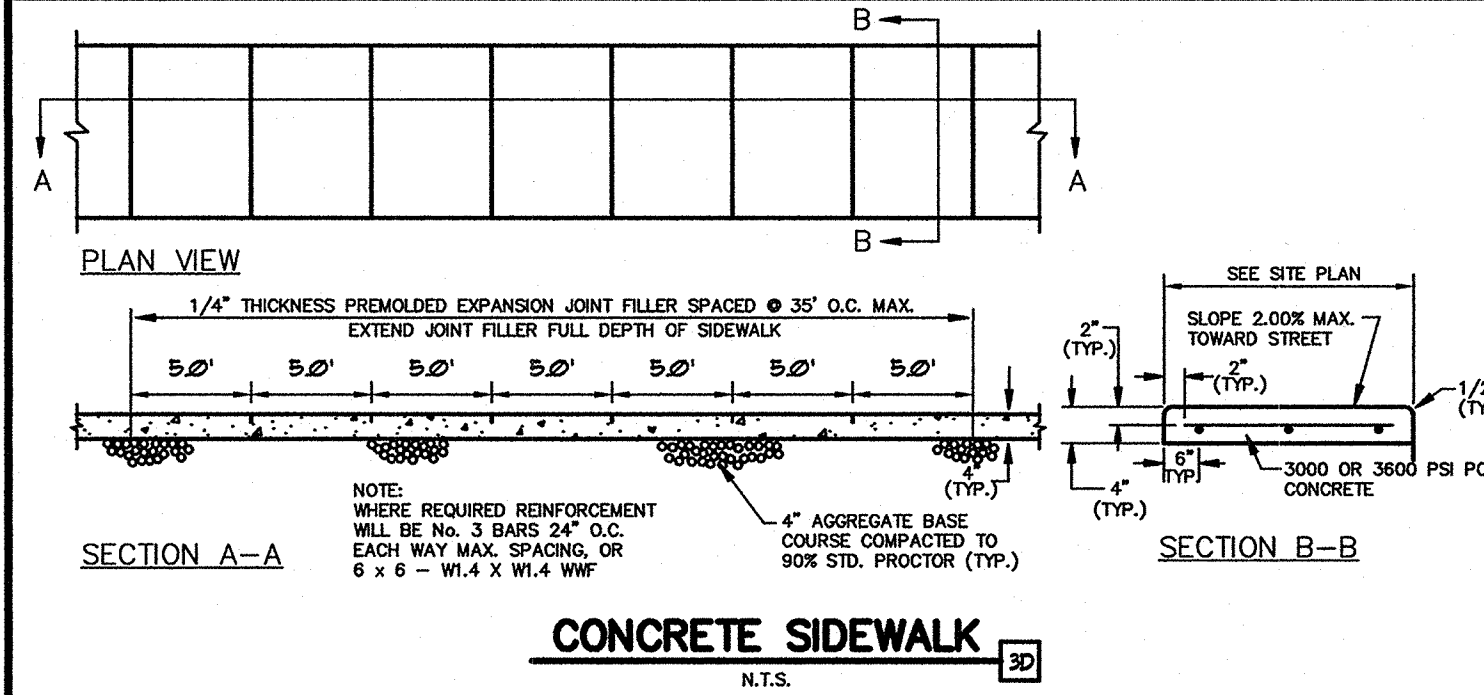


Table with columns: NO, DATE, REVISIONS. Contains revision history for the drawing.

ENGINEERING ASSOCIATES, INC. 337 SW 7th Street, Bentonville, AR 72712. Includes contact info and project details.

SONIC CORPORATION 300 JOHNNY BENCH DRIVE OKLAHOMA CITY, OK 73104. Includes company name and address.

SONIC DRIVE-IN 09 HUY 205 4 HUY 552 ROCKWALL, TEXAS. Includes company name and address.

DETAIL SHEET C-7 DWG: 24989PROJ DATE: 03/10/08. Includes drawing title and date.