


Revision	Date	Description

Ownter:
TEKMAK Development Company
 10000 N. Central Expressway, Suite 400
 Dallas, TX 75231
 Phone: (214) 890-9225

SPRINGHILL SUITES
 Marriott

~ Civil Engineer ~
F.C. CUNY CORPORATION
 #2 Horizon Court • Heath, Texas 75032 • (409) 402-7700
 Texas Registered Engineering Firm F-7449


7/5/2017

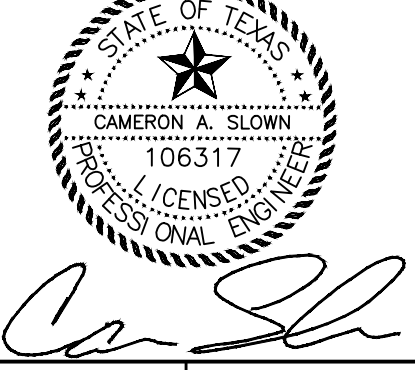




Drawn By: F.C. CUNY
 Checked By: F.C. CUNY
 Date: 05/15
 Project No.:
 Sheet Title:

Erosion Control Plan

Scale: 1"=30'
 Sheet No.: 4 of 11

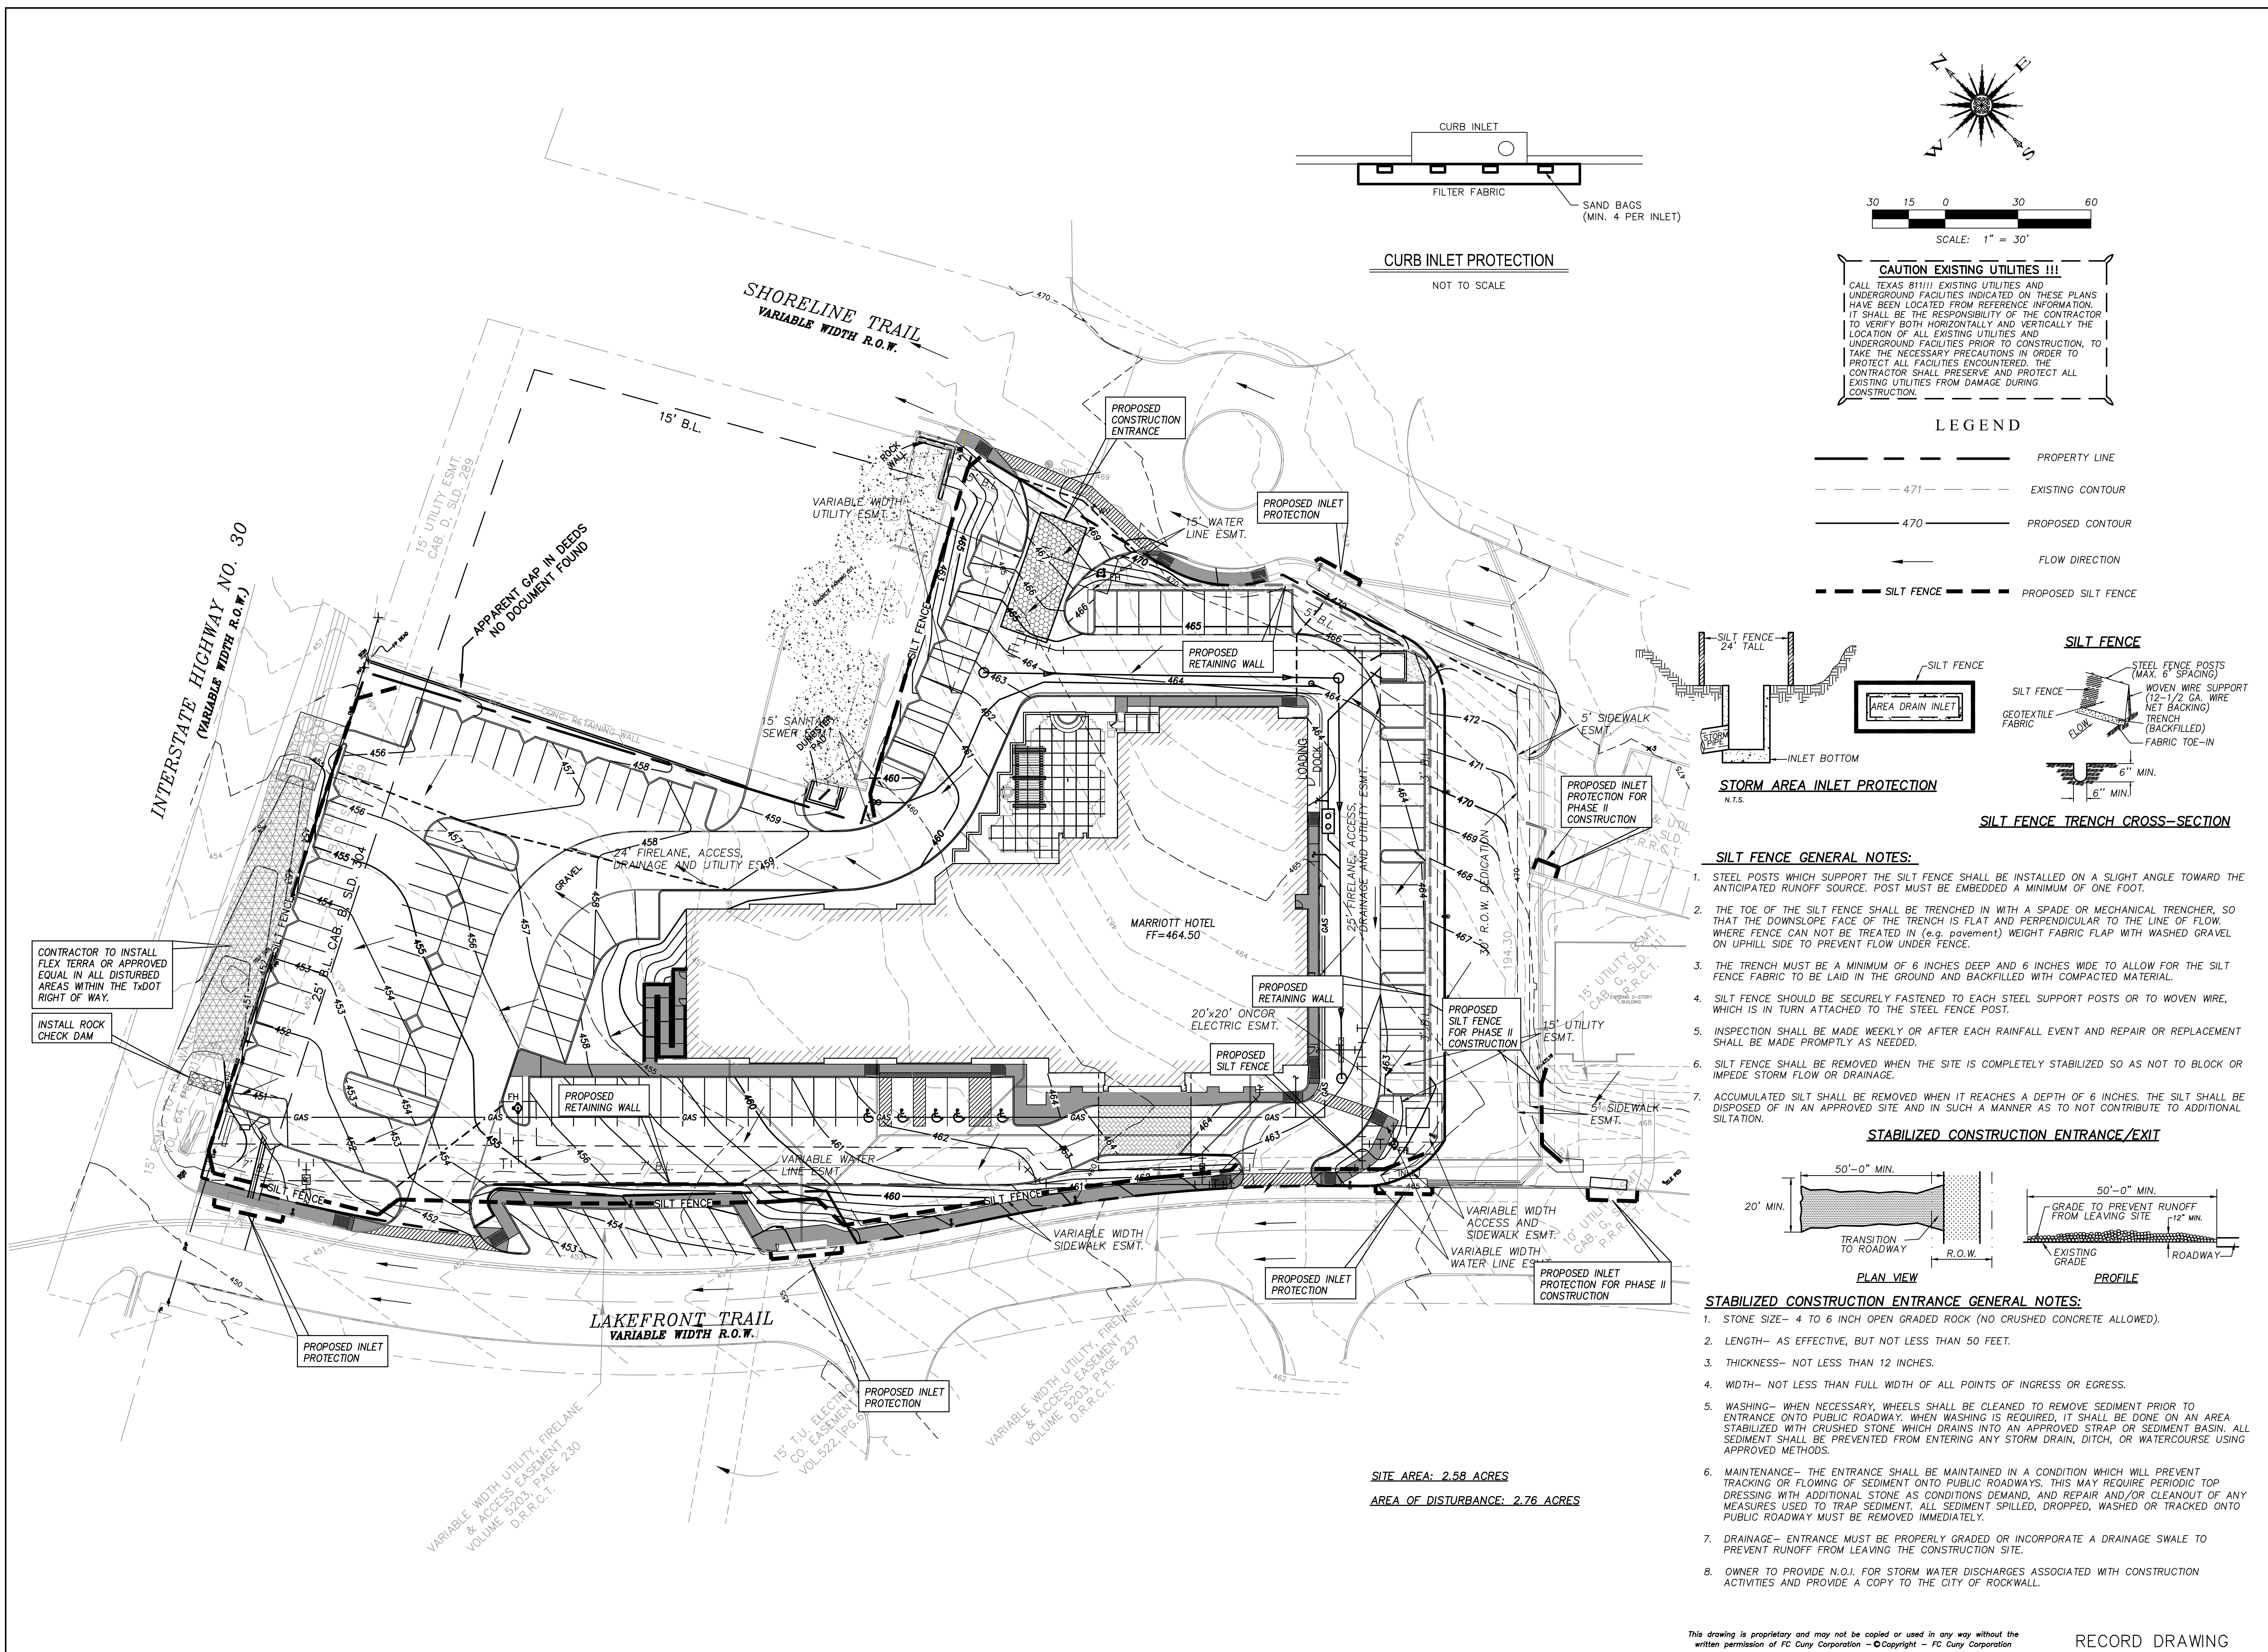

CAUTION EXISTING UTILITIES !!!
 CALL TEXAS 811!! EXISTING UTILITIES AND UNDERGROUND FACILITIES INDICATED ON THESE PLANS HAVE BEEN LOCATED FROM REFERENCE INFORMATION. IT SHALL BE THE RESPONSIBILITY OF THE CONTRACTOR TO VERIFY BOTH HORIZONTALLY AND VERTICALLY THE LOCATION OF ALL EXISTING UTILITIES AND UNDERGROUND FACILITIES PRIOR TO CONSTRUCTION, TO TAKE THE NECESSARY PRECAUTIONS IN ORDER TO PROTECT ALL FACILITIES ENCOUNTERED. THE CONTRACTOR SHALL PRESERVE AND PROTECT ALL EXISTING UTILITIES FROM DAMAGE DURING CONSTRUCTION.

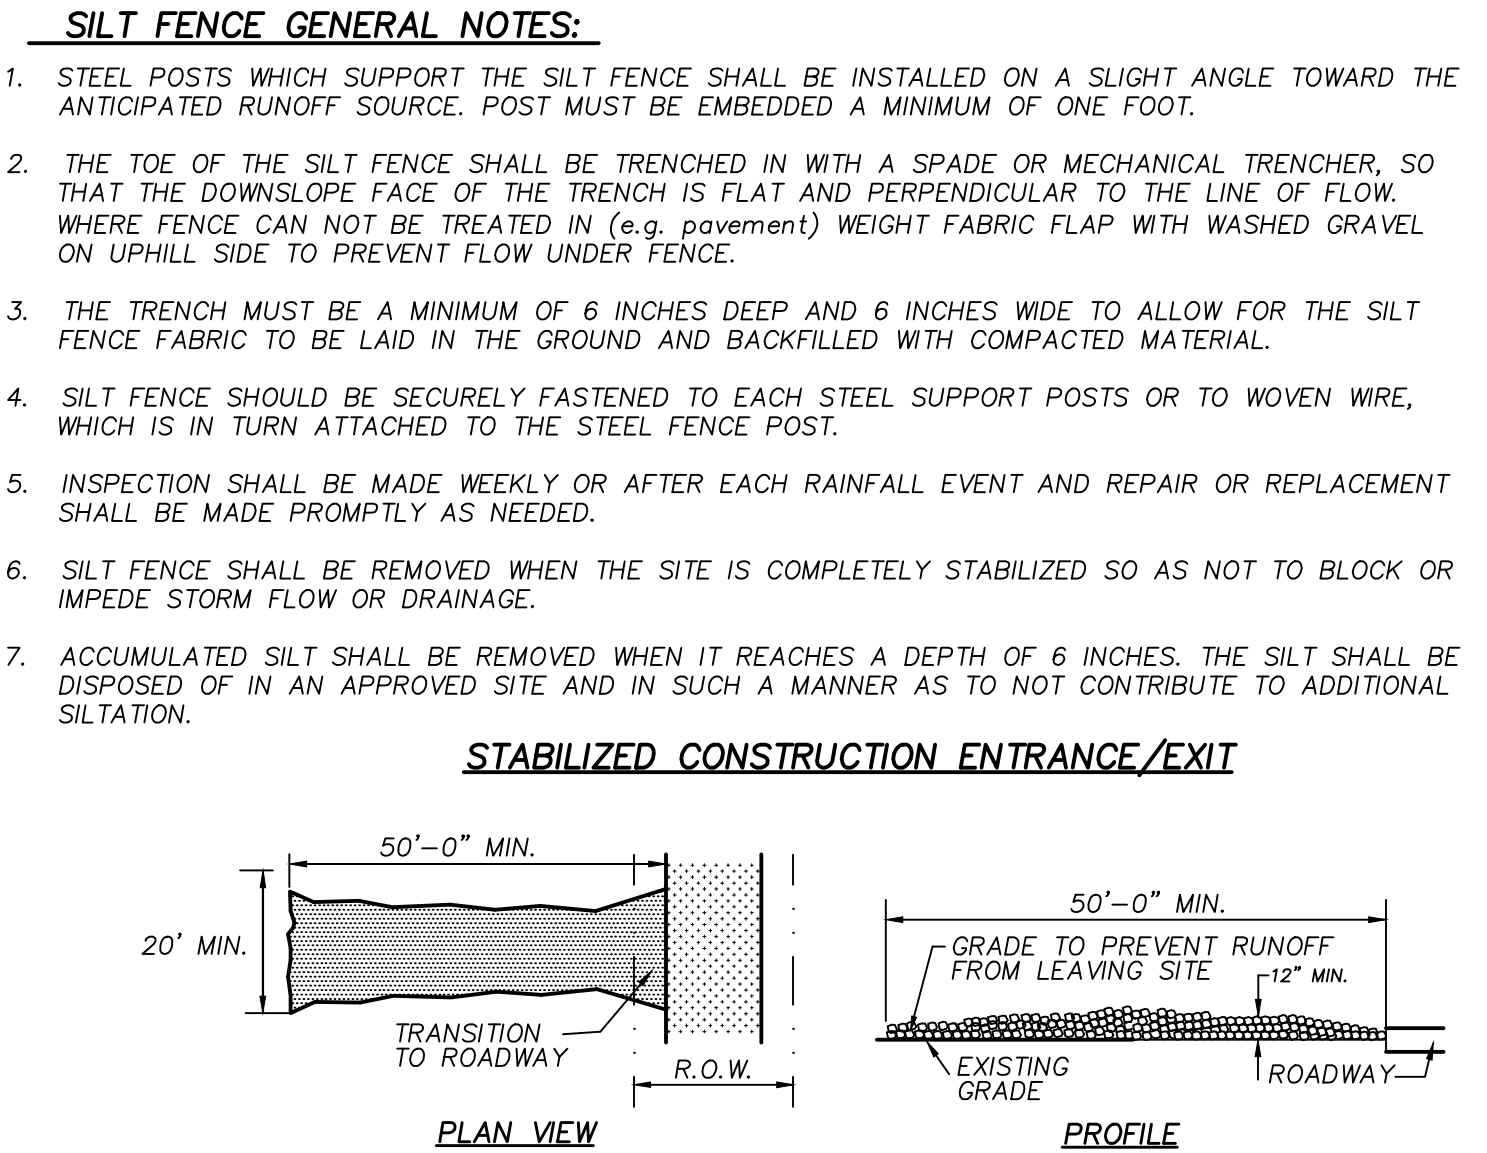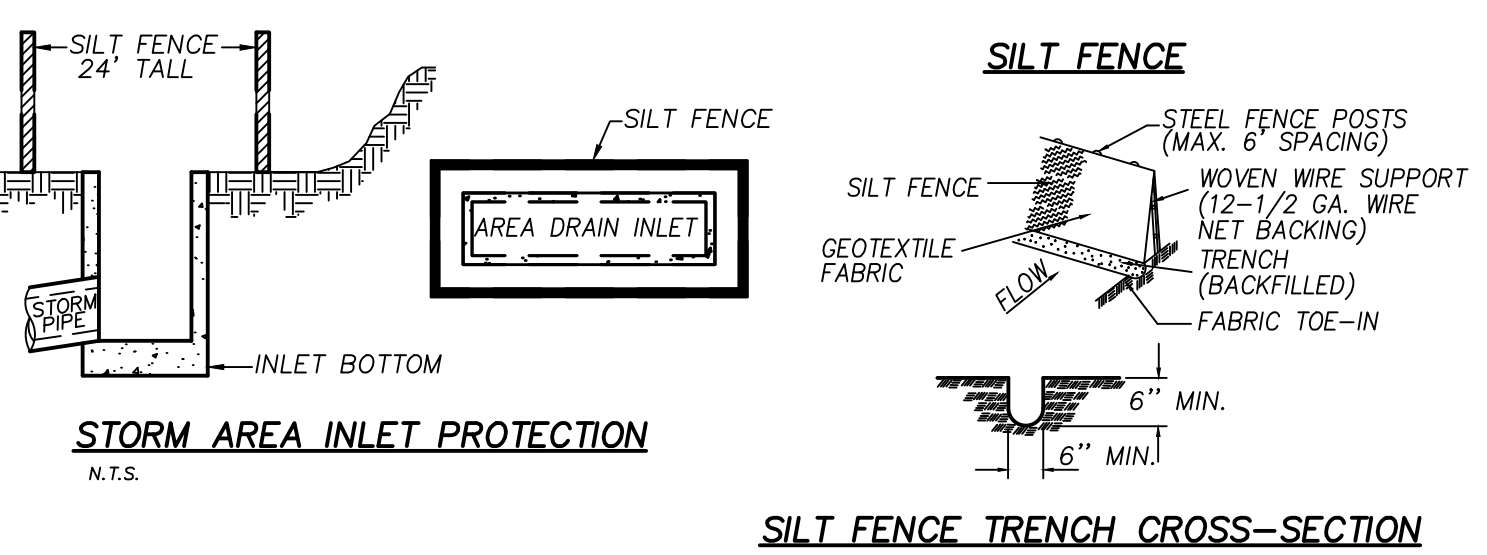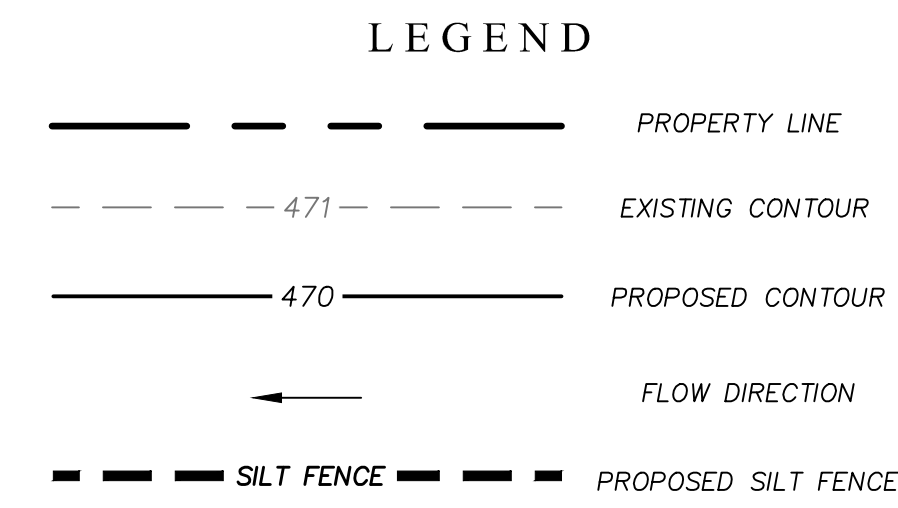

SITE AREA: 2.58 ACRES
 AREA OF DISTURBANCE: 2.76 ACRES