


BENCH MARK:
 Top rim of sanitary sewer manhole
 located at the most Southerly East
 corner of Spyglass Hill Condominiums
 Lot 4, Block "A" (Phase 4).
 Elevation 477.04

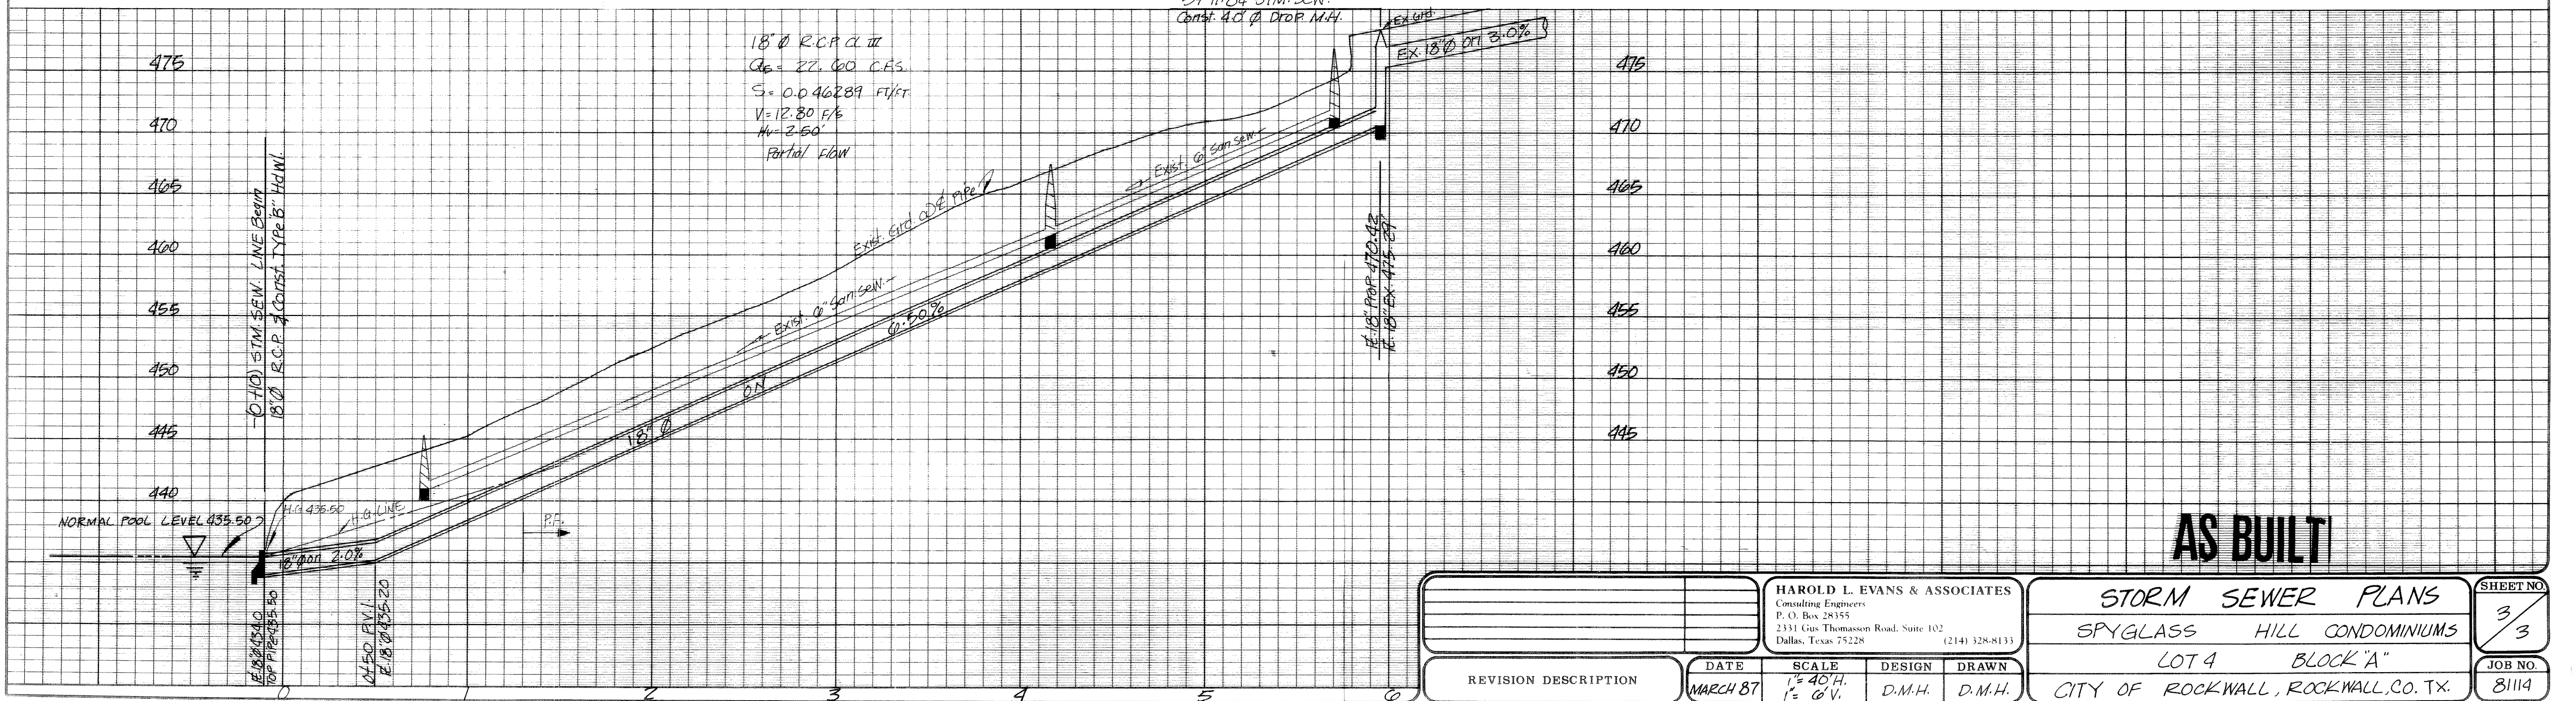

AS BUILT

REVISION DESCRIPTION		DATE	SCALE	DESIGN	DRAWN	HAROLD L. EVANS & ASSOCIATES Consulting Engineers P.O. Box 28355 2331 Gus Thomasson Road, Suite 102 Dallas, Texas 75228 (214) 328-8133	STORM SEWER PLANS SPYGLASS HILL CONDOMINIUMS LOT 4 BLOCK "A" CITY OF ROCKWALL, ROCKWALL, CO. TX.	SHEET NO. 3 3 JOB NO. 81114
		MARCH 87	1" = 40' H. 1" = 6' V.	D.M.H.	D.M.H.			