


NOTES: 1. CONTRACTOR TO COORDINATE W/ TRASH SERVICE SO AS NOT TO DISRUPT WITH TRASH PICKUP
 2. ALL REMOVAL FULL PANEL REPLACEMENT
 7" - 5" - 7" 3600 PSI (6.5 SACK/CY #3 BAR @18" OCEW PROVIDE TESTING FOR ALLEY REPLACEMENT

CURVE TABLE						
CURVE	DELTA	RADIUS	TANGENT	LENGTH	BEARING	DISTANCE
C1	58°17'13"	84.94'	47.63'	46.94'	N37°57'17"E	82.73'
C2	16°41'12"	161.16'	23.64'	46.94'	S19°58'25"W	46.77'
C3	55°34'56"	163.71'	86.28'	158.81'	S61°22'05"W	152.66'

REVISED TO CONFORM TO CONSTRUCTION RECORDS.
W. W. [Signature] DATE: 1-9-23

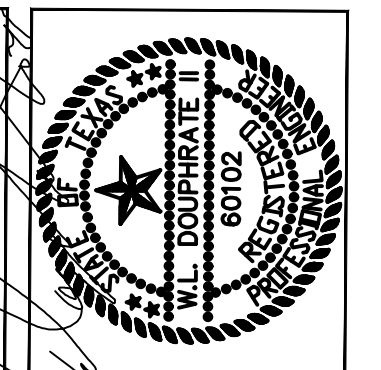

THE SEAL APPEARING ON THIS DOCUMENT IS AUTHORIZED BY THE BOARD OF ENGINEERING EXAMINERS, STATE OF TEXAS, LICENSE NO. 60102, F-666, ON DATE: DECEMBER 17, 2021.

DOUPHRATE & ASSOCIATES, INC.
 ENGINEERING PROJECT MANAGEMENT SURVEYING
 2235 RIDGE RD., # 200 ROCKWALL, TEXAS 75087
 PHONE: (972)771-9004 FAX: (972)771-9005

WATER PLAN
ST. BENEDICT'S ANGLICAN CHURCH PROPERTY
 1500 SUNSET HILL DR
 CITY OF ROCKWALL
 ROCKWALL COUNTY, TEXAS

REVISION	W.L.D.
CHECKED	G.C.W.
DRAWN	
SCALE	1"=50' H 1"=4' V
DATE	DEC 23, 2021
PROJECT	2007 WATER PL 60