


DRIVEWAY PAVING PROFILE

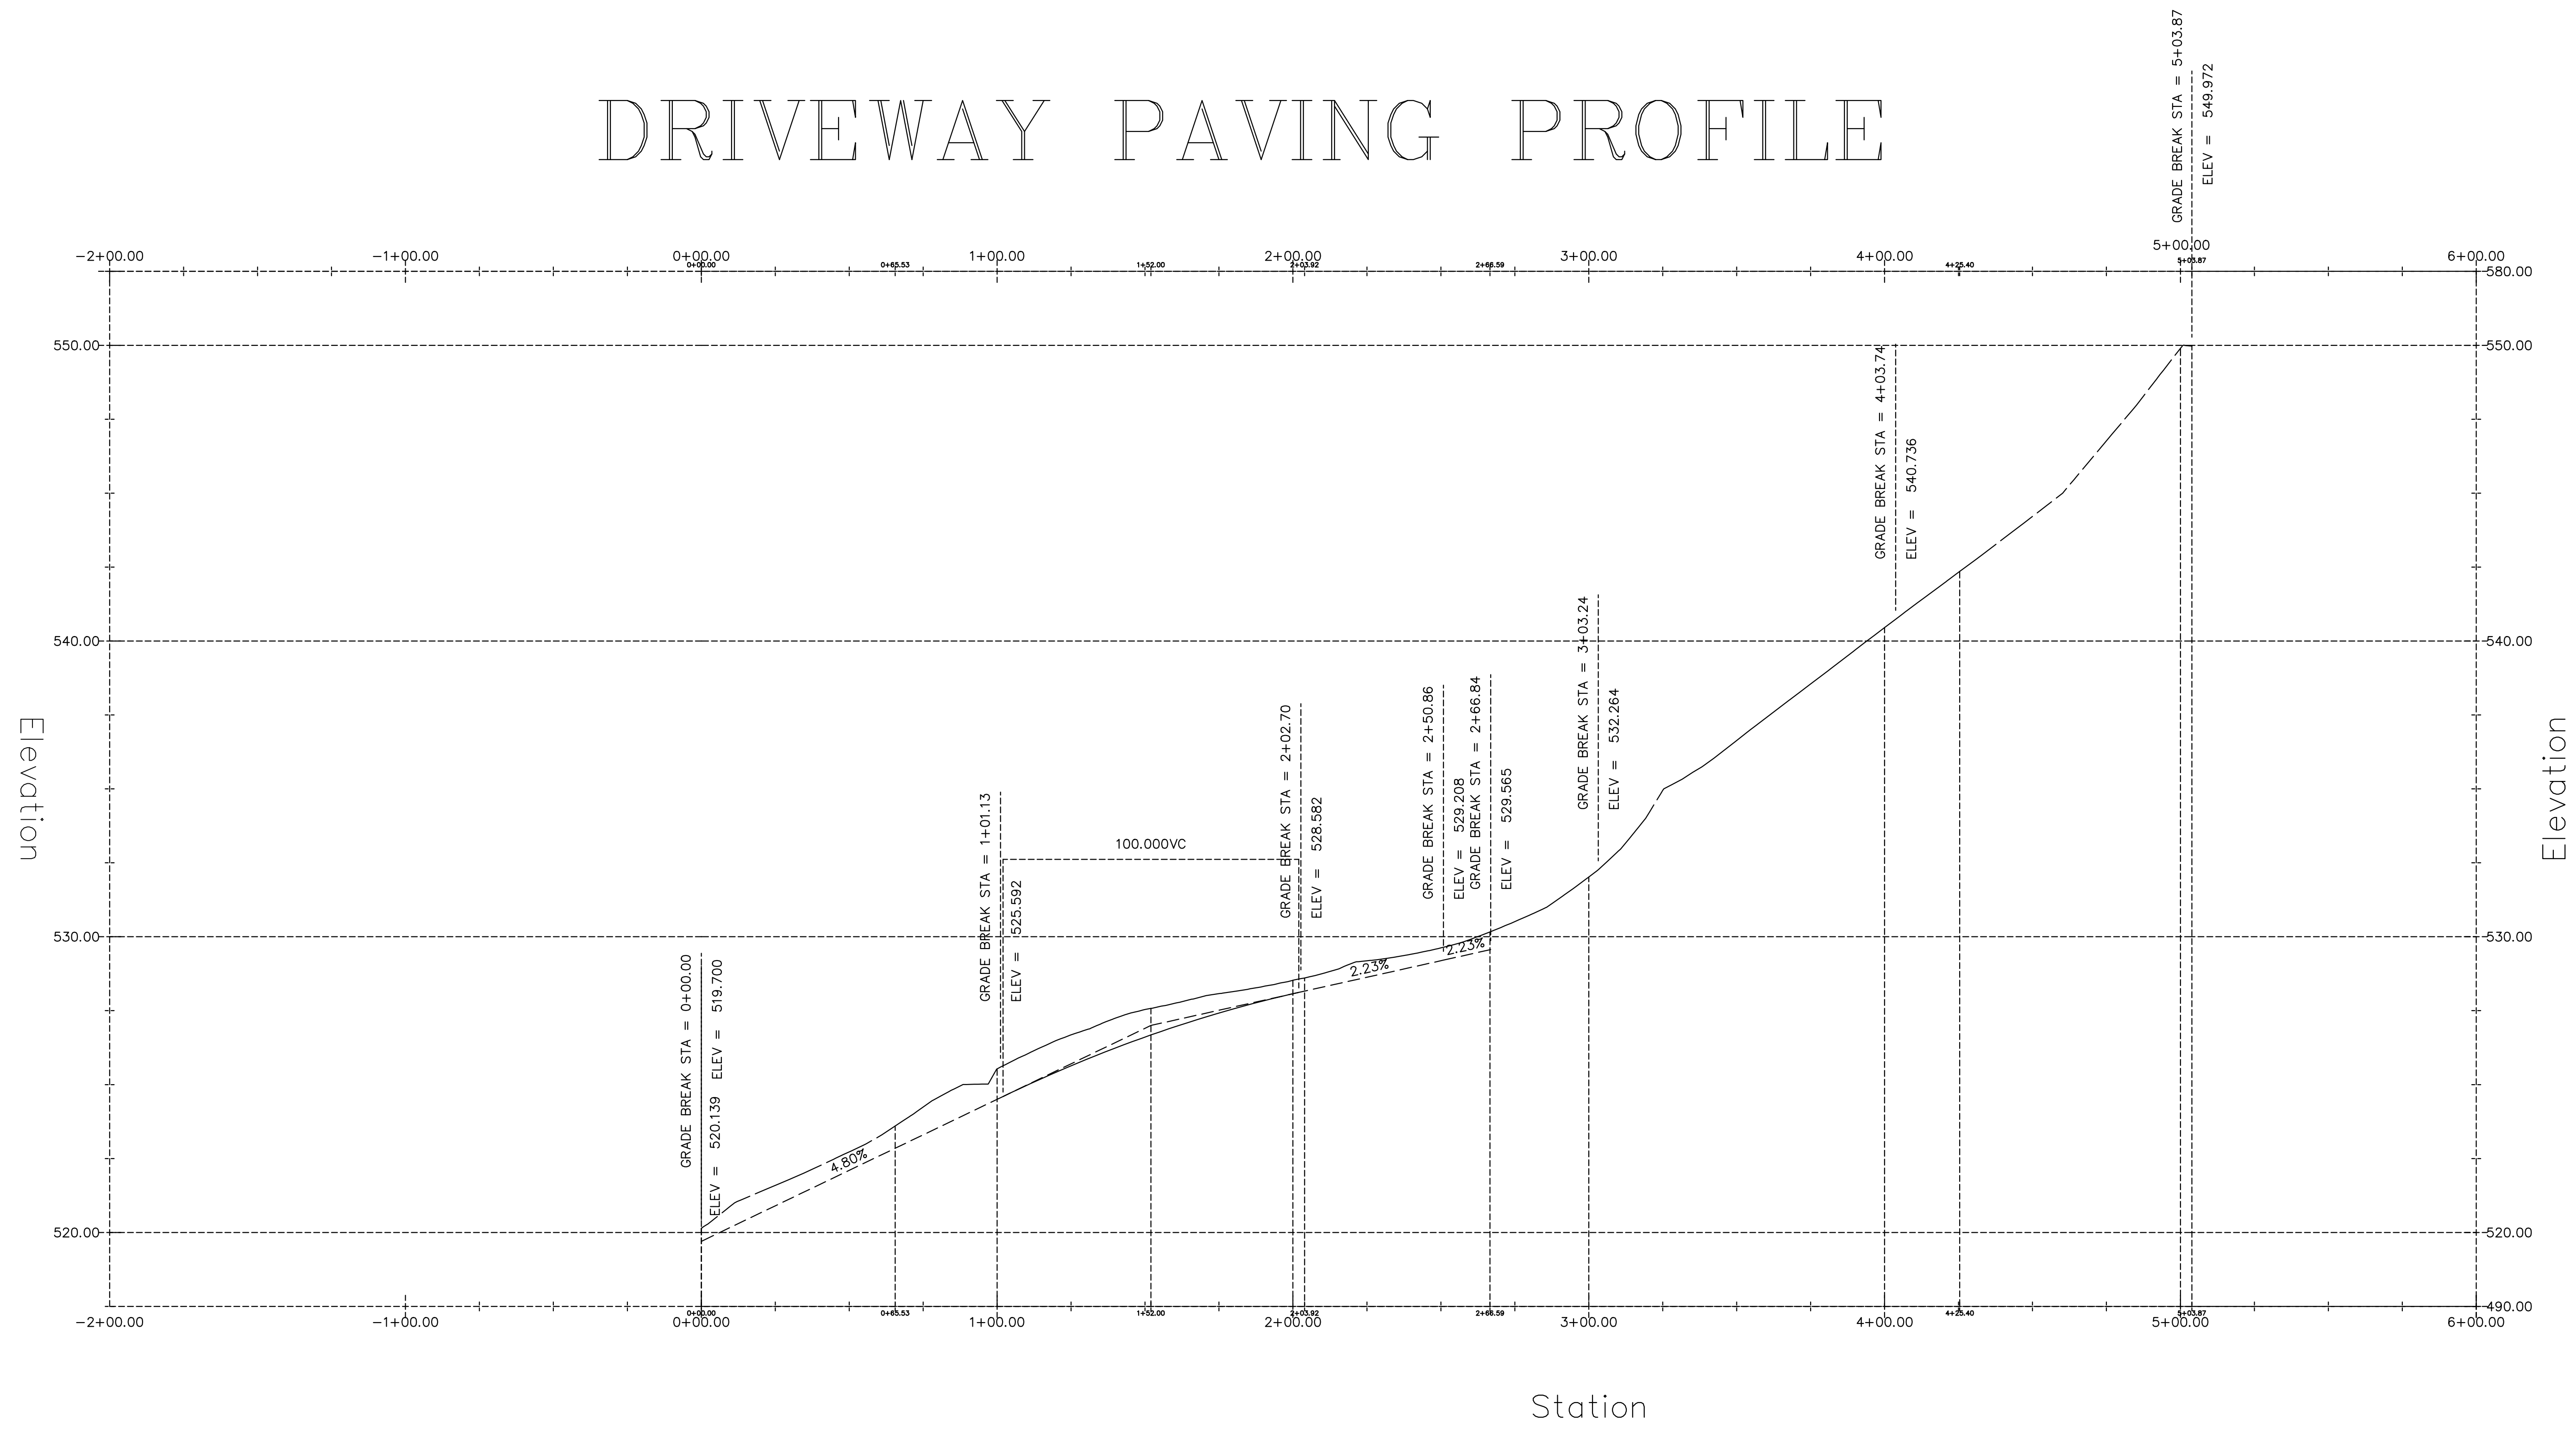

REVISED TO CONFORM TO CONSTRUCTION RECORDS.
W.L.D.
 DATE: 1-9-23



THE SEAL APPEARING ON THIS DOCUMENT WAS AUTHORIZED BY THE BOARD OF ENGINEERING EXAMINERS, STATE OF TEXAS, ON NO. 60102, F-886, ON DATE, DECEMBER 16, 2021.

DOUPHRADE & ASSOCIATES, INC.
 ENGINEERING PROJECT MANAGEMENT SURVEYING
 2235 RIDGE RD., # 200 ROCKWALL, TEXAS 75087
 PHONE: (972)771-9004 FAX: (972)771-9005

DRIVEWAY ENTRANCE PAVING PROFILE
ST. BENEDICT'S ANGLICAN CHURCH PROPERTY
 CITY OF ROCKWALL
 ROCKWALL COUNTY, TEXAS

REVISION	W.L.D.
CHECKED	GCW.
DRAWN	
SCALE	1" = 30' H 1" = 10' V
DATE	APRIL 23, 2021
PROJECT	21007 SITE PL
	71