


$\Delta=15^{\circ}21'28''$   
 $R=750.00'$   
 $A=201.03'$   
 $CB=N 10^{\circ}02'09'' W$

$\Delta=18^{\circ}13'08''$   
 $R=750.00'$   
 $A=238.48'$   
 $CB=N 26^{\circ}49'27'' W$

$\Delta=20^{\circ}54'51''$   
 $R=50.00'$   
 $A=18.25'$   
 $CB=N 78^{\circ}48'21'' W$

REVISED TO CONFORM TO CONSTRUCTION RECORDS.  
*W.D. [Signature]* DATE: 1-9-23

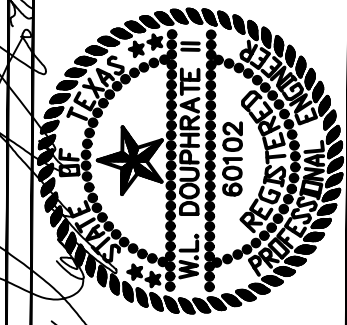

THE SEAL APPEARING ON THIS DOCUMENT WAS AUTHORIZED BY THE BOARD OF ENGINEERING EXAMINERS, STATE OF TEXAS, ON DATE: DECEMBER 17, 2021.

**DOUPHRADE & ASSOCIATES, INC.**  
 ENGINEERING PROJECT MANAGEMENT SURVEYING  
 2235 RIDGE RD., # 200 ROCKWALL, TEXAS 75087  
 PHONE: (972)771-9004 FAX: (972)771-9005

**EROSION CONTROL PLAN**  
**ST. BENEDICT'S ANGLICAN CHURCH PROPERTY**  
 1500 SUNSET HILL DR  
 CITY OF ROCKWALL  
 ROCKWALL COUNTY, TEXAS

REVISION	WLD.
CHECKED	QCW.
DRAWN	
SCALE	1"=30' H
DATE	DEC 17, 2021
PROJECT	21007 ERO FL
	80