



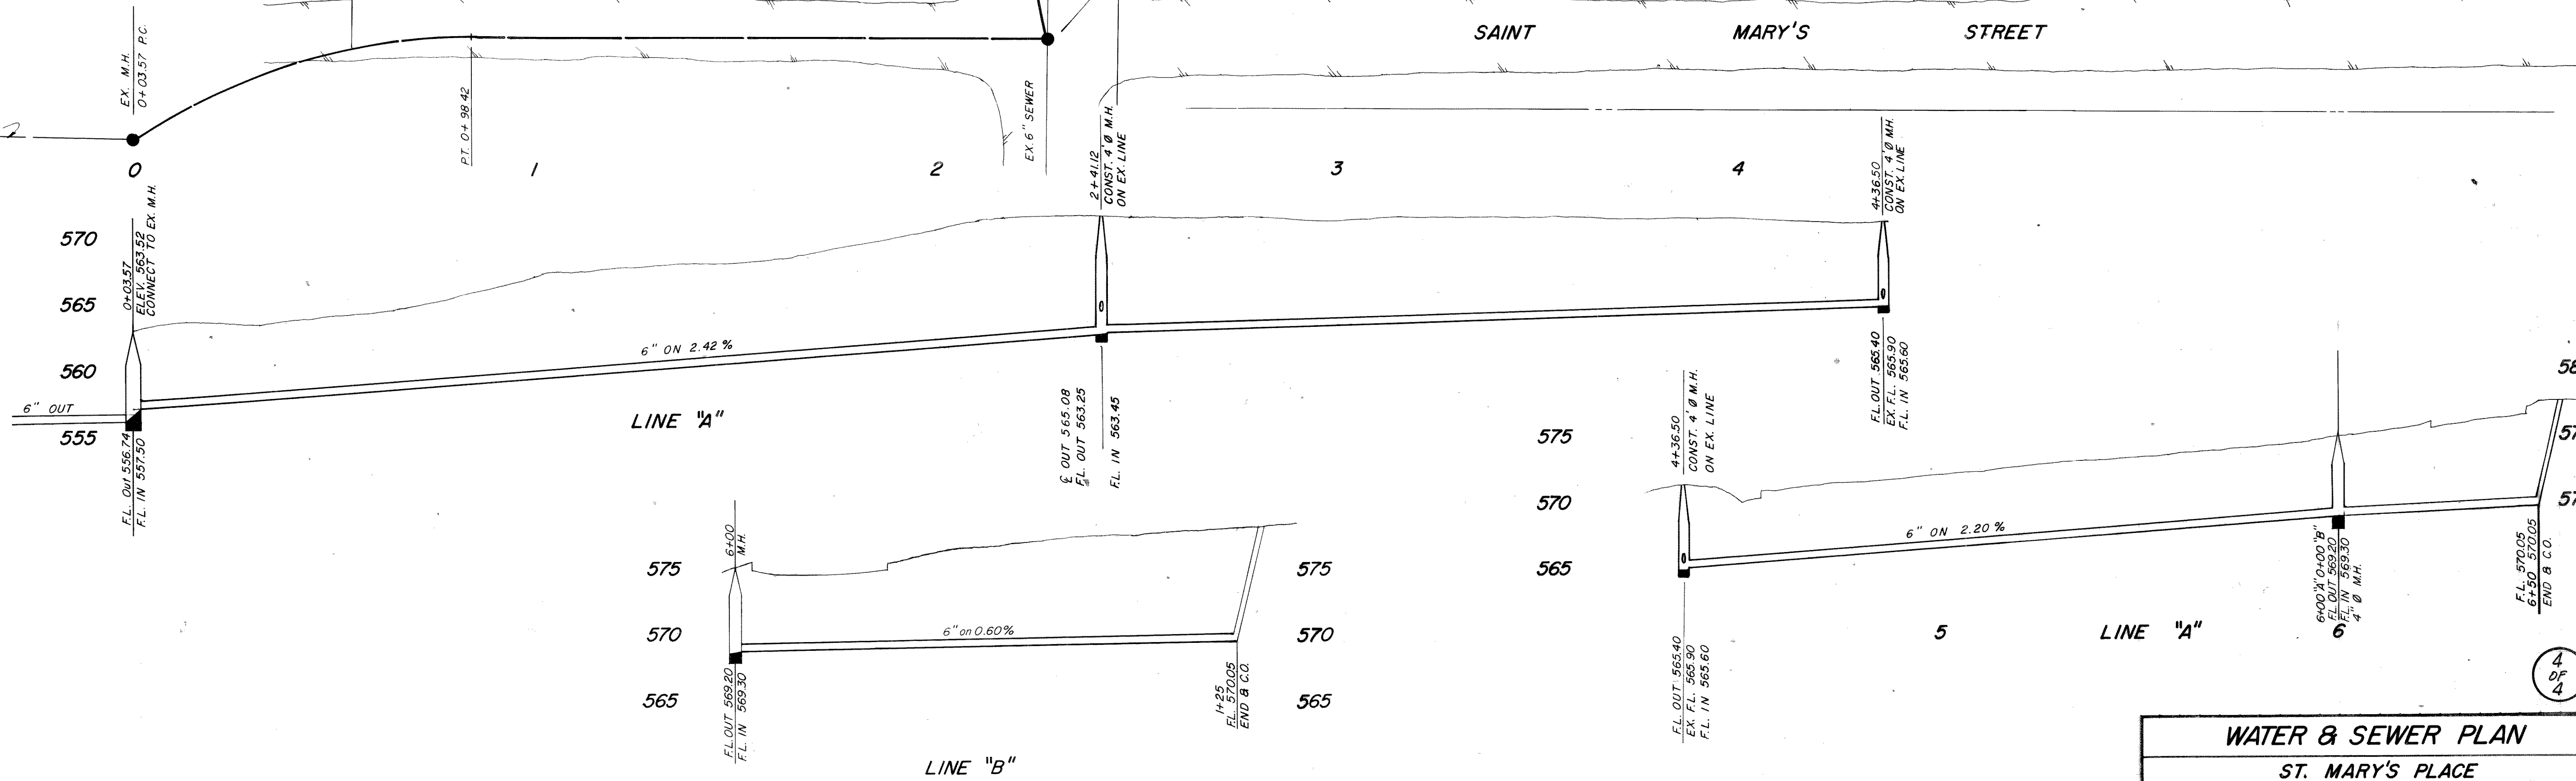

CAUTION:
Contact Lone Star
Gas Company For
Location of Gas
Lines Before
Construction

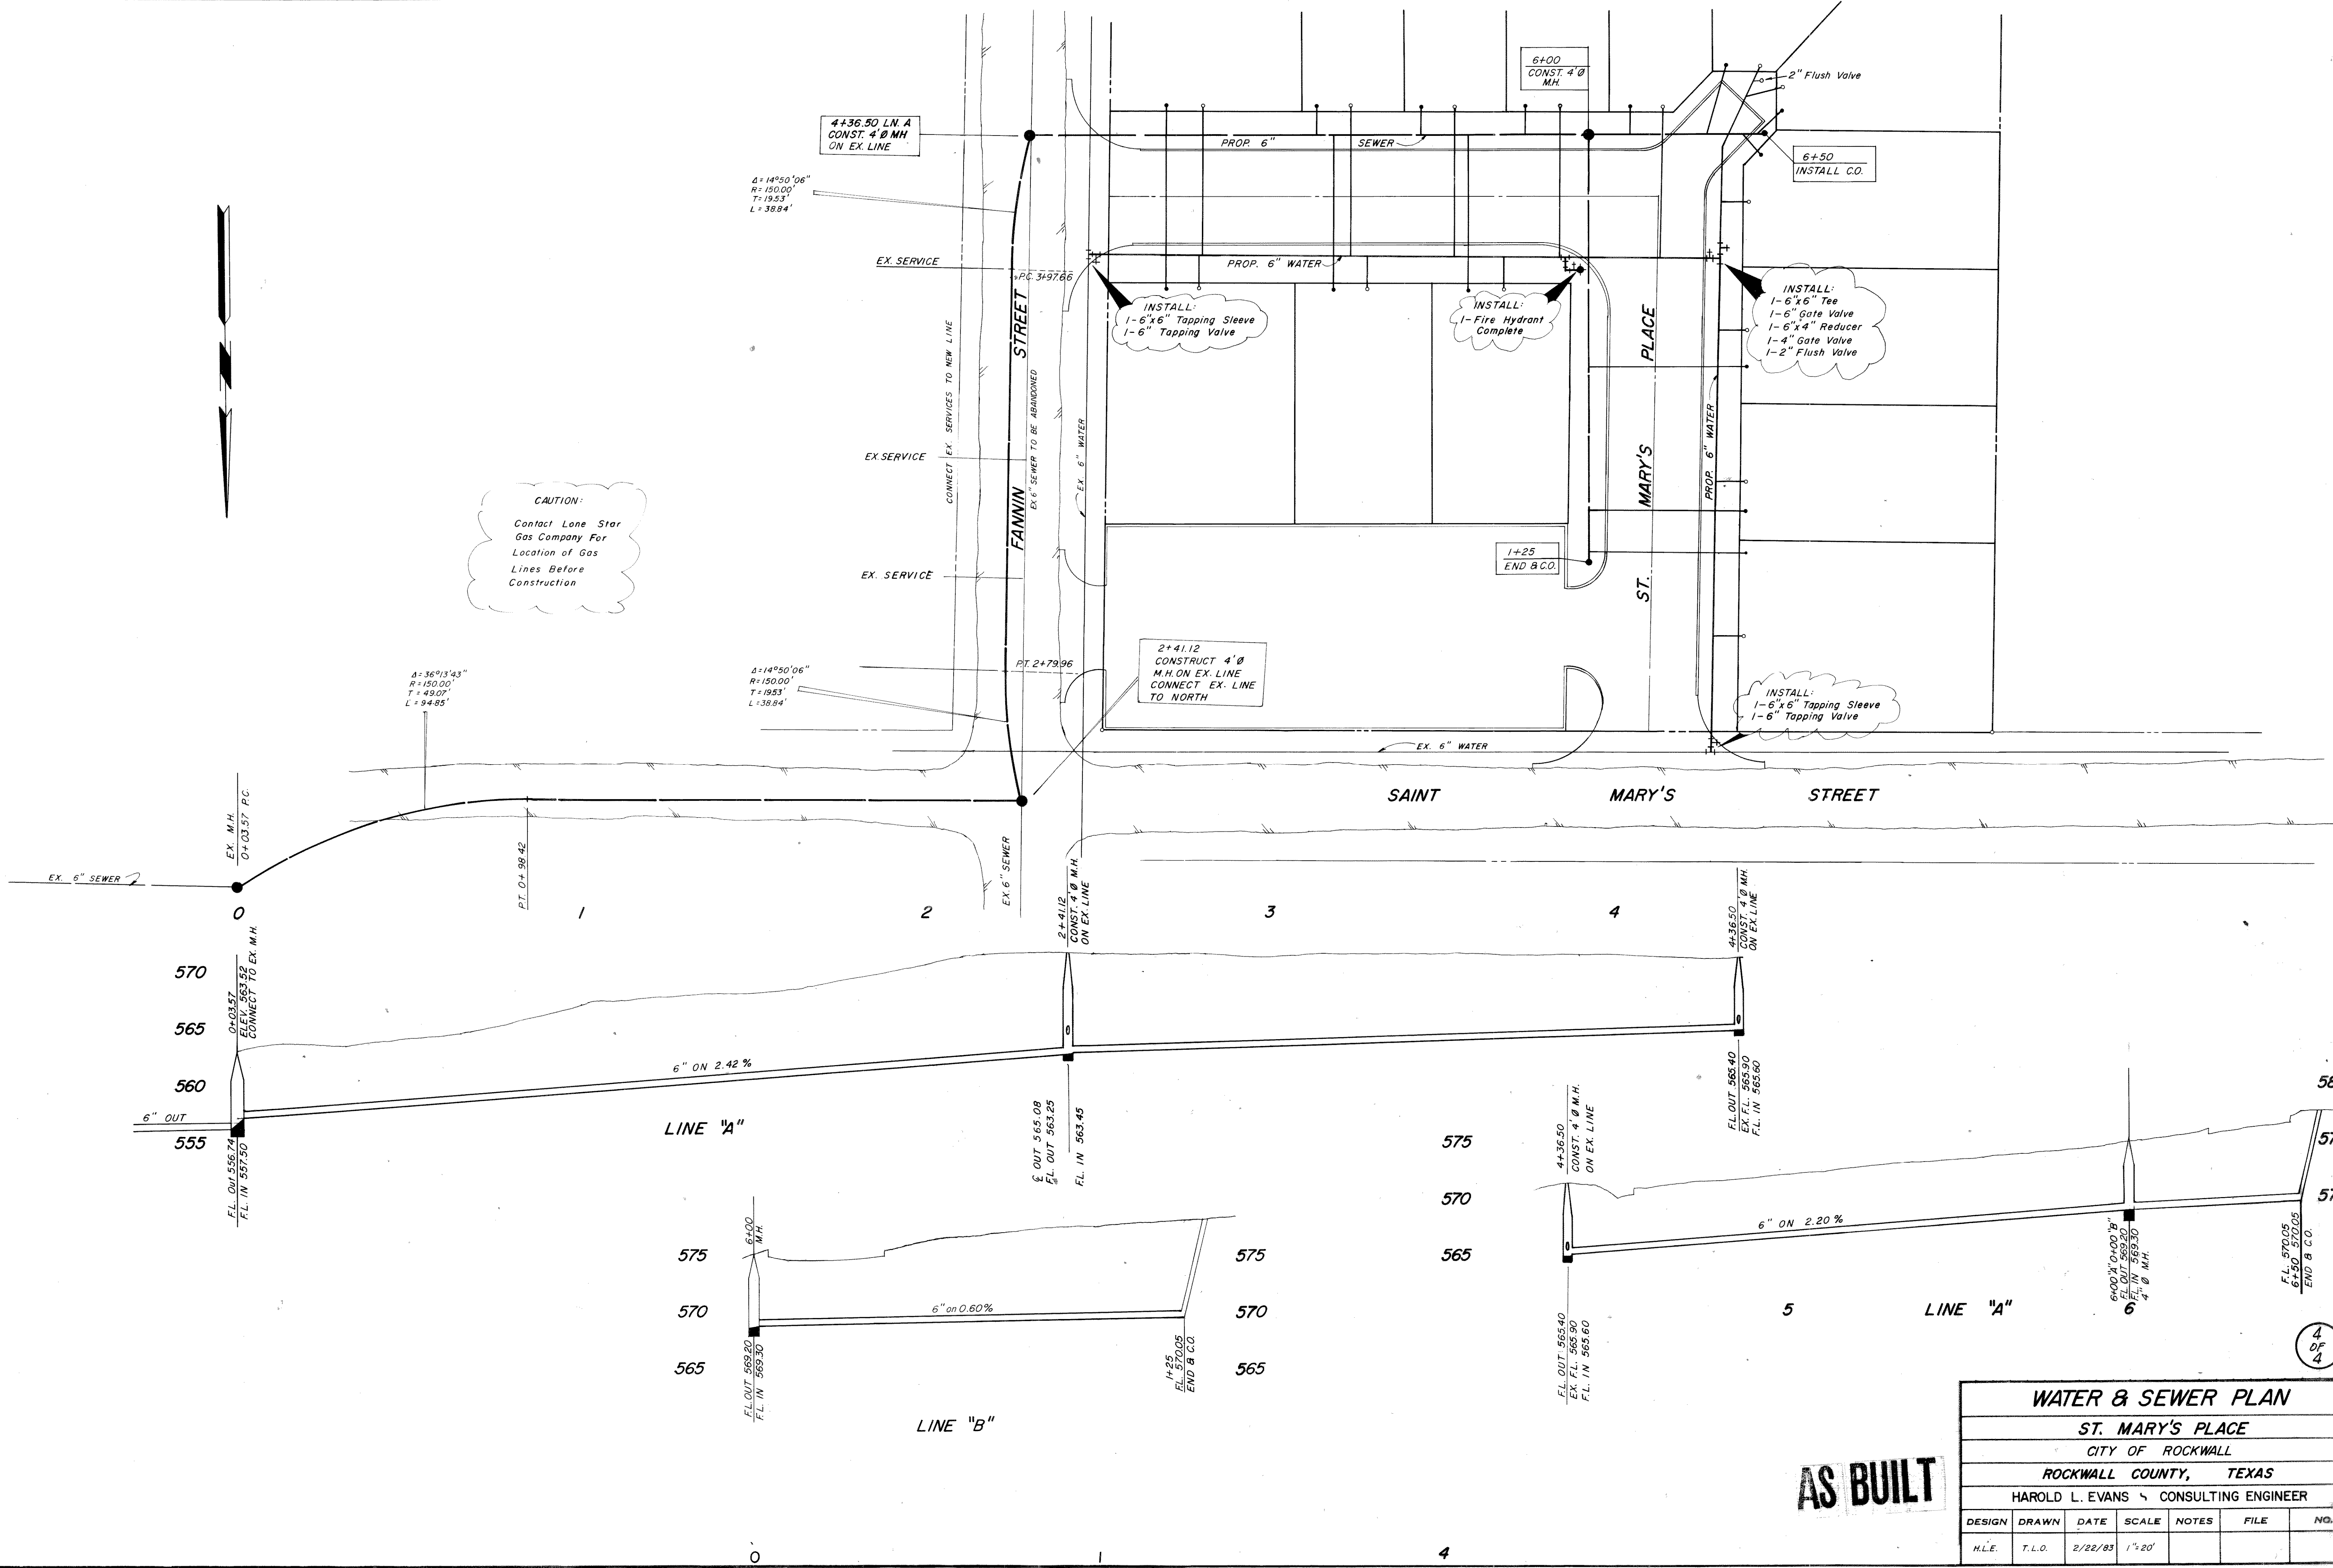

4
of
4

WATER & SEWER PLAN						
ST. MARY'S PLACE						
CITY OF ROCKWALL						
ROCKWALL COUNTY, TEXAS						
HAROLD L. EVANS & CONSULTING ENGINEER						
DESIGN	DRAWN	DATE	SCALE	NOTES	FILE	NO.
H.L.E.	T.L.O.	2/22/83	1"=20'			

AS BUILT