


B.M.  
CITY OF ROCKWALL CONTROL MONUMENT #6  
ELEVATION = 556.17

T.B.M.  
N.E. CORNER OF FOOD LION TRACT RIM OF  
S.S. MANHOLE  
ELEVATION = 571.75

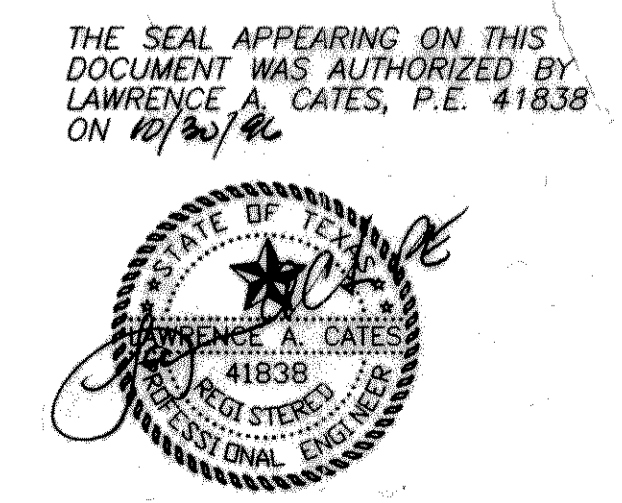

3	11/7/96	SECTION				
2	10/28/96	REV. CHANNEL SECTION				
1	6/24/96	ISSUED FOR BIDS				
REV	DATE	REVISIONS				
<b>DRAINAGE PLAN</b>						
STEGER TOWNE CROSSING						
F.M. 740 (RIDGE ROAD) AND I.H. 30						
CITY OF ROCKWALL, TEXAS						
LAWRENCE A. CATES & ASSOC., INC. CONSULTING ENGINEERS (214) 385-2272 DALLAS, TEXAS						
DESIGN	DRAWN	DATE	SCALE	NOTES	FILE	NO.
LAC	LAC	1/96	1"=50'	D.P.	95057 DRAIN	C-12

R:\DMG5195057\DRAIN TNU Oct. 31 10:26:24 1996