


GENERAL NOTES:

- 1) ALL STORM SEWER PIPES TO BE CLASS III RCP UNLESS NOTED OTHERWISE.
- 2) ALL INLET CONSTRUCTION AND STORM SEWER INSTALLATION TO BE IN ACCORDANCE WITH CITY OF ROCKWALL STANDARDS.
- 3) PRIOR TO CONSTRUCTION CONTRACTOR WILL CONTACT ALL PRIVATE UTILITY COMPANIES TO LOCATE THEIR RESPECTIVE SYSTEMS.
- 4) ALL MATERIALS AND WORKMANSHIP SHALL CONFORM TO THE STANDARD SPECIFICATIONS FOR THE PUBLIC WORKS CONSTRUCTION PER THE NORTH CENTRAL TEXAS COUNCIL OF GOVERNMENTS LATEST EDITION, AND ANY SPECIAL PROVISION AS APPROVED BY THE DIRECTOR OF PUBLIC WORKS.
- 5) DURING THE CONSTRUCTION OF THESE IMPROVEMENTS, ANY INTERPRETATION OF THE STANDARD SPECIFICATIONS FOR PUBLIC WORKS CONSTRUCTION AND ANY MATTER WHICH REQUIRES THE APPROVAL OF THE OWNER MUST BE APPROVED BY THE DIRECTOR OF PUBLIC WORKS OR HIS DESIGNEE BEFORE ANY CONSTRUCTION INVOLVING THAT DECISION COMMENCES.

ASSUMPTIONS ABOUT WHAT THESE DECISIONS MIGHT BE WHICH ARE MADE DURING THE BIDDING PHASE WILL HAVE NO BEARING ON THE DECISION.

- 6) FOR ADJUSTMENT OF ROCKWALL WATER UTILITIES APPURTENANCES OR TO VERIFY LOCATIONS OF EXISTING WATER AND WASTEWATER MAINS IN AREA, CONTACT HENRY GOODNIGHT AT THE CITY OF DALLAS WATER DISTRIBUTION DIVISION AT (214) 670-7851 AND SANDY STANLINDER, IN WASTEWATER COLLECTION DIVISION (214) 670-7440 AT LEAST (3) THREE WORKING DAYS PRIOR TO COMMENCEMENT OF CONSTRUCTION.

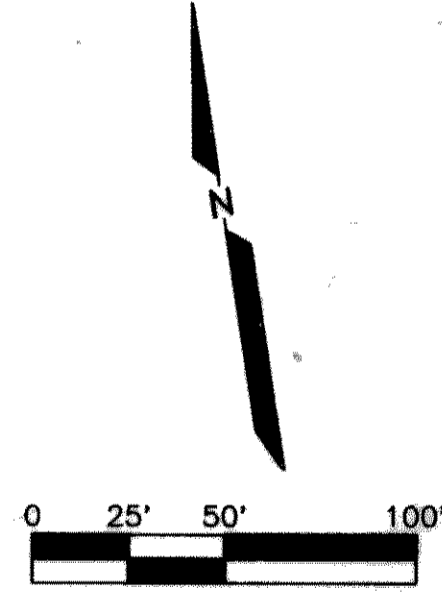

MATCH LINE (SEE SHIT. C-12)


AS BUILT
DATE 4-30-97

PHASE ONE

2	10/28/98	ADD 3'x3' D.I.				
REV	10/27/98	REMOVE 4'x4' D.I.	REMOVE 4'x4' D.I.	VOID		
DRAINAGE PLAN						
STEGER TOWNE CROSSING						
F.M. 740 (RIDGE ROAD) AND I.H. 30						
CITY OF ROCKWALL, TEXAS						
LAWRENCE A. CATES & ASSOC., INC.						
(214) 385-2272 CONSULTING ENGINEERS DALLAS, TEXAS						
DESIGN	DRAWN	DATE	SCALE	NOTES	FILE	NO.
LAC	LAC	1/96	1"=50'	D.P.	95057 DRAIN	C-13

B.M.
CITY OF ROCKWALL CONTROL MONUMENT #6
ELEVATION = 556.17

T.B.M.
N.E. CORNER OF FOOD LION TRACT RIM OF
S.S. MANHOLE
ELEVATION = 571.75

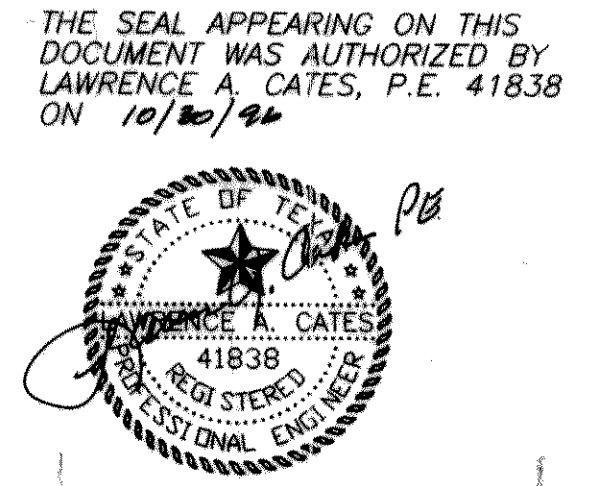

R:\UNISS\56067\DRAWING Thu Oct 31 09:37:43 1996