


MATCH LINE (SEE SHT. C-13)




AS BUILT
DATE 4-30-97

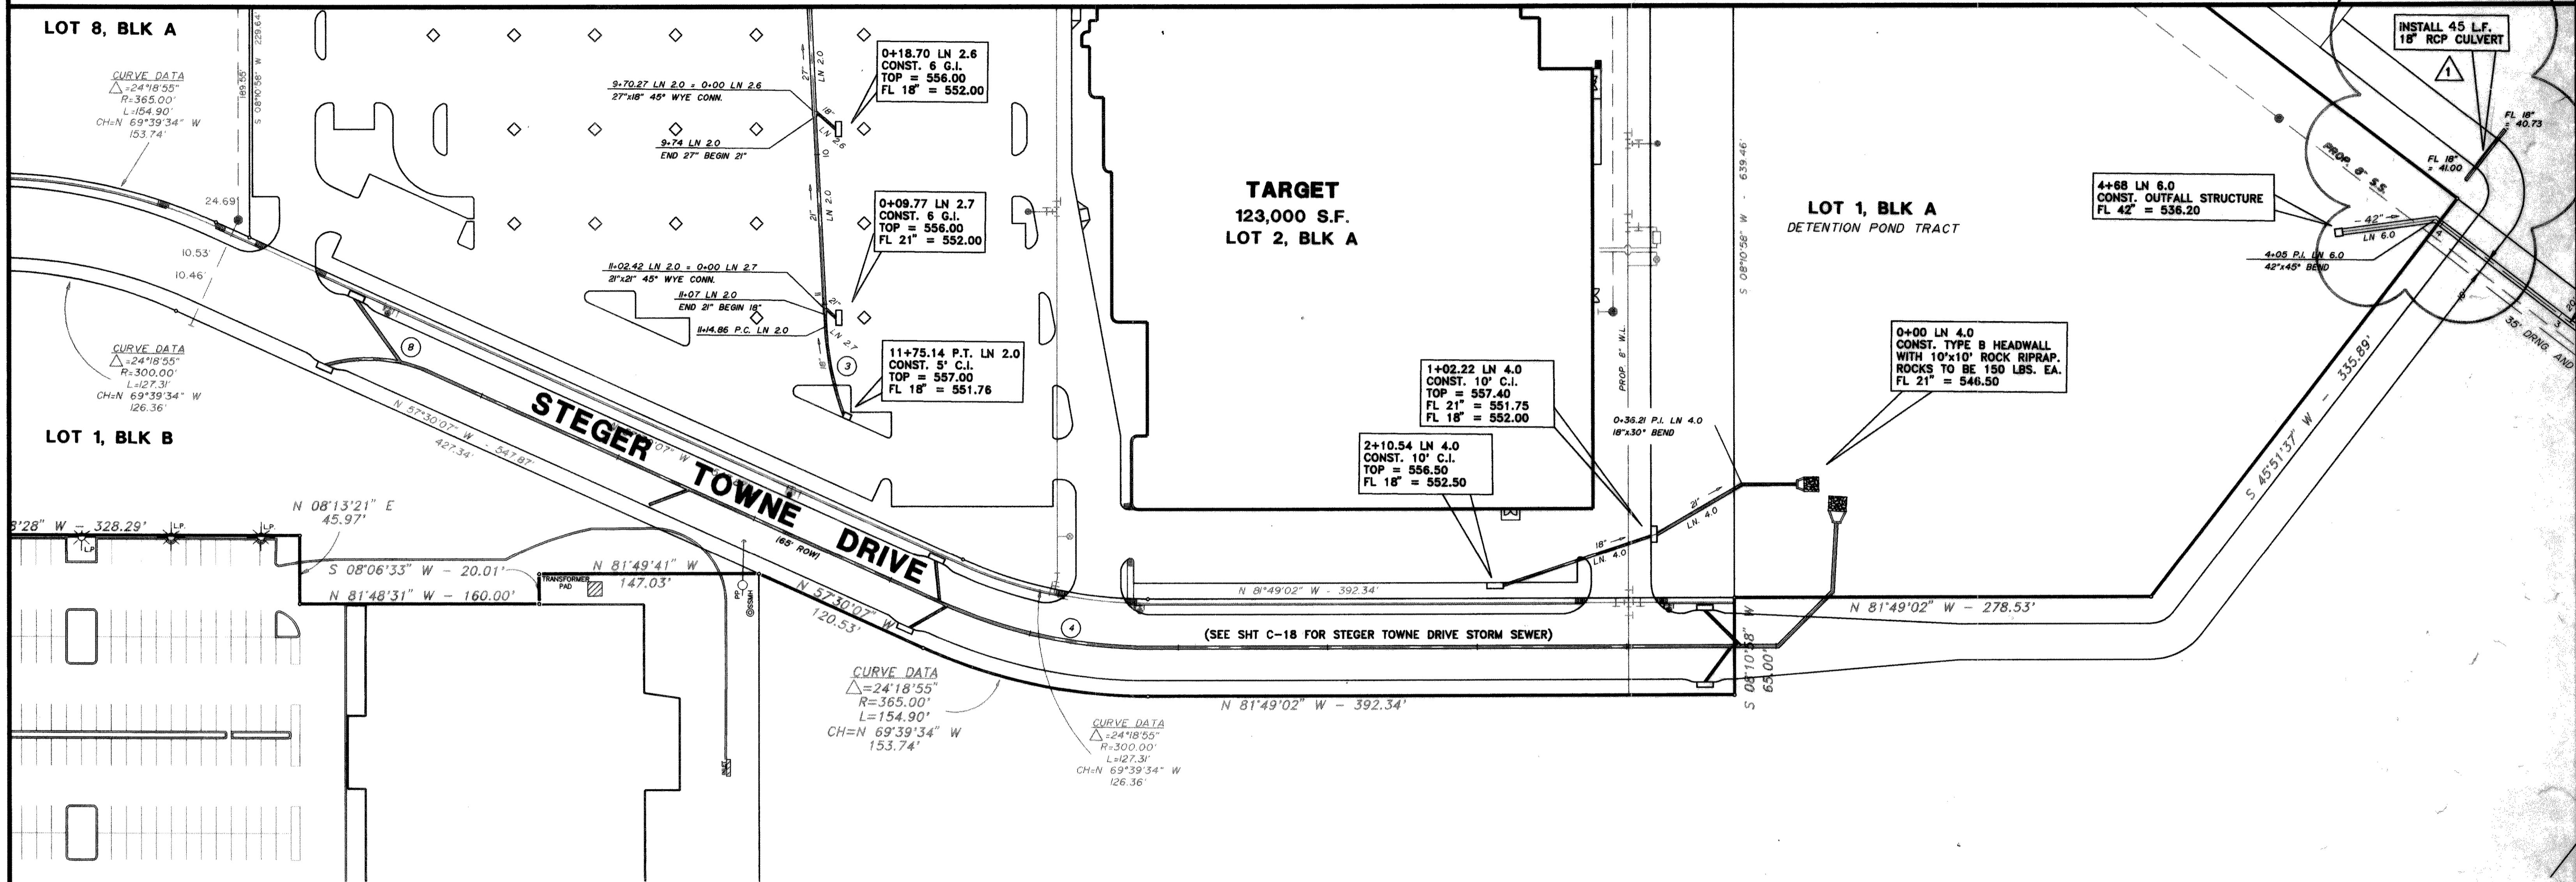

PHASE ONE

THE SEAL APPEARING ON THIS DOCUMENT WAS AUTHORIZED BY LAWRENCE A. CATES, P.E. 41838 ON 10-03-90

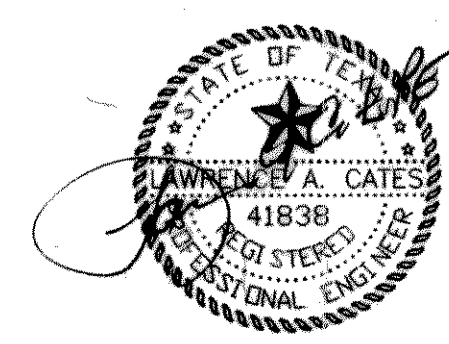

B.M.
CITY OF ROCKWALL CONTROL MONUMENT #6
ELEVATION = 556.17

T.B.M.
N.E. CORNER OF FOOD LION TRACT RIM OF S.S. MANHOLE
ELEVATION = 571.75

1		10/03/96	ADD 45 L.F. 18\"/>
REV.		DATE	REMARKS
DRAINAGE PLAN			
STEGER TOWNE CROSSING			
F.M. 740 (RIDGE ROAD) AND I.H. 30			
CITY OF ROCKWALL, TEXAS			
LAWRENCE A. CATES & ASSOC., INC.		CONSULTING ENGINEERS	
(214) 388-2272		DALLAS, TEXAS	
DESIGN	DRAWN	DATE	SCALE
LAC	LAC	1/96	1\"/>
FILE	NO.		
95057 DRAIN	C-14		

P. LONGSIGHT/DALIN REV. Oct. 2 12:04:42 1996