

MATCH LINE STA. 20+00 (SEE SHEET C-25)

MATCH LINE STA. 10+00 (THIS SHEET)

MATCH LINE STA. 10+00 (THIS SHEET)

FL 8" 546.27
FL 8" 546.21

FL 8" 545.66
FL 6" 545.83

FL 8" 544.69
FL 21" 547.72

FL 8" 544.37
FL 6" 544.53

FL 8" 543.70
FL 6" 543.93

FL 8" 543.10
FL 21" 546.95

FL 8" 540.95

FL 8" 539.19

FL 8" 539.19

FL 8" 535.00

FL 8" 34.26
FL 42" 36.00

FL 8" 531.30


FL 8" 531.19
FL 42" 534.46

FL 8" 530.49
FL EX M.H. 530.31*
(VERIFY)

AS BUILT
DATE 4/30/97

9/9/96 - ADD 4" DIA. MH STA. 17+12

B.M.
CITY OF ROCKWALL CONTROL MONUMENT #6
ELEVATION = 556.17
T.B.M.
N.E. CORNER OF FOOD LION TRACT RIM OF
S.S. MANHOLE
ELEVATION = 571.75

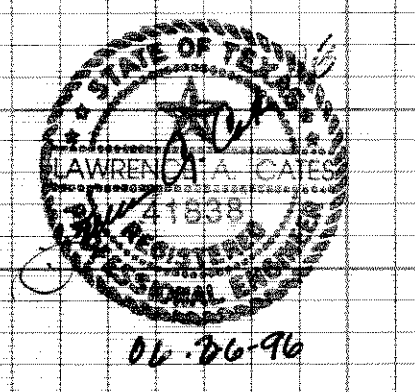

SANITARY SEWER PROFILES							
STEGER TOWNE CROSSING							
F.M. 740 (RIDGE ROAD) AND I.H. 30							
CITY OF ROCKWALL, TEXAS							
LAWRENCE A. CATES & ASSOC., INC.				CONSULTING ENGINEERS			
(214) 385-2272				DALLAS, TEXAS			
DESIGN	DRAWN	DATE	SCALE	CHECKED	FILE	NO.	
LAC	LAC	5/10/96	H:1"=40' V:1"=6'	D.P.	95057	C-24	