


B.M.
CITY OF ROCKWALL CONTROL MONUMENT #6
ELEVATION = 556.17

T.B.M.
N.E. CORNER OF FOOD LION TRACT RM OF
S.S. MANHOLE
ELEVATION = 571.75

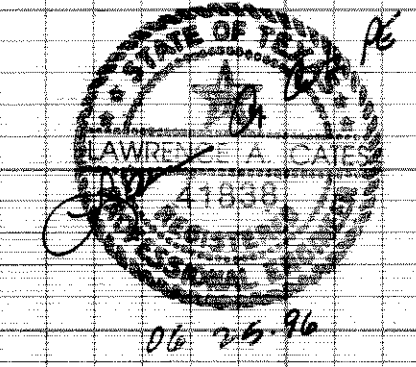

AS BUILT
DATE 4.30.97

SANITARY SEWER PROFILES						
STEGER TOWNE CROSSING						
F.M. 740 (RIDGE ROAD) AND I.H. 30						
CITY OF ROCKWALL, TEXAS						
LAWRENCE A. CATES & ASSOC., INC.				CONSULTING ENGINEERS		
(214) 385-2272				DALLAS, TEXAS		
DESIGN	DRAWN	DATE	SCALE	CHECKED	FILE	NO.
LAC	LAC	5/10/96	H:1"=40' V:1"=6'	D.P.	95057	C-25

MATCH LINE STA 20+00
(SEE SHT. C-24)

7/12/96 REV. S.S. LOCATION