

F.M. 740 - RIDGE ROAD

F.M. 3097 - HORIZON ROAD

STEGER TOWNE DR. (65' RIGHT-OF-WAY)

FUTURE RALPH HALL PKWY. (UNIMPROVED)

WESTWOOD DRIVE


WINTER PARK

LOT 2 BLK C NOT THIS CONTRACT F.F. = 671.25


LOT 1, BLK. C LOWE'S F.F. = 559.00

DETECTION POND

DETECTION POND

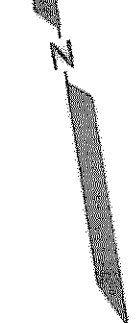

THE SEAL APPEARING ON THIS DOCUMENT WAS AUTHORIZED BY LAWRENCE A. CATES, P.E. 41838 ON 11/04/97

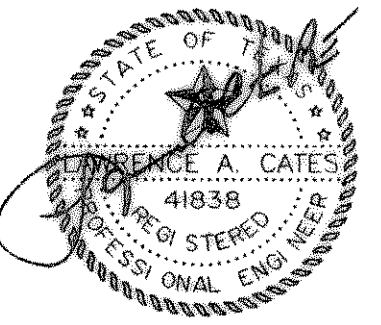

B.M. CITY OF ROCKWALL CONTROL MONUMENT #6 ELEVATION = 556.17
T.B.M. N.E. CORNER OF STEIN MART TRACT RIM OF S.S. MANHOLE ELEVATION = 571.75

1	10/03/97	REV. OF S.S. LAY. @ REAR
2	8/28/97	REVISED PER ADD. NO. 1 - CHANGED S.S. LAY SIZE, ADDED 9"x6" VAULT
3	8/22/97	RELOCATED PORTION OF SANIT. SEWER - LINE A
REV	DATE	REMARKS
WATER AND SANITARY SEWER PLAN		
LOT 1, BLK. C, STEGER TOWNE CROSSING PHASE II		
LOWE'S - RIDGE ROAD & HORIZON ROAD		
ROCKWALL, TEXAS		
LAWRENCE A. CATES & ASSOC., INC.		CONSULTING ENGINEERS
14200 MIDWAY ROAD, SUITE 122		DALLAS, TEXAS
DESIGN	DRAWN	DATE
LAC	LAC	7/23/97
SCALE	NOTES	FILE
1" = 60'	D.P.	97036
		WATSEW
		C-13

