


DEVELOPMENT PLANS
FOR
STONE CREEK
PHASE I
CITY OF ROCKWALL, TEXAS

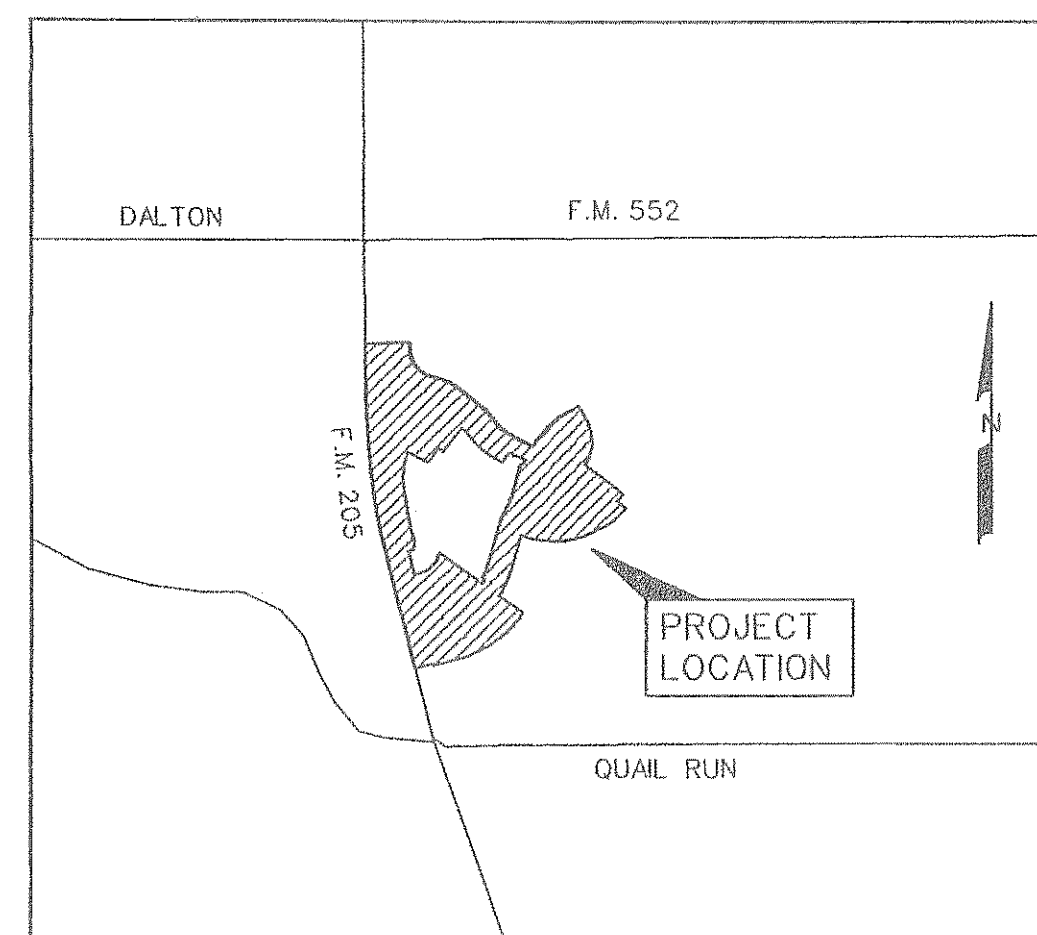

VICINITY MAP
NOT TO SCALE

PREPARED FOR
STONE CREEK SF., LTD.
3838 OAK LAWN AVENUE, SUITE 1212, DALLAS, TEXAS 75219

CORWIN ENGINEERING, INC. — CONSULTING ENGINEERS
200 W. BELMONT, SUITE E ALLEN, TEXAS 75013

NOTE:
CITY OF ROCKWALL STANDARDS
AND NCTCOG 3rd ADDITION STANDARDS
SHALL BE USED FOR REFERENCE.

4	REVISED LAYOUT	DS	5-27-08
3	PER CITY COMMENTS	DS	12-11-07
2	PER CITY COMMENTS	DS	10-26-07
1	PER CITY COMMENTS	DS	8-31-07
NO.	REVISIONS	BY	DATE


INDEX

1	TITLE
2	PLAT
3	PLAT
4	PLAT
5	DRAINAGE AREA MAP
6	DRAINAGE AREA MAP
7	DRAINAGE CALCULATIONS
8	OVERALL DRAINAGE AREA MAP EXISTING CONDITIONS
9	OVERALL DRAINAGE AREA MAP PHASE I- DEVELOPED CONDITIONS
10	AMHERST DRIVE
11	BARLASS DRIVE (STA. 0+00 TO 12+00)
12	BARLASS DRIVE (STA. 12+00 TO 15+38) & RIDGE ROAD
13	BLANK PAGE
14	BLANK PAGE
15	FEATHERSTONE DRIVE (STA 0+00 TO 12+00)
16	FEATHERSTONE DRIVE (STA 12+00 TO 24+00)
17	FEATHERSTONE DRIVE (STA 24+00 TO 31+50)
18	FEATHERSTONE DRIVE (SIDE ROADS *1 & *2)
19	FEATHERSTONE DRIVE (SIDE ROADS *4 & *5)
20	HAINSWORTH DRIVE
21	HANOVER DRIVE
22	HARVARD DRIVE
23	CRESTBROOK DRIVE (STA. 0+00 TO 12+00)
24	CRESTBROOK DRIVE (12+00 TO 13+22) & YORK DRIVE
25	HYER DRIVE
26	CHATFIELD DRIVE
27	BUCKNER DRIVE
28	DEVERSON DRIVE
29	BORDEAUX DRIVE
30	MIRAMAR DRIVE (STA. 0+00 TO 12+00)
31	MIRAMAR DRIVE (STA. 12+00 TO 23+56)
32	GREENWAY DRIVE
33	WATER & SANITARY SEWER PLAN
34	WATER & SANITARY SEWER PLAN
35	WATER & SANITARY SEWER PLAN
35A	12" WATER LINE PROFILE F.M. 205 & BORDEAUX DRIVE
36	SANITARY SEWER PROFILES
37	SANITARY SEWER PROFILES
38	SANITARY SEWER PROFILES
39	SANITARY SEWER PROFILES
40	SANITARY SEWER PROFILES
41	STORM SEWER PLAN AND PROFILE LINES 'D-1'
42	STORM SEWER PLAN AND PROFILE LINE 'D-2'
43	STORM SEWER PLAN AND PROFILE LINES 'D-3'
44	STORM SEWER PLAN AND PROFILE LINE 'D-4'
45	STORM SEWER PLAN AND PROFILE LINES 'D-6'
46	STORM SEWER PLAN AND PROFILE LINE 'D-7' & LAT '7'
47	STORM SEWER PLAN AND PROFILE LINES 'D-9' & 'D-12'
48	STORM SEWER PLAN AND PROFILE LINE 'D-10' & 'D-11'
49	STORM SEWER PLAN AND PROFILE LINES 'D-13' & 'D-14'
50	STORM SEWER PLAN AND PROFILE LINES 'D-15' & 'D-16'
51	STORM SEWER PLAN AND PROFILE LINES 'D-17' & 'D-18'
52	DETENTION POND PLAN NORTH TRIBUTARY POND
53	INTERIM DETENTION POND PLAN NORTH TRIBUTARY POND
54	DETENTION CALCULATIONS
55	INTERIM DETENTION CALCULATIONS
56	DETENTION POND PLAN SOUTH TRIBUTARY UPSTREAM POND
57	GRADING PLAN
58	GRADING PLAN
59	GRADING PLAN
60	GRADING PLAN
61	POLLUTION PREVENTION PLAN
62	STATE HIGHWAY - 205 STRIPING PLAN

STATE DETAILS

TO THE BEST OF OUR KNOWLEDGE CORWIN ENGINEERING, INC., HEREBY STATES THAT THIS PLAN IS AS-BUILT, THIS INFORMATION PROVIDED IS BASED ON SURVEYING AT THE SITE AND INFORMATION PROVIDED BY THE CONTRACTORS.

AS-BUILT DECEMBER 2008

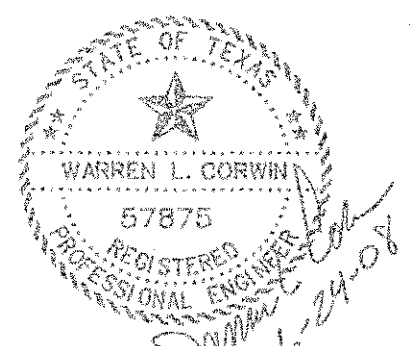

The seal appearing on this document was authorized by Warren L. Corwin, P.E. 57875, on JUNE 13, 2008

STONE CREEK PHASE I
08053