




AS-BUILT DECEMBER 2008  
 TO THE BEST OF OUR KNOWLEDGE CORWIN  
 ENGINEERING, INC. HEREBY STATES THAT THIS PLAN IS  
 AS-BUILT, THIS INFORMATION PROVIDED IS BASED ON  
 SURVEYING AT THE SITE AND INFORMATION PROVIDED  
 BY THE CONTRACTORS.

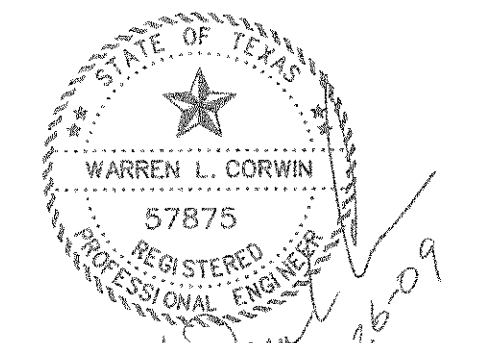

The seal appearing on  
 this document was  
 authorized by  
 Warren L. Corwin,  
 P.E. 57875, on  
 January 26, 2009

- LEGEND**
- PROP. STORM SEWER
  - PROP. CURB INLETS
  - PROP. CONC. HEADWALL
  - EXIST. STORM SEWER
  - DRAINAGE AREA DIVIDE
  - FLOW ARROW
  - DRAINAGE AREA NO.

<b>CORWIN ENGINEERING, INC.</b> 200 W. BELMONT, SUITE E ALLEN, TEXAS 75013 (972) 396-1200 TBP# FIRM #5957			
DEVELOPMENT PLANS FOR <b>STONE CREEK PHASE I</b> ROCKWALL, TEXAS			
DRAINAGE AREA MAP			
DRAWN BY	DESIGNED BY	CHECKED BY	SHEET NO.
	CEI	CEI	
JOB NUMBER	DATE	SCALE	
08033	JANUARY 2008	1"=100'	6 OF 62